

ENGINEER'S CERTIFICATION

I, **DARRYL HAYTER**
 being a Consulting Engineer and duly authorised representative of: -
EMPOWER ENGINEERS AND PROJECT MANAGERS
 hereby:-
 # certify the information contained in this drawing is an accurate "as constructed" representation of the works currently in progress however may not present all final information;
 # accept responsibility for the "as constructed" information contained in this drawing; and
 # acknowledge the "as constructed" information contained in the drawing may be relied on by the Moreton Bay Regional Council and others.
 Certification for Stage 14 by *D.H.* on 22/08/17
 For: **EMPOWER ENGINEERS AND PROJECT MANAGERS** 5694 5694

REGISTERED SURVEYOR'S CERTIFICATION
 We, Queensland Surveying Pty Ltd (ACN 604 671 374) Cadastral Surveyors, hereby certify that the vertical and horizontal locations and dimensions shown on this plan are a true and correct record and were located by survey.
D.H. 6152 9/8/2017
 Delegate (signature) Registration ID Date

- LEGEND**
- New Hydrant
 - New Isolation Valve
 - New End Cap
 - New Scour Valve
 - New Taper
 - New Water Service Conduit (Ø100 uPVC PN9)
 - New Water Meter
 - New Water House connection

NOTES:
 • All mains DN150 PVC-O PN16 unless noted otherwise.

DRAWING REVISIONS		REFERENCE DRAWINGS		DESIGN FILE No.	DESIGNED
REV.	REVISION DESCRIPTION	DRG. No.	DESCRIPTION	CONSTRUCT. No.	DATE
A	Progress Plot				
B	Update				
C	Update				

FIELD BOOK	LOG BOOK	LEVEL DATUM	DATUM
		AHD	PM177891

THIS WORK WAS PREPARED BY:
QUEENSLAND SURVEYING PTY LTD

SCALE 1:500 ORIGINAL SIZE A1




MORETON BAY REGIONAL COUNCIL
 CABOOLTURE DISTRICT OFFICE
 2 HASKING STREET CABOOLTURE QLD 4510
 PO BOX 159 CABOOLTURE QLD 4510
 Telephone: (07) 5433 0100
 Fax: (07) 5433 4000

STAGE 14, CAPESTONE AS CONSTRUCTED WATER RETICULATION		MBRC SUBDIVISION REFERENCE	
		DA/31223/2016/V23R	
		No. 1 OF 2 PLANS	
DRAWING NUMBER	REV.		
30105-140100 AW	C		



ENGINEER'S CERTIFICATION
 I, DARRYL HAYTER
 being a Consulting Engineer and duly authorised representative of: -
EMPOWER ENGINEERS AND PROJECT MANAGERS
 hereby:-
 # certify the information contained in this drawing is an accurate "as constructed" representation of the works currently in progress however may not present all final information;
 # accept responsibility for the "as constructed" information contained in this drawing; and
 # acknowledge the "as constructed" information contained in the drawing may be relied on by the Moreton Bay Regional Council and others.
 Certification for Stage 14 by D.H. on 22/08/17
 For: EMPOWER ENGINEERS AND PROJECT MANAGERS 5694 5694

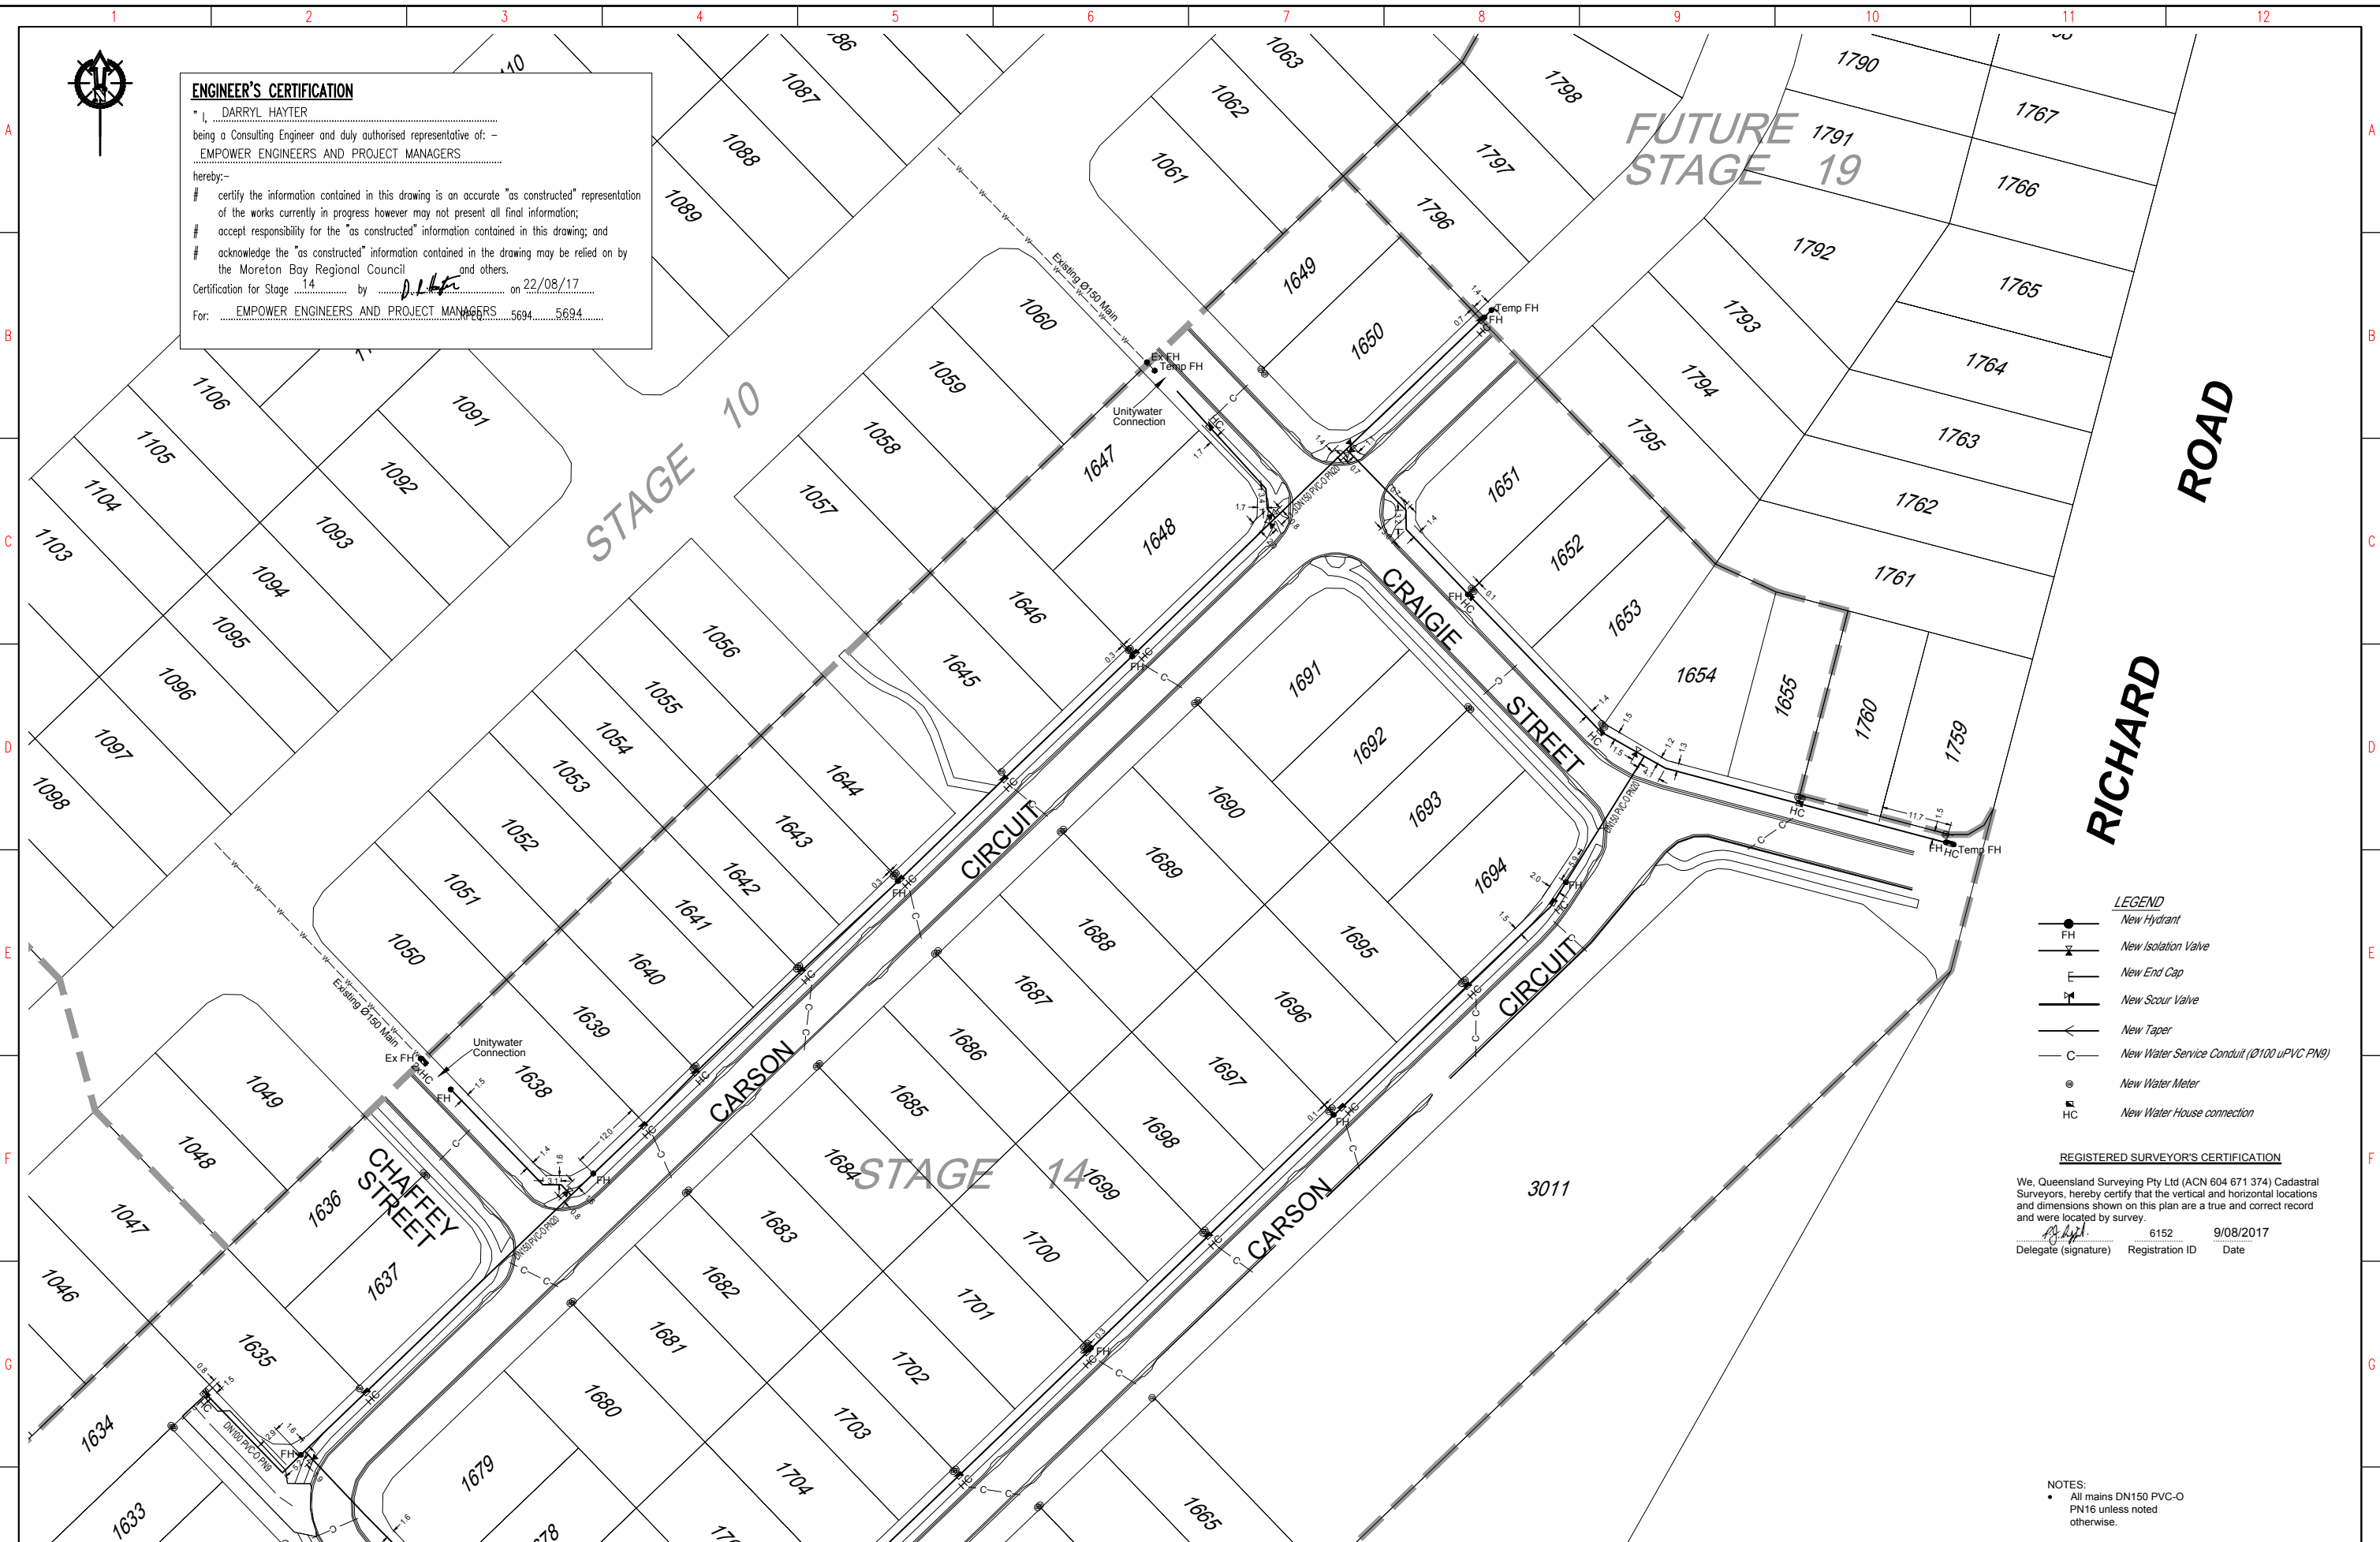

- LEGEND**
- New Hydrant
 - New Isolation Valve
 - New End Cap
 - New Scour Valve
 - New Taper
 - New Water Service Conduit (Ø100 uPVC PN9)
 - New Water Meter
 - New Water House connection

REGISTERED SURVEYOR'S CERTIFICATION
 We, Queensland Surveying Pty Ltd (ACN 604 671 374) Cadastral Surveyors, hereby certify that the vertical and horizontal locations and dimensions shown on this plan are a true and correct record and were located by survey.
 Delegate (signature) [Signature] 6152 9/08/2017
 Registration ID Date

NOTES:
 • All mains DN150 PVC-O PN16 unless noted otherwise.

DRAWING REVISIONS		REFERENCE DRAWINGS		DESIGN FILE No.	DESIGNED
REV.	REVISION DESCRIPTION	DRG. No.	DESCRIPTION	CONSTRUCT. No.	DATE
A	Progress Plot				
B	Update				
C	Update				

FIELD BOOK	DATE	9/8/17
LOG BOOK	CHECKED	EJM
LEVEL DATUM	AHD	DATE
DATUM	PM177891	9/8/17

THIS WORK WAS PREPARED BY:
QUEENSLAND SURVEYING PTY LTD
 SCALE 1:500 ORIGINAL SIZE A1

MORETON BAY REGIONAL COUNCIL
 CABOOLTURE DISTRICT OFFICE
 2 HASKING STREET CABOOLTURE QLD 4510
 PO BOX 159 CABOOLTURE QLD 4510
 Telephone: (07) 5433 0100
 Fax: (07) 5433 4000

STAGE 14, CAPESTONE AS CONSTRUCTED WATER RETICULATION

MBRC SUBDIVISION REFERENCE	
DA/31223/2016/V23R	
No. 2 OF 2 PLANS	
DRAWING NUMBER	REV.
30105-140100 AW	C