



I, Peter Sippel, being a cadastral surveyor and duly authorised representative of THG WSG Pty Ltd hereby:

- certify the information contained in this drawing is an accurate as constructed representation of the works
- accept responsibility for the as constructed information contained in this drawing
- acknowledge the as constructed information contained in the drawing may be relied on by council and others

Certification of Stage 5  
 by *P. Sippel* on 13/2/15  
 (Signature) (Date)

for THG WSG Pty Ltd

**STAGE 4**

**FUTURE STAGE 6**

**STAGE 5**


**ENGINEER'S CERTIFICATION**


I, David Polden, being a Consulting Engineer and duly authorised representative of: - BMD Consulting hereby:

- certify the information contained in this drawing is an accurate "as constructed" representation of the works;
- accept responsibility for the "as constructed" information contained in this drawing; and
- acknowledge the "as constructed" information contained in the drawing may be relied on by the Moreton Bay Regional Council and others.

Certification of Stage 5 by *David Polden* on 13.02.15

For: BMD CONSULTING Pty. Ltd. RPEQ 1907

DRAWING REVISIONS		REFERENCE DRAWINGS		DESIGN FILE No.	DESIGNED	THIS WORK WAS PREPARED BY:		 <b>MORETON BAY REGIONAL COUNCIL</b> CABOOLTURE DISTRICT OFFICE 2 HASKING STREET CABOOLTURE QLD 4510 PO BOX 150 CABOOLTURE QLD 4510 Telephone: (07) 5433 0100 Fax: (07) 5433 4000	MBRC SUBDIVISION REFERENCE	
REV.	REVISION DESCRIPTION	DRG. No.	DESCRIPTION	CONSTRUCT. No.	DATE	THG WSG PTY LTD			DA/28463/2013/V23R	REV.
A	Preliminary			SURVEY FILE No. 247405_9 AS	DATE	SCALE 1:500 ORIGINAL SIZE A1		<b>STAGE 5, CAPESTONE AS CONSTRUCTED SEWER RETICULATION</b>	No. 1 OF 2 PLANS	
B	Original			FIELD BOOK	DATE		ASCON GRID NUMBER		46188	
C	Update			LOG BOOK	CHECKED					
D	Add 2 HCs			LEVEL DATUM	DATE					

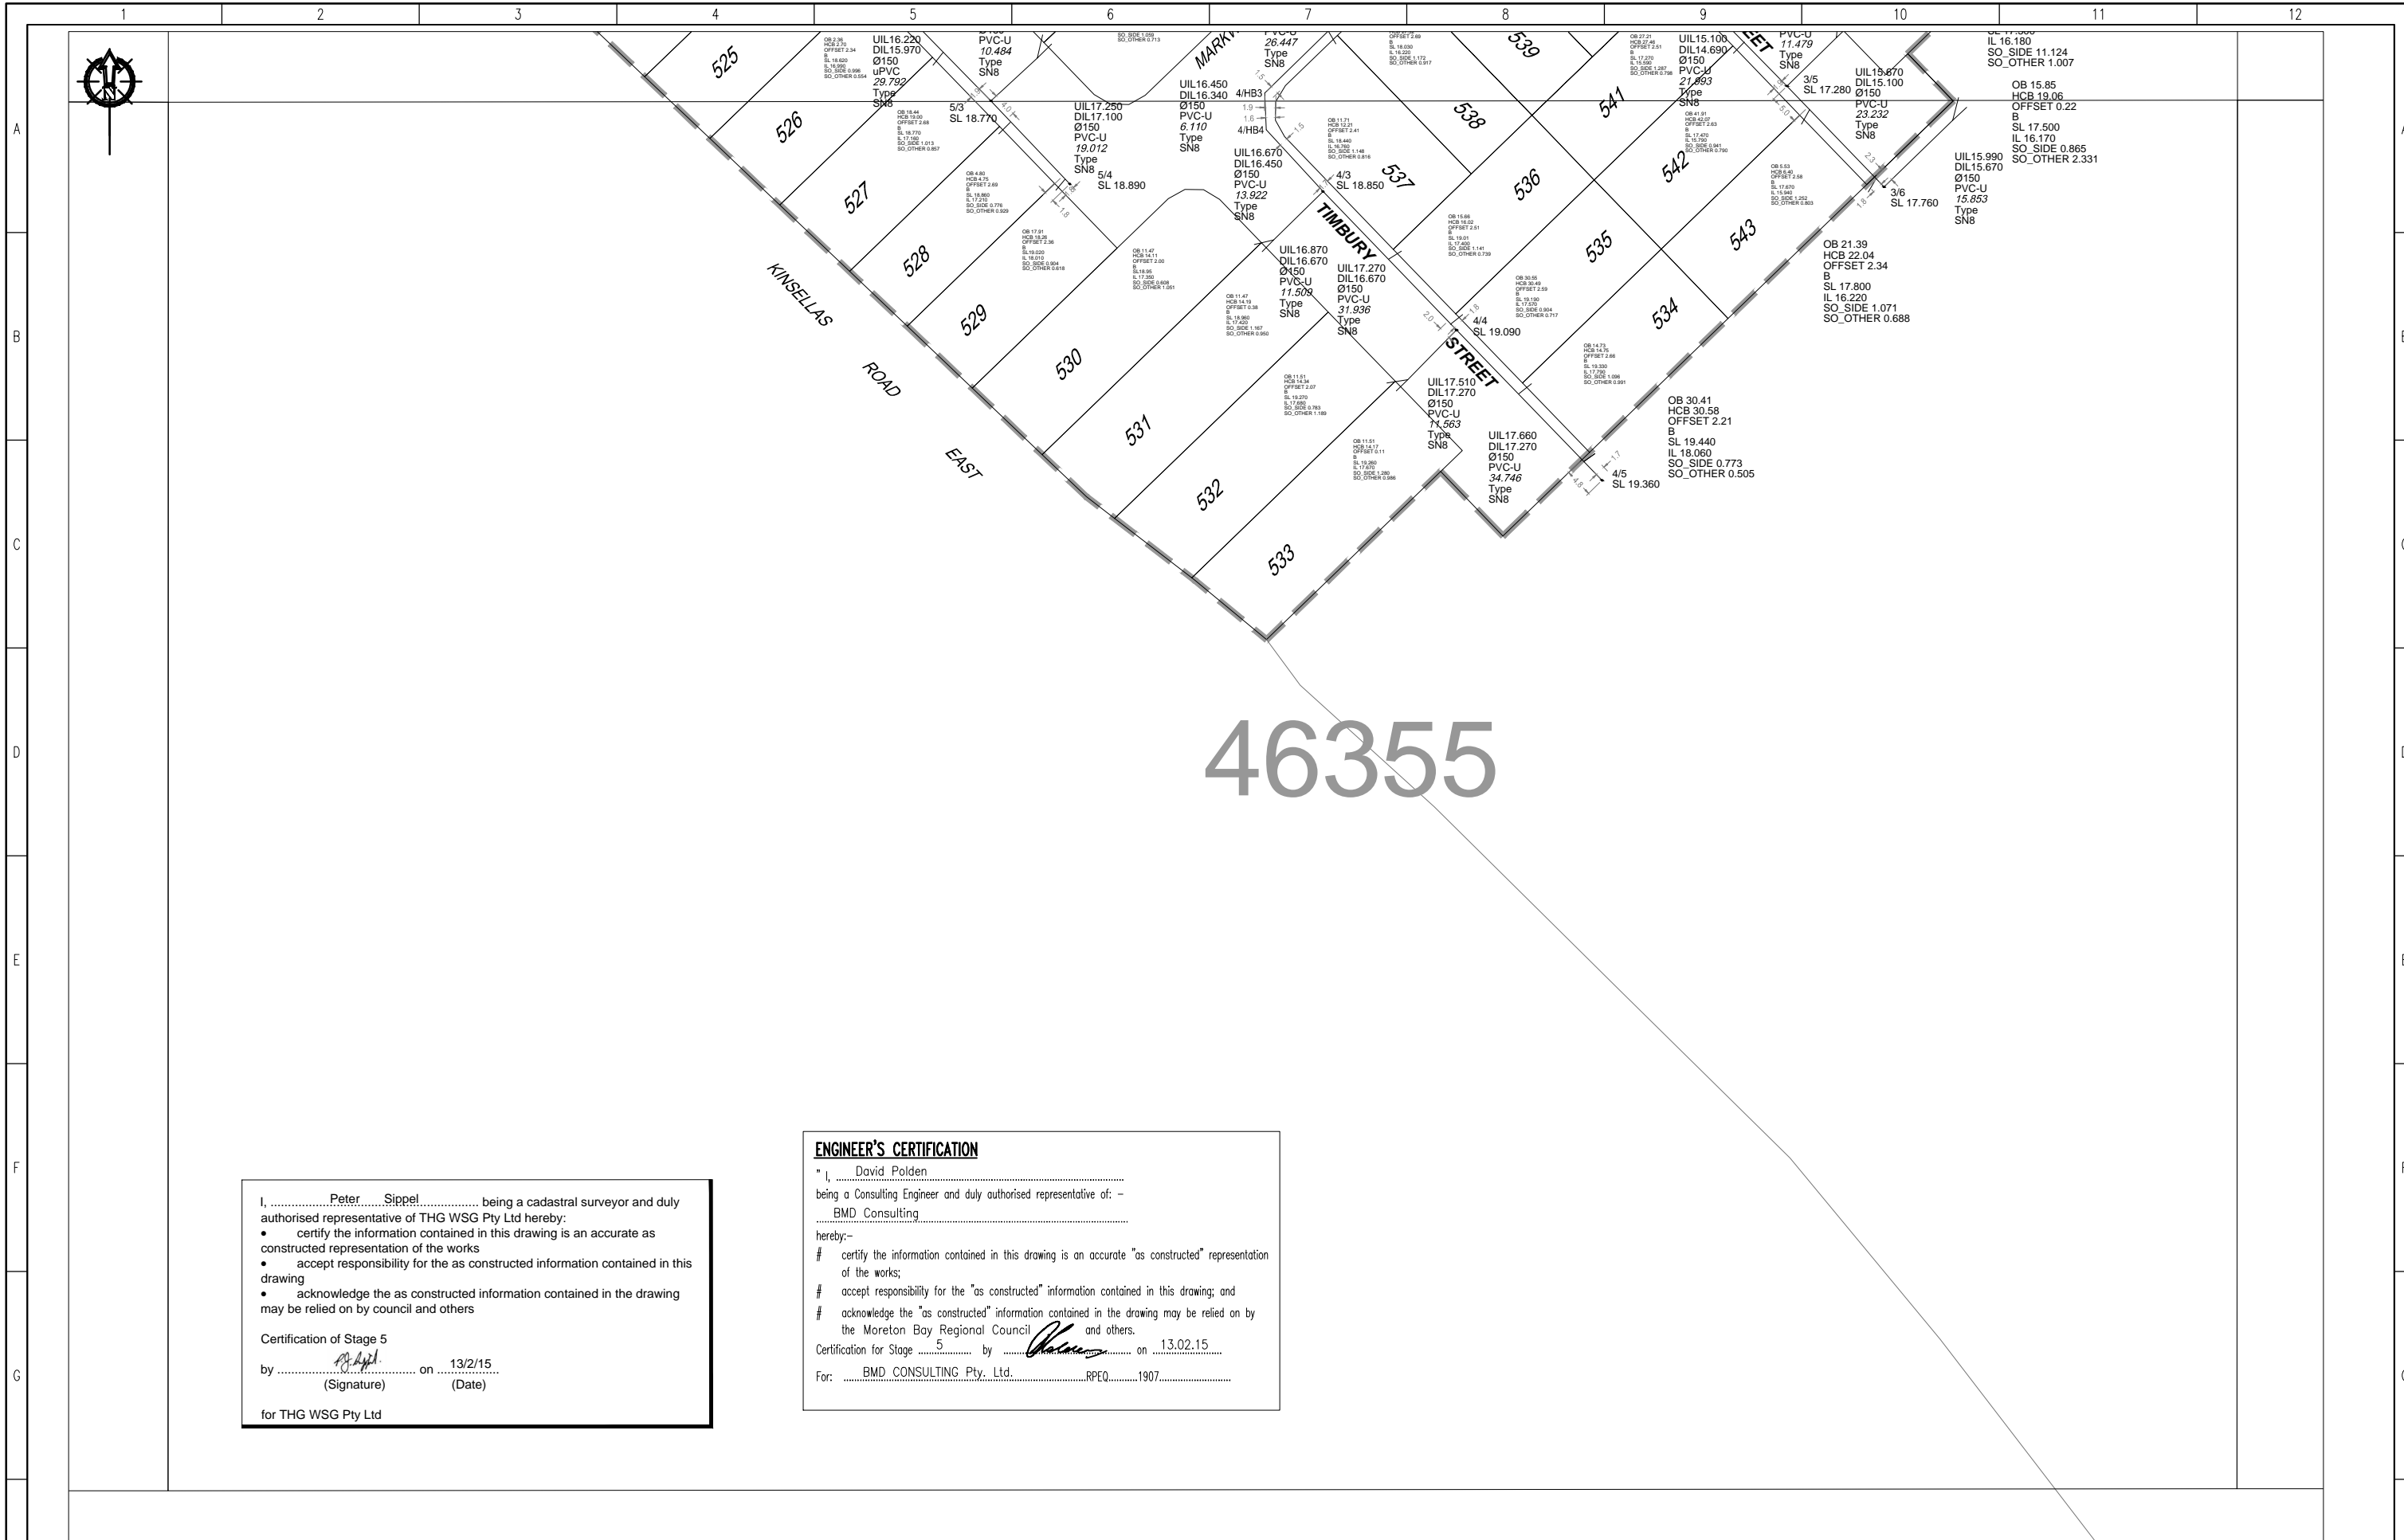

I, Peter Sippel being a cadastral surveyor and duly authorised representative of THG WSG Pty Ltd hereby:

- certify the information contained in this drawing is an accurate as constructed representation of the works
- accept responsibility for the as constructed information contained in this drawing
- acknowledge the as constructed information contained in the drawing may be relied on by council and others

Certification of Stage 5  
 by P. Sippel on 13/2/15  
 (Signature) (Date)

for THG WSG Pty Ltd

**ENGINEER'S CERTIFICATION**

I, David Polden  
 being a Consulting Engineer and duly authorised representative of: -  
BMD Consulting

hereby:-

- certify the information contained in this drawing is an accurate "as constructed" representation of the works;
- accept responsibility for the "as constructed" information contained in this drawing; and
- acknowledge the "as constructed" information contained in the drawing may be relied on by the Moreton Bay Regional Council and others.

Certification for Stage 5 by [Signature] on 13.02.15  
 For: BMD CONSULTING Pty. Ltd. RPEQ 1907

DRAWING REVISIONS		REFERENCE DRAWINGS		DESIGN FILE No.	DESIGNED
REV.	REVISION DESCRIPTION	DRG. No.	DESCRIPTION	CONSTRUCT. No.	DATE
A	Preliminary			SURVEY FILE No. 247405_9 AS	DRAWN EJM
B	Original			FIELD BOOK	DATE 13/2/15
C	Update			LOG BOOK	CHECKED EJM
D	Add 2 HCs			LEVEL DATUM AHD	DATE 13/2/15
				DATUM PM177891	

**THIS WORK WAS PREPARED BY:  
 THG WSG PTY LTD**

SCALE 1:500 ORIGINAL SIZE A1



**MORETON BAY REGIONAL COUNCIL**  
 CABOOLTURE DISTRICT OFFICE  
 2 HASKING STREET CABOOLTURE QLD 4510  
 PO BOX 150 CABOOLTURE QLD 4510  
 Telephone: (07) 5433 0100  
 Fax: (07) 5433 4000

**STAGE 5, CAPESTONE  
 AS CONSTRUCTED  
 SEWER RETICULATION**

MBRC SUBDIVISION REFERENCE	
DA/28463/2013/V23R	
No. 2 OF 2 PLANS	
ASCAN GRID NUMBER	REV.
46355	D