

**REGISTERED SURVEYOR'S CERTIFICATION**

We, Queensland Surveying Pty Ltd (ACN 604 671 374) Cadastral Surveyors, hereby certify that the vertical and horizontal locations and dimensions shown on this plan are a true and correct record and were located by survey.

Delegated (signature) *[Signature]* 6152 7/07/2017  
 Registration ID Date

**ENGINEER'S CERTIFICATION**

I, DARRYL HAYTER  
 being a Consulting Engineer and duly authorised representative of: -  
 BMD Consulting  
 hereby:-  
 # certify the information contained in this drawing is an accurate "as constructed" representation of the works;  
 # accept responsibility for the "as constructed" information contained in this drawing; and  
 # acknowledge the "as constructed" information contained in the drawing may be relied on by the Moreton Bay Regional Council and others.  
 Certification for Stage 16 on 31/07/17  
 For: BMD CONSULTING Pty. Ltd. RPED: 5694

DRAWING REVISIONS		REFERENCE DRAWINGS		DESIGN FILE No.	DESIGNED
REV.	REVISION DESCRIPTION	DRG. No.	DESCRIPTION	CONSTRUCT. No.	DATE
A	Progress Plot			SURVEY FILE No. 30105-160100 AD	DRAWN EJM 7/07/2017
B	Update			FIELD BOOK	CHECKED EJM 7/07/2017
				LOG BOOK	DATE 7/07/2017
				LEVEL DATUM	
				AHD	
				PM177891	

**THIS WORK WAS PREPARED BY:  
 QUEENSLAND SURVEYING PTY LTD**




**MORETON BAY REGIONAL COUNCIL**  
 CABOOLTURE DISTRICT OFFICE  
 2 HASKING STREET CABOOLTURE QLD 4510  
 Telephone: (07) 5433 0100  
 Fax: (07) 5433 4000

**STAGE 16, CAPESTONE  
 AS CONSTRUCTED  
 DRAINAGE**

SCALE 1:500 ORIGINAL SIZE A1

MBRC SUBDIVISION REFERENCE	
DA/31730/2016/V23R	
No. 1 OF 2 PLANS	
DRAWING NUMBER	REV.
30105-160100 AD	B

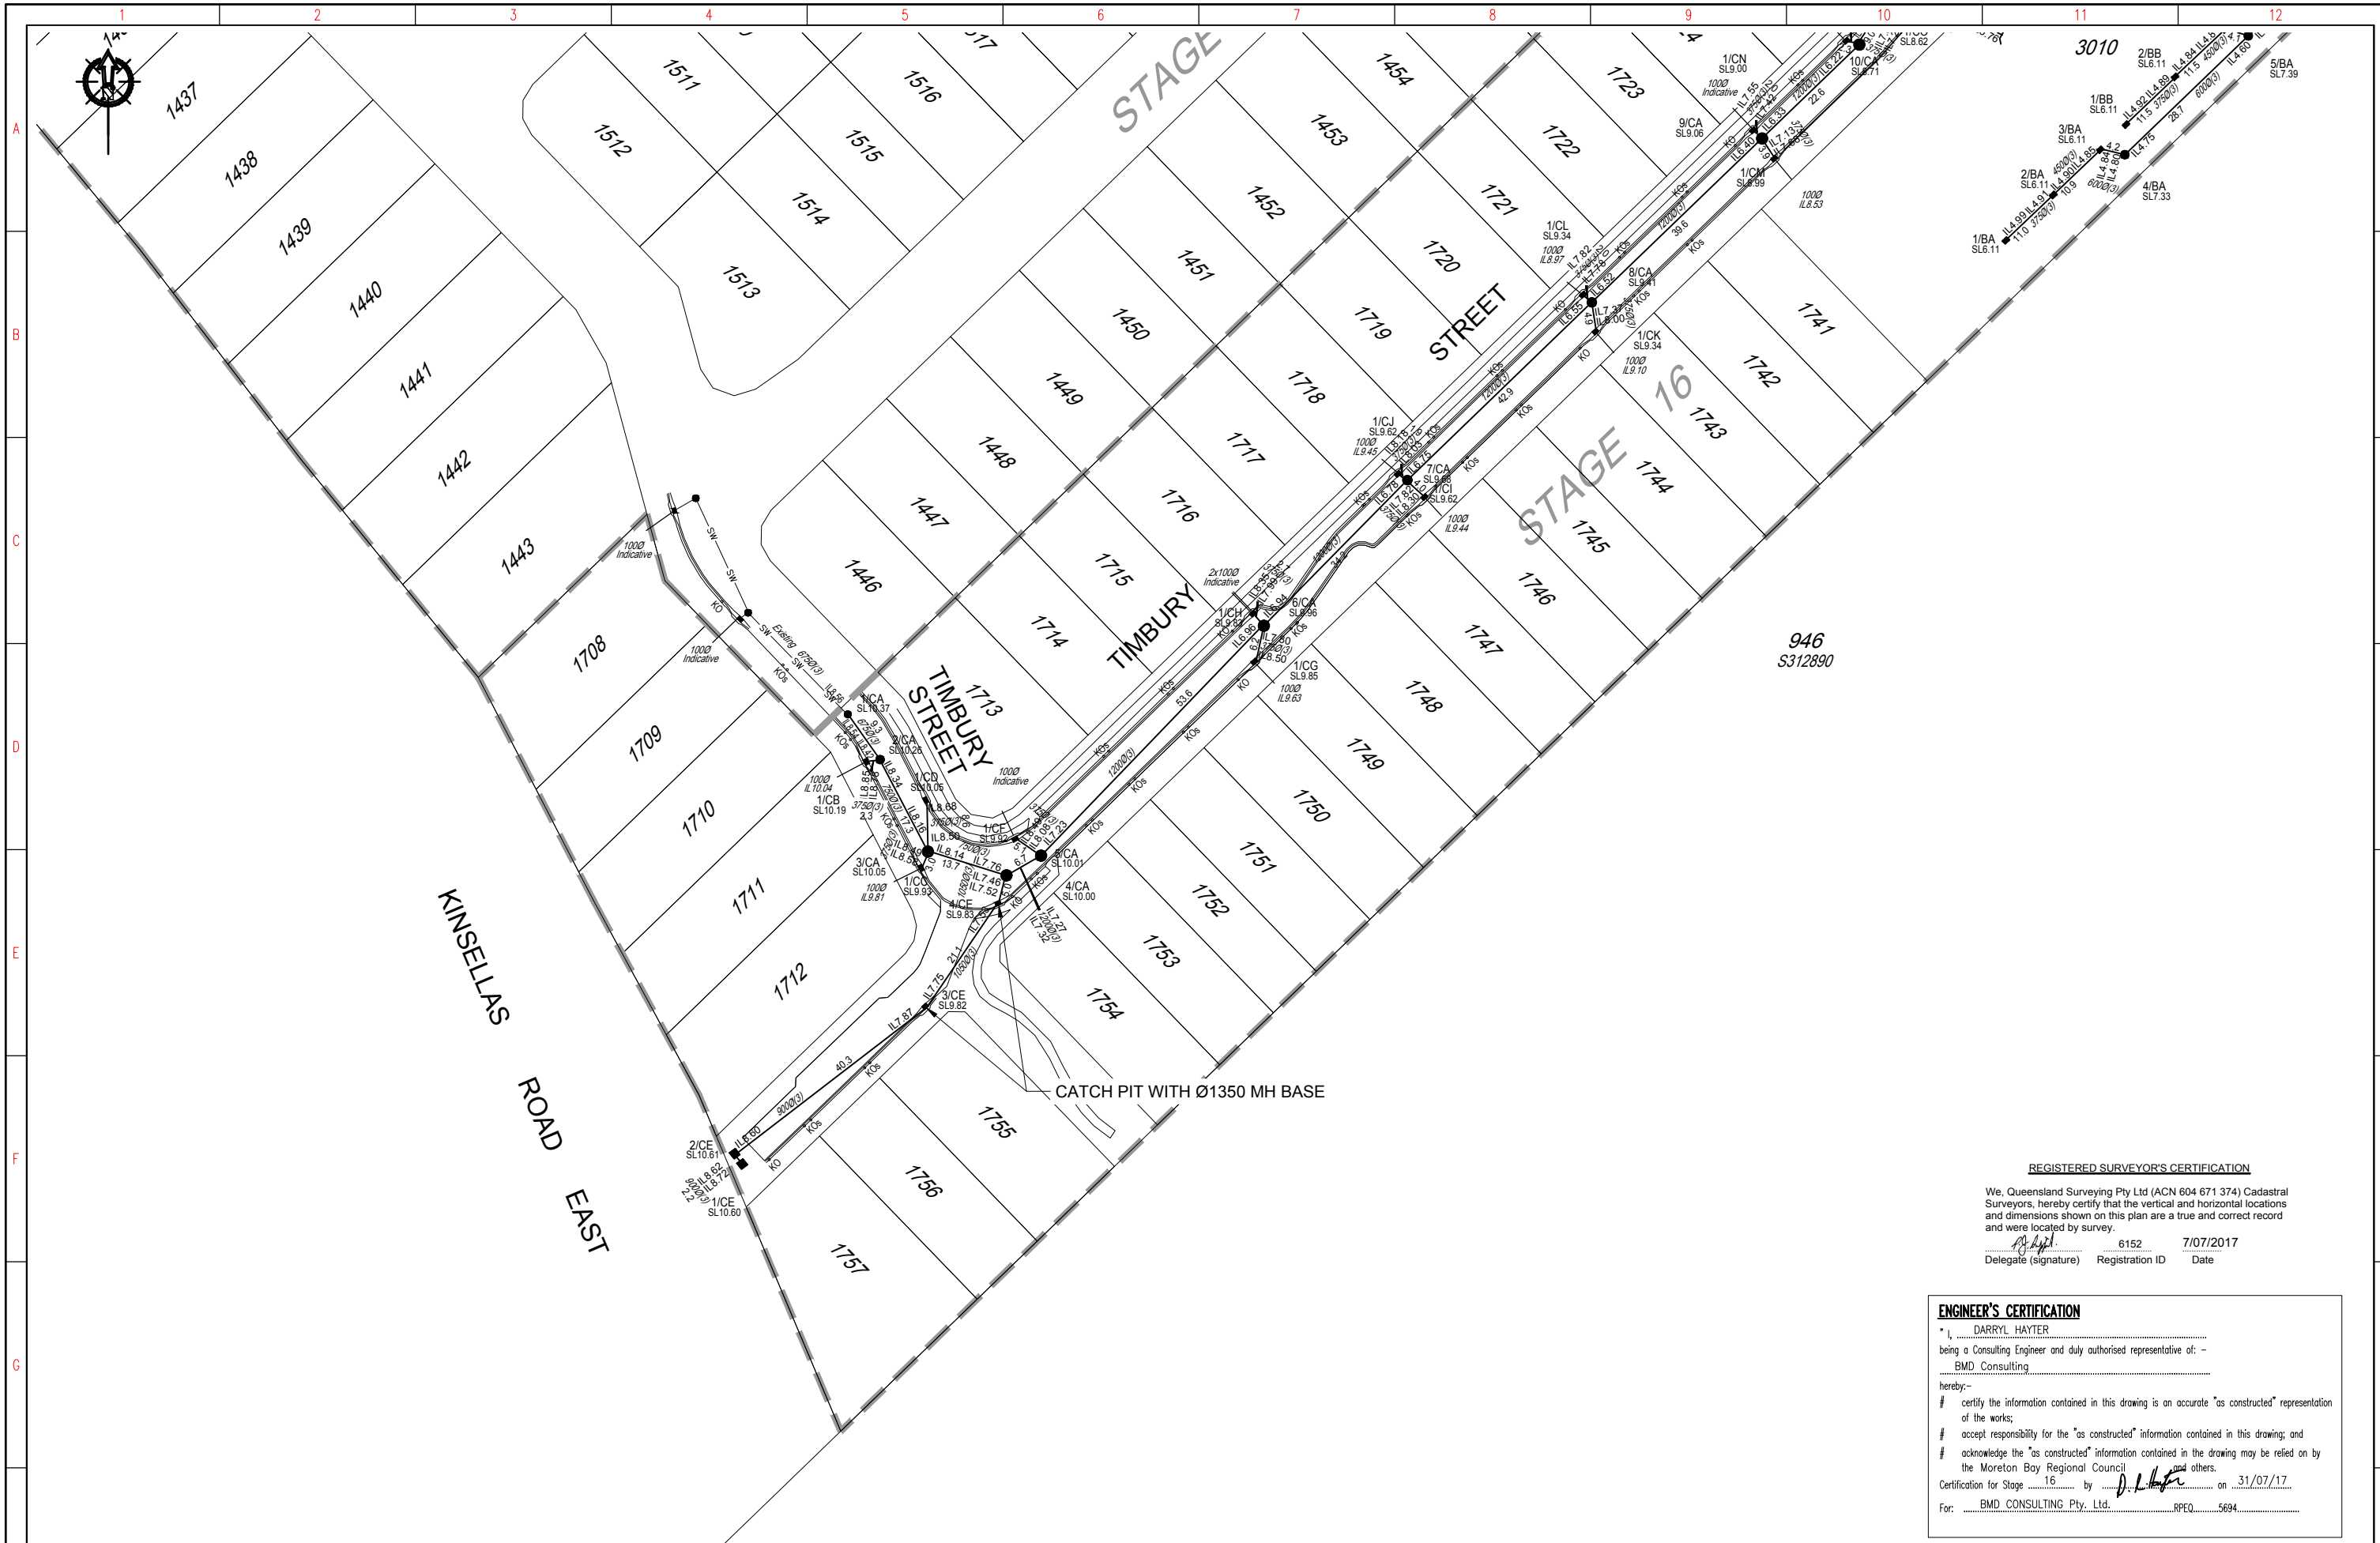

**REGISTERED SURVEYOR'S CERTIFICATION**  
 We, Queensland Surveying Pty Ltd (ACN 604 671 374) Cadastral Surveyors, hereby certify that the vertical and horizontal locations and dimensions shown on this plan are a true and correct record and were located by survey.  
 Delegate (signature) *[Signature]* 6152 7/07/2017  
 Registration ID Date


**ENGINEER'S CERTIFICATION**  
 I, DARRYL HAYTER  
 being a Consulting Engineer and duly authorised representative of: -  
 BMD Consulting  
 hereby:-  
 # certify the information contained in this drawing is an accurate "as constructed" representation of the works;  
 # accept responsibility for the "as constructed" information contained in this drawing; and  
 # acknowledge the "as constructed" information contained in the drawing may be relied on by the Moreton Bay Regional Council and others.  
 Certification for Stage 16 by *[Signature]* on 31/07/17  
 For: BMD CONSULTING Pty. Ltd. RPEO 5694

DRAWING REVISIONS		REFERENCE DRAWINGS		DESIGN FILE No.	DESIGNED
REV.	REVISION DESCRIPTION	DRG. No.	DESCRIPTION	CONSTRUCT. No.	DATE
A	Progress Plot				
B	Update				

DESIGNED	DATE	CHECKED	DATE
EJM	7/07/2017	EJM	7/07/2017

**THIS WORK WAS PREPARED BY:**  
**QUEENSLAND SURVEYING PTY LTD**  
 SCALE 1:500 ORIGINAL SIZE A1



**MORETON BAY REGIONAL COUNCIL**  
 CABOOLTURE DISTRICT OFFICE  
 2 HASKING STREET CABOOLTURE QLD 4510  
 Telephone: (07) 5433 0100  
 Fax: (07) 5433 4000

**STAGE 16, CAPESTONE AS CONSTRUCTED DRAINAGE**

MBRC SUBDIVISION REFERENCE  
 DA/31730/2016/V23R  
 No. 2 OF 2 PLANS  
 DRAWING NUMBER REV.  
 30105-160100 AD B