



I, Peter Sippel, being a cadastral surveyor and duly authorised representative of THG WSG Pty Ltd hereby:

- certify the information contained in this drawing is an accurate as constructed representation of the works
- accept responsibility for the as constructed information contained in this drawing
- acknowledge the as constructed information contained in the drawing may be relied on by council and others

Certification of Capestone Boulevard Section A

by *P. Sippel* on 19/11/14
(Signature) (Date)

for THG WSG Pty Ltd


ENGINEER'S CERTIFICATION

I, David Polden, being a Consulting Engineer and duly authorised representative of: - BMD Consulting hereby:-

- certify the information contained in this drawing is an accurate "as constructed" representation of the works;
- accept responsibility for the "as constructed" information contained in this drawing; and
- acknowledge the "as constructed" information contained in the drawing may be relied on by the Moreton Bay Regional Council and others.

Certification for Stage 4 by *D. Polden* on 25.11.14

For: BMD CONSULTING Pty. Ltd. RPEQ 1907

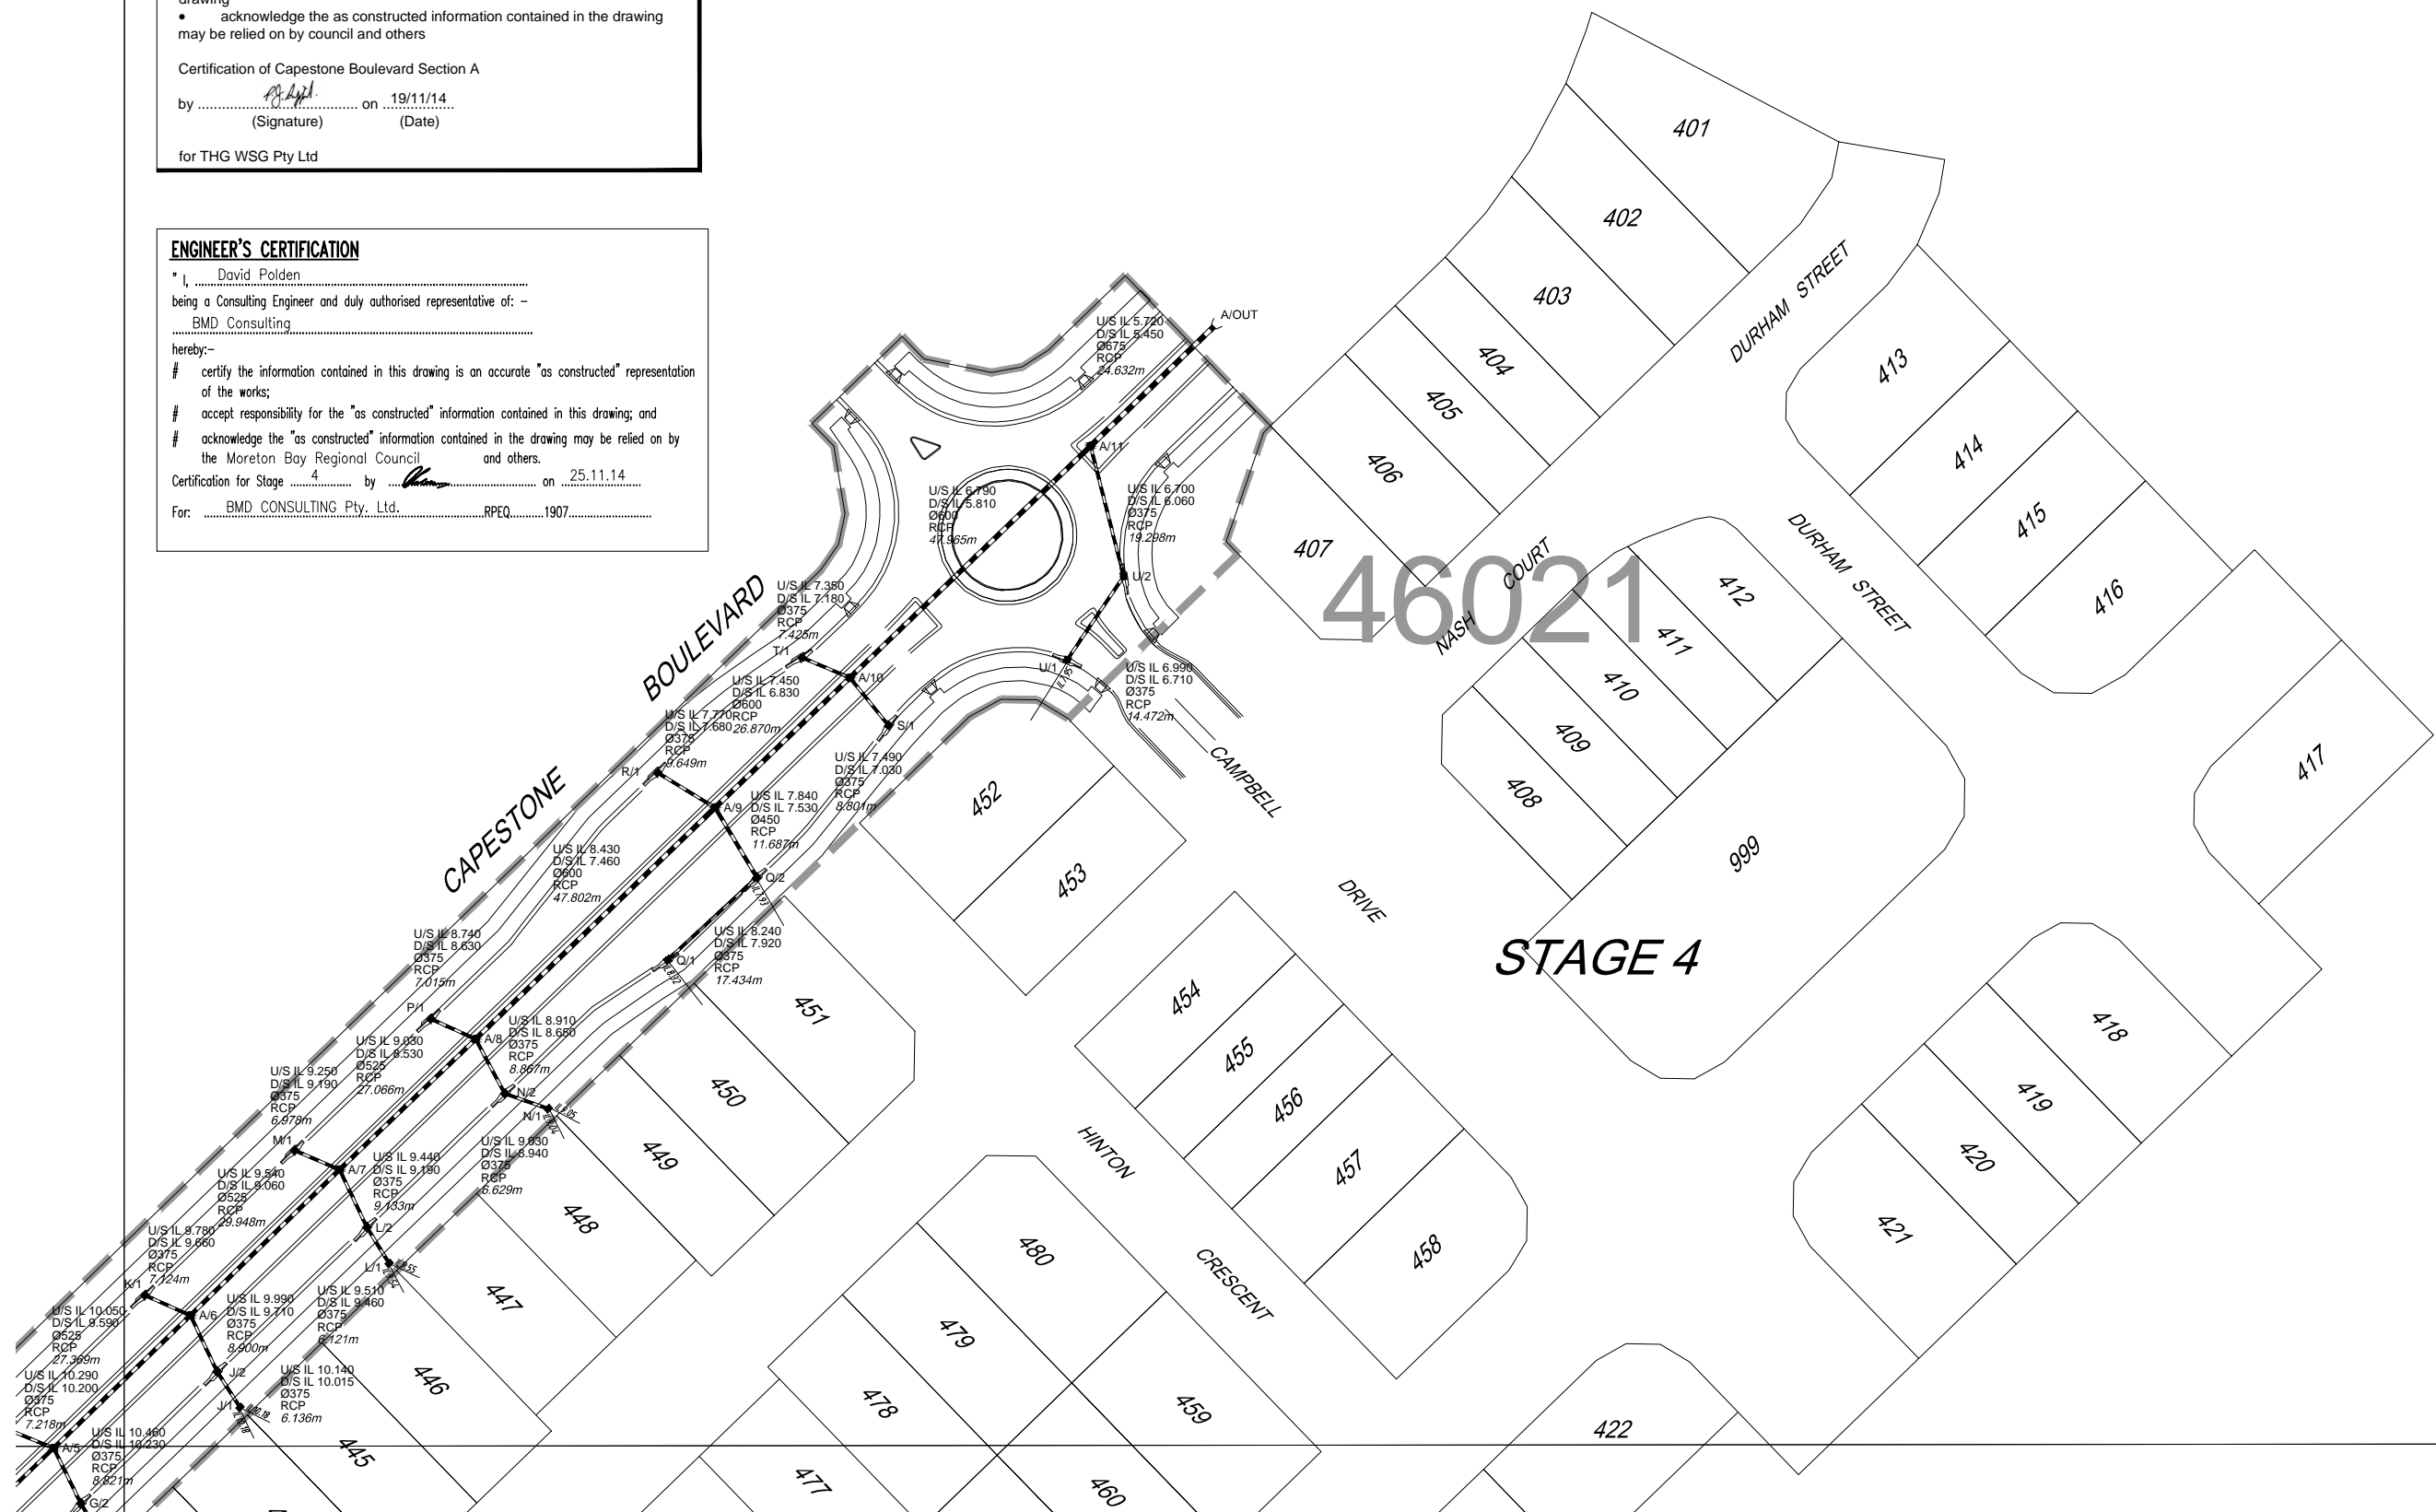

46021

STAGE 4

REV.	REVISION DESCRIPTION
A	Original
B	Update

DESIGN FILE No.	CONSTRUCT. No.
247404_10 ARO	

DESIGNED	DATE
EJM	19/11/14
EJM	19/11/14

THIS WORK WAS PREPARED BY:
THG WSG PTY LTD

SCALE 1:500 ORIGINAL SIZE A1



MORETON BAY REGIONAL COUNCIL
CABOOLTURE DISTRICT OFFICE
2 HASKING STREET CABOOLTURE QLD 4510
PO BOX 159 CABOOLTURE QLD 4510
Telephone: (07) 5433 0100
Fax: (07) 5433 4000

CAPESTONE BOULEVARD SECTION A
AS CONSTRUCTED
ROADS AND DRAINAGE

MBC SUBDIVISION REFERENCE	
DA/27987/2013/V23R	
No. 2 OF 3 PLANS	REV.
ASCEN GRID NUMBER	46021
	B



I, Peter Sippel being a cadastral surveyor and duly authorised representative of THG WSG Pty Ltd hereby:

- certify the information contained in this drawing is an accurate as constructed representation of the works
- accept responsibility for the as constructed information contained in this drawing
- acknowledge the as constructed information contained in the drawing may be relied on by council and others

Certification of Capestone Boulevard Section A

by P. Sippel on 19/11/14
(Signature) (Date)

for THG WSG Pty Ltd

ENGINEER'S CERTIFICATION


* I, David Polden being a Consulting Engineer and duly authorised representative of: - BMD Consulting hereby:-

- # certify the information contained in this drawing is an accurate "as constructed" representation of the works;
- # accept responsibility for the "as constructed" information contained in this drawing; and
- # acknowledge the "as constructed" information contained in the drawing may be relied on by the Moreton Bay Regional Council and others.

Certification for Stage 4 by [Signature] on 25.11.14

For: BMD CONSULTING Pty. Ltd. RPEQ 1907

46187

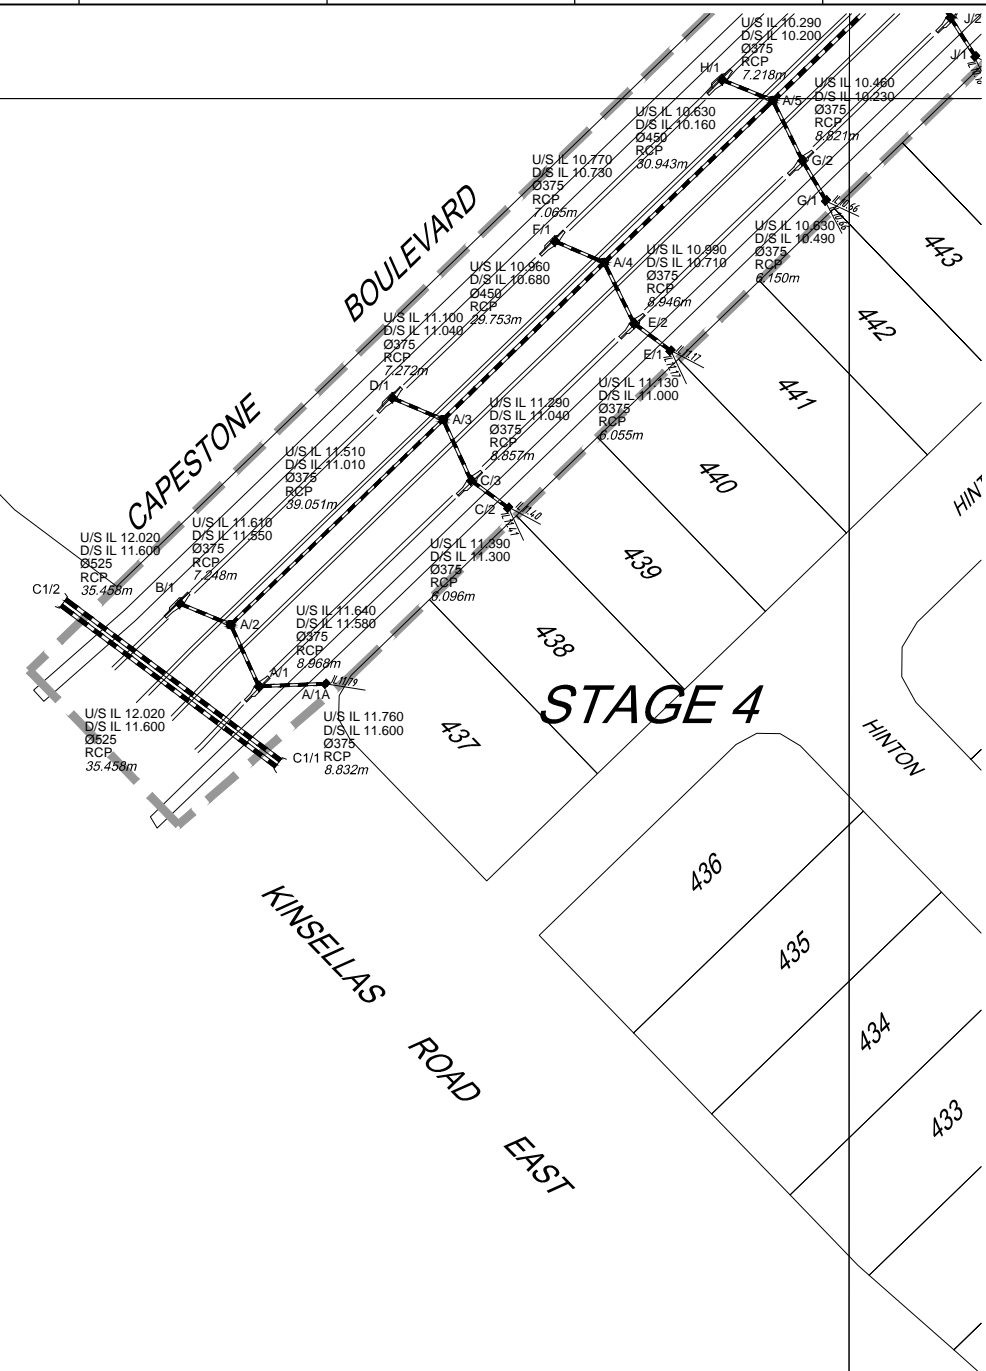

DRAWING REVISIONS		REFERENCE DRAWINGS		DESIGN FILE No.	DESIGNED
REV.	REVISION DESCRIPTION	DRG. No.	DESCRIPTION	CONSTRUCT. No.	DATE
A	Original			SURVEY FILE No. 247404_10 ARO	DRAWN EJM
B	Update			FIELD BOOK	DATE 19/11/14
				LOG BOOK	CHECKED EJM
				LEVEL DATUM	DATE 19/11/14
				DATUM	AHD PM177891

**THIS WORK WAS PREPARED BY:
THG WSG PTY LTD**



MORETON BAY REGIONAL COUNCIL
CABOOLTURE DISTRICT OFFICE
2 HASKING STREET CABOOLTURE QLD 4510
PO BOX 159 CABOOLTURE QLD 4510
Telephone: (07) 5433 0100
Fax: (07) 5433 4000

**CAPESTONE BOULEVARD SECTION A
AS CONSTRUCTED
ROADS AND DRAINAGE**

MBRC SUBDIVISION REFERENCE	
DA/27987/2013/V23R	
No. 3 OF 3 PLANS	
ASCEN GRID NUMBER	REV.
46187	B

SCALE 1:500 ORIGINAL SIZE A1