


45353

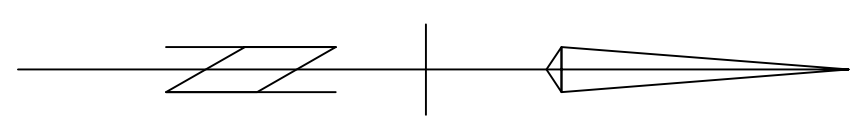


ENGINEER'S CERTIFICATION

"I, being a Consulting Engineer and duly authorised representative of: -
 URBEX Pty. Ltd.
 hereby:-
 # certify the information contained in this drawing is an accurate "as constructed" representation of the works;
 # accept responsibility for the "as constructed" information contained in this drawing; and
 # acknowledge the "as constructed" information contained in the drawing may be relied on by the Pine Rivers Shire Council and others.
 Certification for Stage 1 & 3 by on
 For: BMD CONSULTING ENGINEERS Pty. Ltd.

SURVEYOR'S CERTIFICATION

"I, Brion Collins
 being a Registered Surveying Associate and duly authorised representative of: -
 BMD CONSTRUCTIONS PTY. LTD.
 hereby:-
 # certify the information contained in this drawing is an accurate "as constructed" representation of the works;
 # accept responsibility for the "as constructed" information contained in this drawing; and
 # acknowledge the "as constructed" information contained in the drawing may be relied on by the Pine Rivers Shire Council and others.
 Certification for Stage 1 & 3 by on May 2012
 For: Brion Collins Eng Surv.

DRAWING REVISIONS		REFERENCE DRAWINGS		DESIGNED		THIS WORK WAS PREPARED BY:		AS CONSTRUCTED SEWER		CSC SUBMISSION REFERENCE		
REV.	DESCRIPTION	DRG. NO.	DESCRIPTION	CONSTRUCT. NO.	DATE	DATE	SUNSTATE ENGINEERING SURVEYS UNIT 2/44 Stone St. Constat. Qld. 4019 Telephone: (07) 3288 7813 Fax: (07) 3288 7883	CAPESTONE STAGES 1 & 3		DA 2055/10548		
A	PRELIMINARY AS CONSTRUCTED			SURVEY FILE NO.	DATE					No. 2 OF 5 PLANS		
				FIELD BOOK	DATE	MORETON BAY REGIONAL COUNCIL CAROLITHE STREET OFFICE 2 HASKING STREET CAROLITHE QLD 4510 Telephone: (07) 5433 0100 Fax: (07) 5433 4000				ASCOSN GRID NUMBER		
				LOG BOOK	CHECKED					45353		
				LEVEL DATUM	DATE					REV.		
				DATUM				A				