


### ENGINEER'S CERTIFICATION

"I, .....  
being a Consulting Engineer and duly authorised representative of: -  
URBEX Pty. Ltd.  
hereby:-  
# certify the information contained in this drawing is an accurate "as constructed" representation of the works;  
# accept responsibility for the "as constructed" information contained in this drawing; and  
# acknowledge the "as constructed" information contained in the drawing may be relied on by the Pine Rivers Shire Council and others.  
Certification for Stage 1 & 3 by ..... on .....  
For: BMD CONSULTING ENGINEERS Pty. Ltd.

### SURVEYOR'S CERTIFICATION

"I, Brian Collins  
being a Registered Surveying Associate and duly authorised representative of: -  
BMD CONSTRUCTIONS PTY. LTD.  
hereby:-  
# certify the information contained in this drawing is an accurate "as constructed" representation of the works;  
# accept responsibility for the "as constructed" information contained in this drawing; and  
# acknowledge the "as constructed" information contained in the drawing may be relied on by the Pine Rivers Shire Council and others.  
Certification for Stage 1 & 3 by ..... on May, 2012.  
For: Brian Collins Eng.Surv.

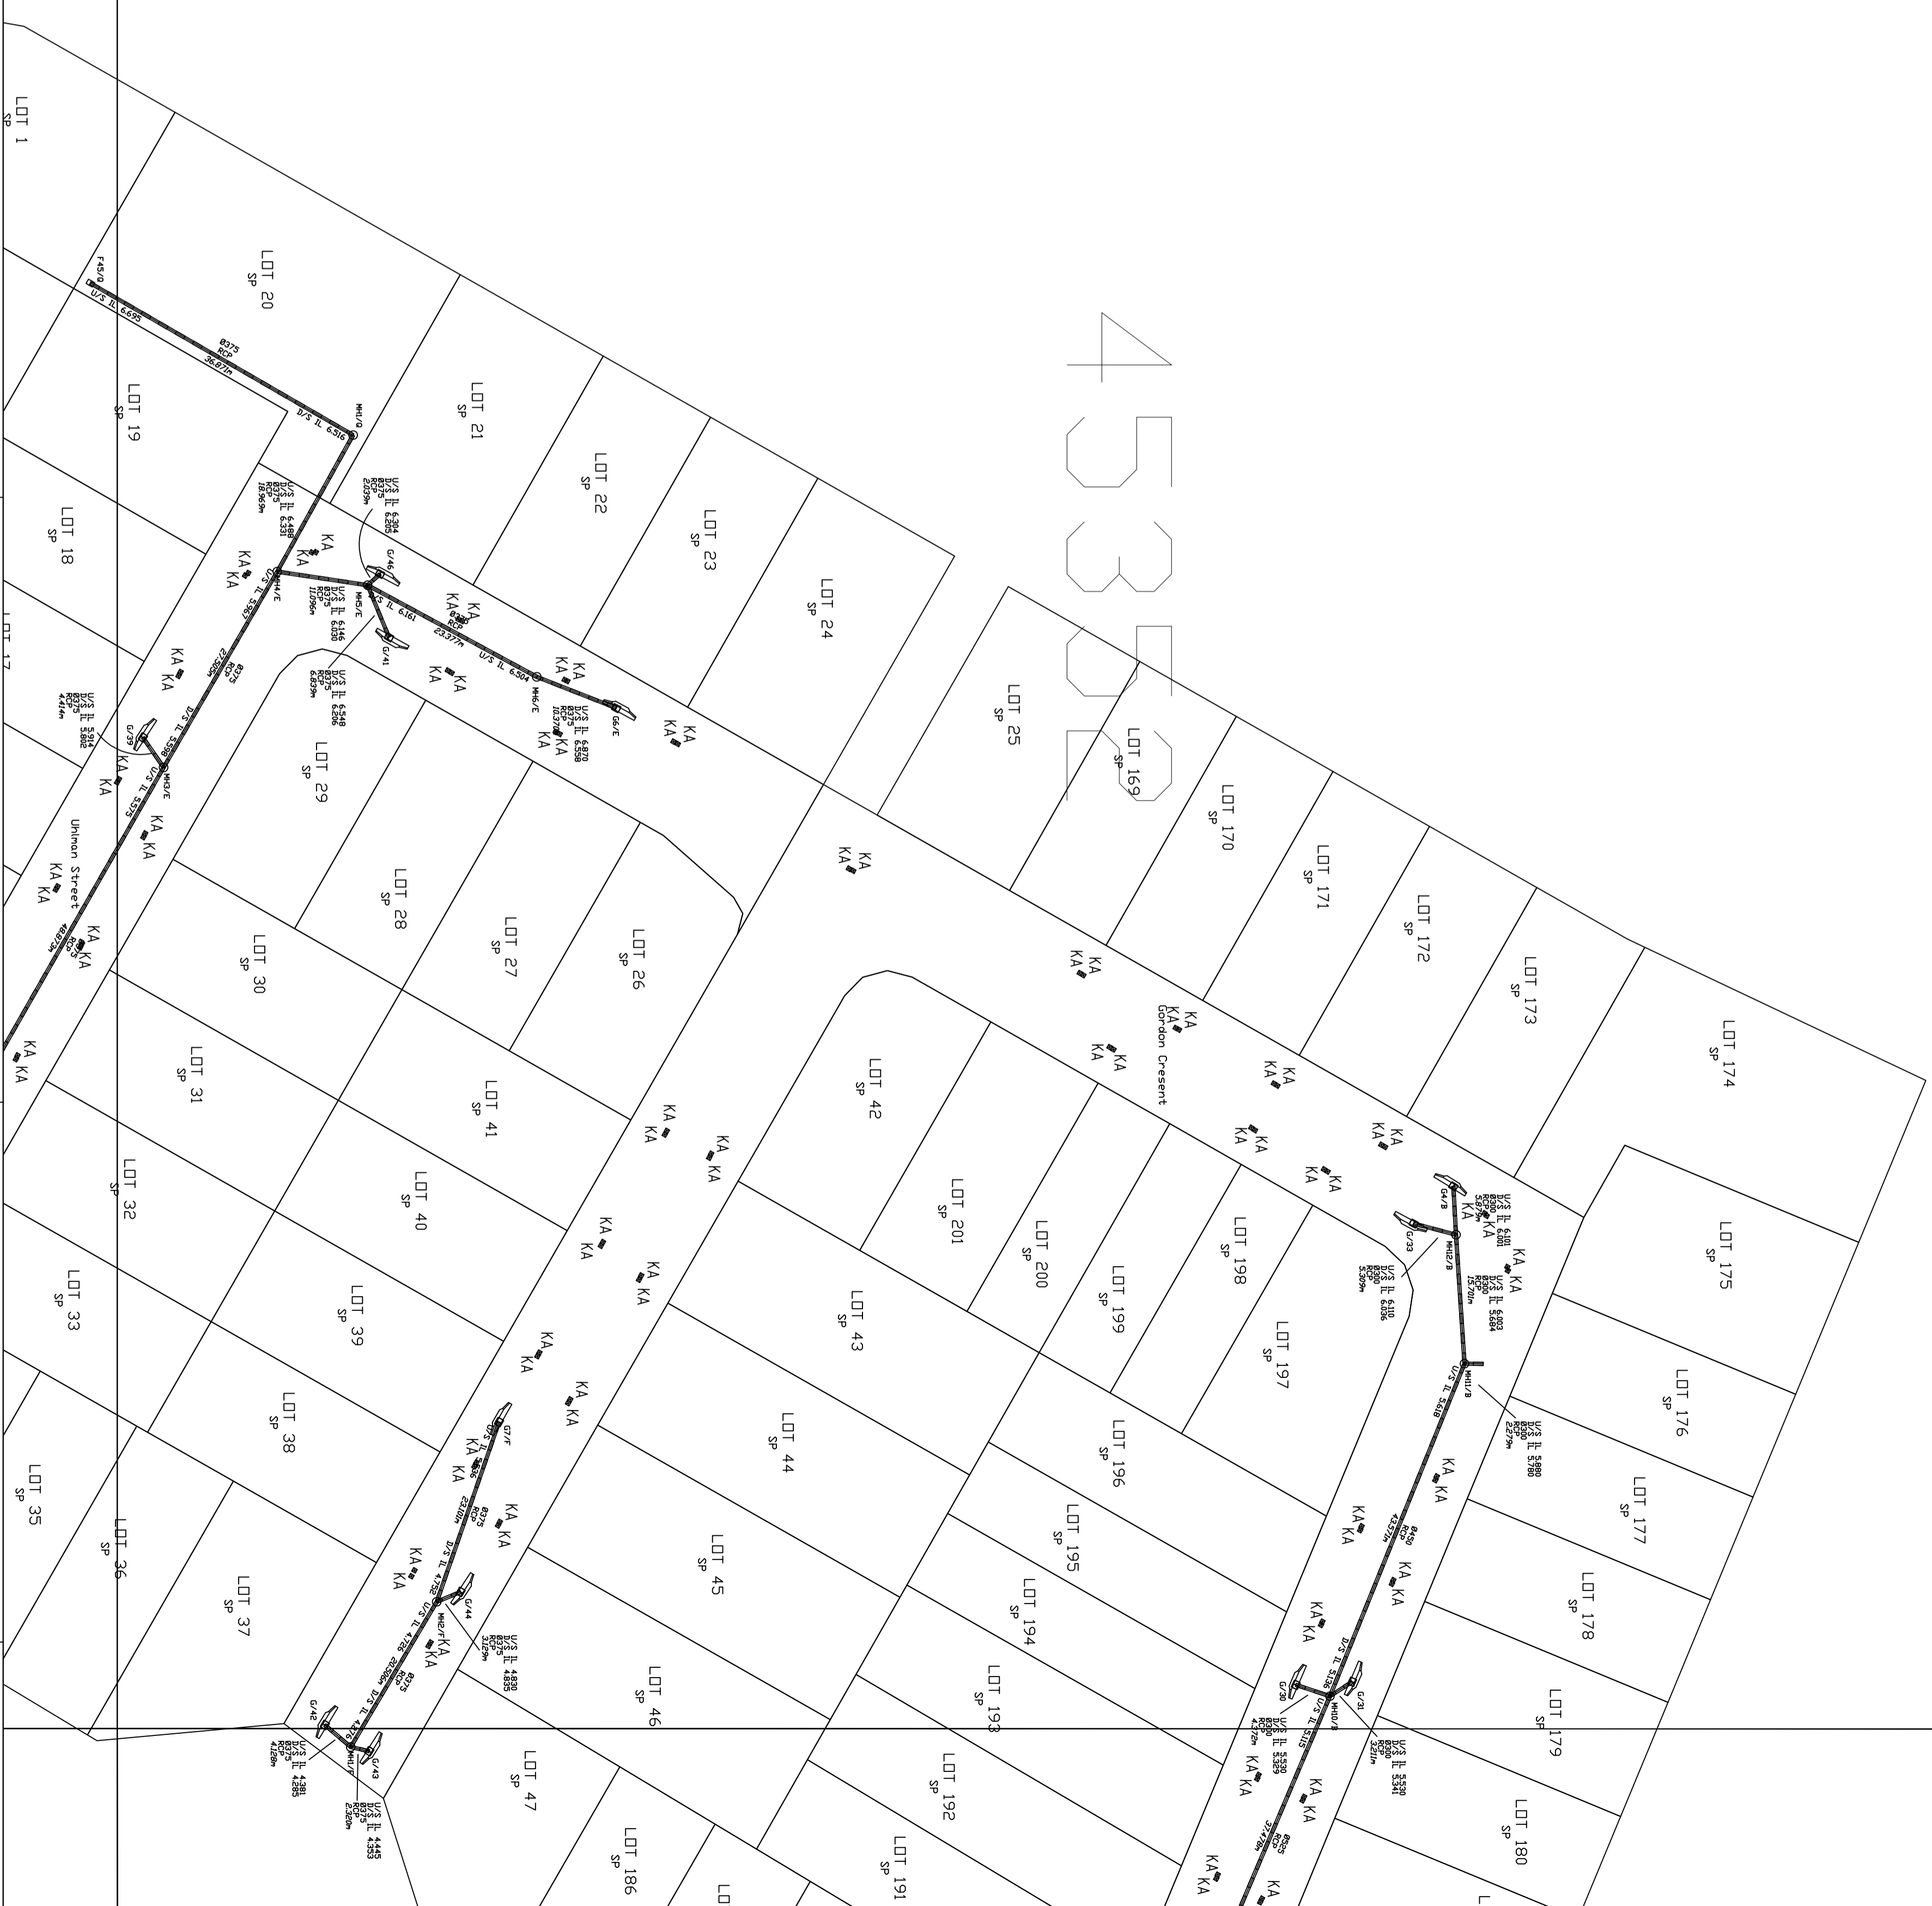

DRAWING REVISIONS		REFERENCE DRAWINGS		DESIGNED	
REV.	REVISION DESCRIPTION	DRG. No.	DESCRIPTION	CONSTRUCT. No.	DATE
A	PRELIMINARY AS CONSTRUCTED			SURVEY FILE No.	DATE
				FIELD BOOK	DATE
				LOG BOOK	CHECKED
				LEVEL DATUM	DATE
				DATUM	

THIS WORK WAS PREPARED BY:  
SUNSTATE ENGINEERING SURVEYS  
UNIT 2/44 Stone St. Constat. Qld. 4019  
Telephone: (07) 3288 7811  
Fax: (07) 3288 7883

SCALE 1:500

ORIGINAL SIZE A1

MORBERTON BAY REGIONAL COUNCIL  
CABOONITHE DISTRICT OFFICE  
2 HASKING STREET CABOONITHE QLD 4510  
Telephone: (07) 5433 0100  
Fax: (07) 5433 4000

AS CONSTRUCTED STORMWATER  
CAPESTONE STAGES 1 & 3

CSC SUBDIVISION REFERENCE  
DA 2055/10548  
No. 1 OF 4 PLANS  
ASCON GRID NUMBER  
45352