


DRAWING REVISIONS		REFERENCE DRAWINGS		DESIGNED	
REV.	REVISION DESCRIPTION	DRG. No.	DESCRIPTION	DATE	BY
A	Original				
B	Add HC Lot 56, pipe 29/4 to 29/3.			24/10/13	EJM
C	Add pipe 29/3 to 29/2.			24/10/13	EJM

THIS WORK WAS PREPARED BY:
THG HSG PTY LTD
 SCALE 1:500
 ORIGINAL SIZE A1


MORETON BAY REGIONAL COUNCIL
 CABOULTURE DISTRICT OFFICE
 2 HASKING STREET CABOULTURE QLD 4510
 Telephone: (07) 5433 0100
 Fax: (07) 5433 4000

STAGE 2A(2) CAPESTONE
AS CONSTRUCTED
SEWER RETICULATION

WABC SUBMISSION REFERENCE
 2007/11561/NEGDEC/1
 No. 3 OF 3 PLANS
45220

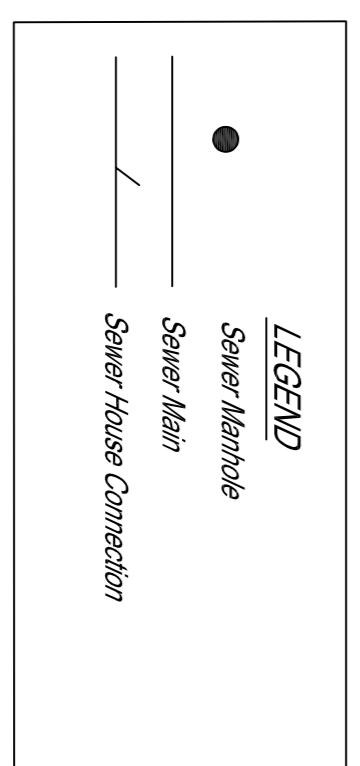

I, **Peter S. Sippel**, being a cadastral surveyor and duly authorised representative of THG HSG Pty Ltd hereby:
 • certify the information contained in this drawing is an accurate as constructed representation of the works
 • accept responsibility for the as constructed information contained in this drawing
 • acknowledge the as constructed information contained in the drawing may be relied on by council and others
 Certification of Stages 2A(2) by **P. Sippel** on **24/10/13** (Signature) (Date)
 for THG HSG Pty Ltd