


I, Peter Sippel being a cadastral surveyor and duly authorised representative of THG HSG Pty Ltd hereby:
 • certify the information contained in this drawing is an accurate as constructed representation of the works
 • accept responsibility for the as constructed information contained in this drawing
 • acknowledge the as constructed information contained in the drawing may be relied on by council and others
 Certification of Stages 2A(2) by Peter Sippel on 24/10/13
 (Signature) (Date)
 for THG HSG Pty Ltd

LEGEND

- New Hydrant
- New Lane
- New End Cap
- New Water Service Conduit (Indicative Only)
- New Water Service Connection (Indicative Only)
- New Water House Connection

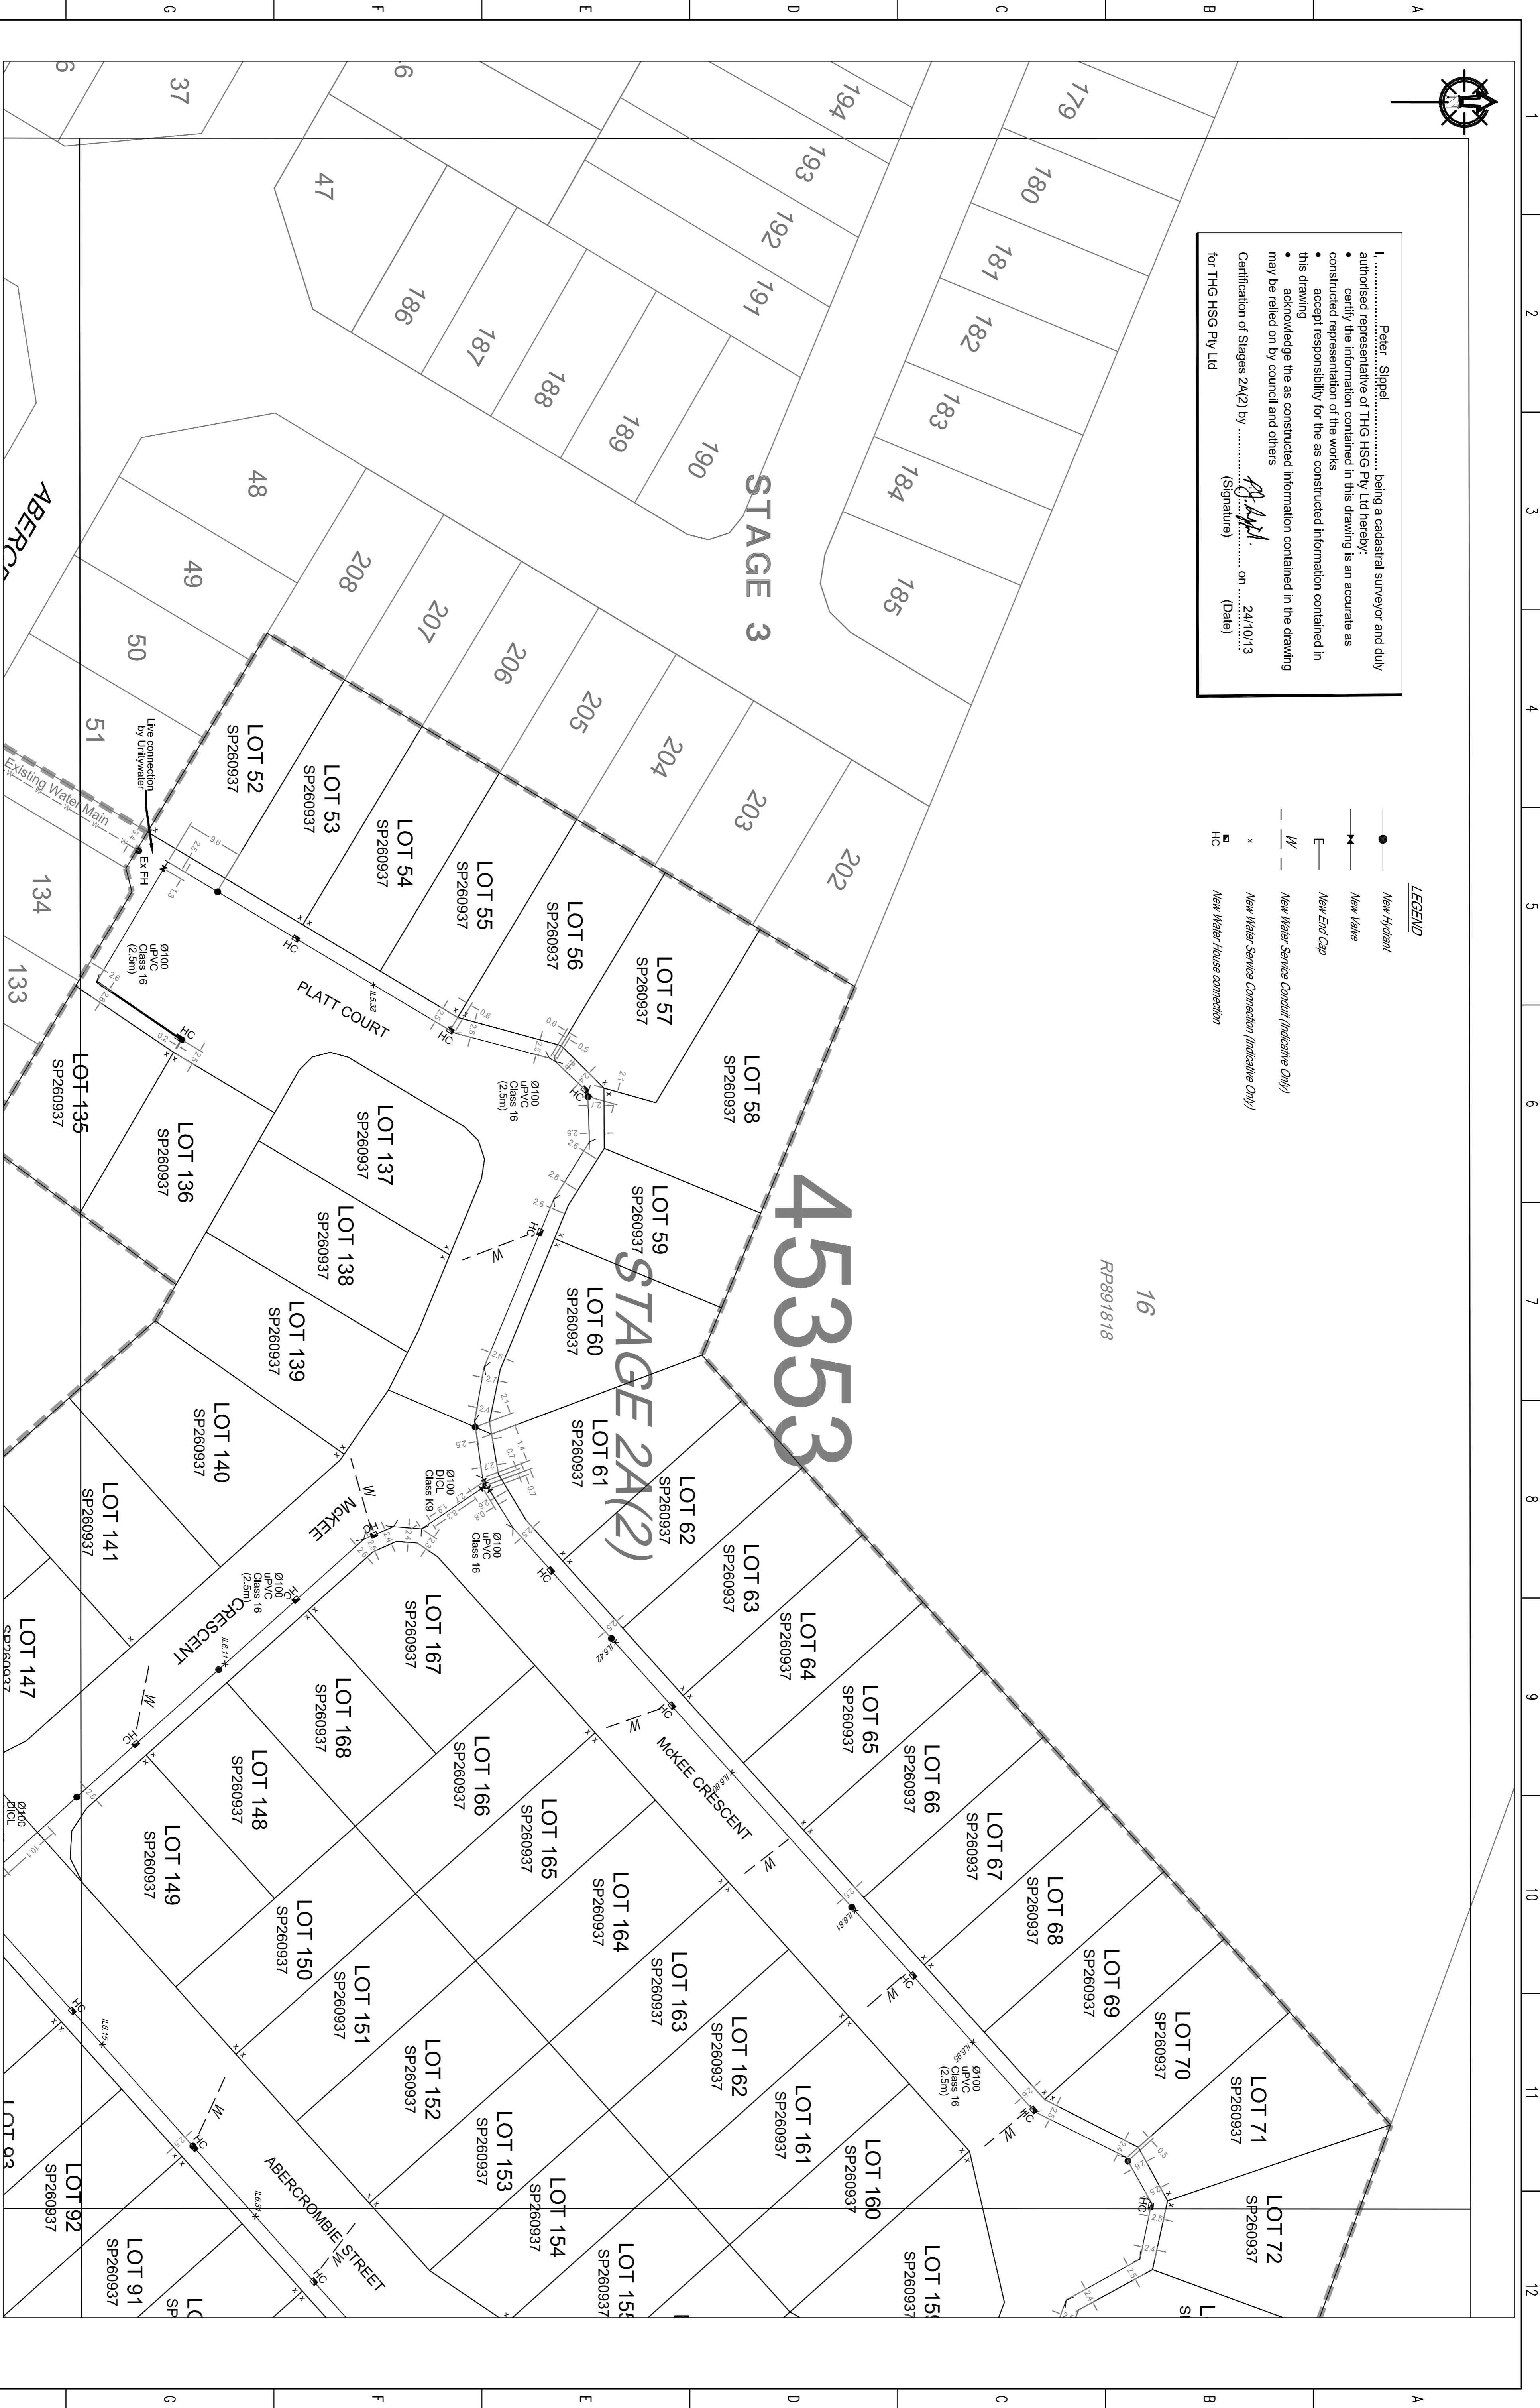

| DRAWING REVISIONS | | REFERENCE DRAWINGS | | DESIGNED | | THIS WORK WAS PREPARED BY: | | MARC SUBMISSION REFERENCE | |
|-------------------|----------------------|--------------------|-------------|----------------|----------|----------------------------|--|--|---------------------|
| REV. | REVISION DESCRIPTION | DRG. No. | DESCRIPTION | CONSTRUCT. No. | DATE | DATE | THG HSG PTY LTD | No. 1 OF 3 PLANS | 2007/11561/NEC/EC/1 |
| A | Original | | | | 24/10/13 | EM | THG HSG PTY LTD MORETON BAY REGIONAL COUNCIL CABOULTURE DISTRICT OFFICE 2 HASKING STREET CABOULTURE QLD 4510 Telephone: (07) 5433 0100 Fax: (07) 5433 4000 | 45353 | |
| B | Update | | | | 24/10/13 | EM | | STAGE 2A(2) CAPESTONE AS CONSTRUCTED WATER RETICULATION | REV. |