


I, Lance Hayes being a cadastral surveyor and duly authorised representative of THG HSG Pty Ltd hereby:
 • certify the information contained in this drawing is an accurate as constructed representation of the works
 • accept responsibility for the as constructed information contained in this drawing
 • acknowledge the as constructed information contained in the drawing may be relied on by council and others
 Certification of Stage 2A(1) by on 16/5/13
 (Signature) (Date)
 for THG HSG Pty Ltd

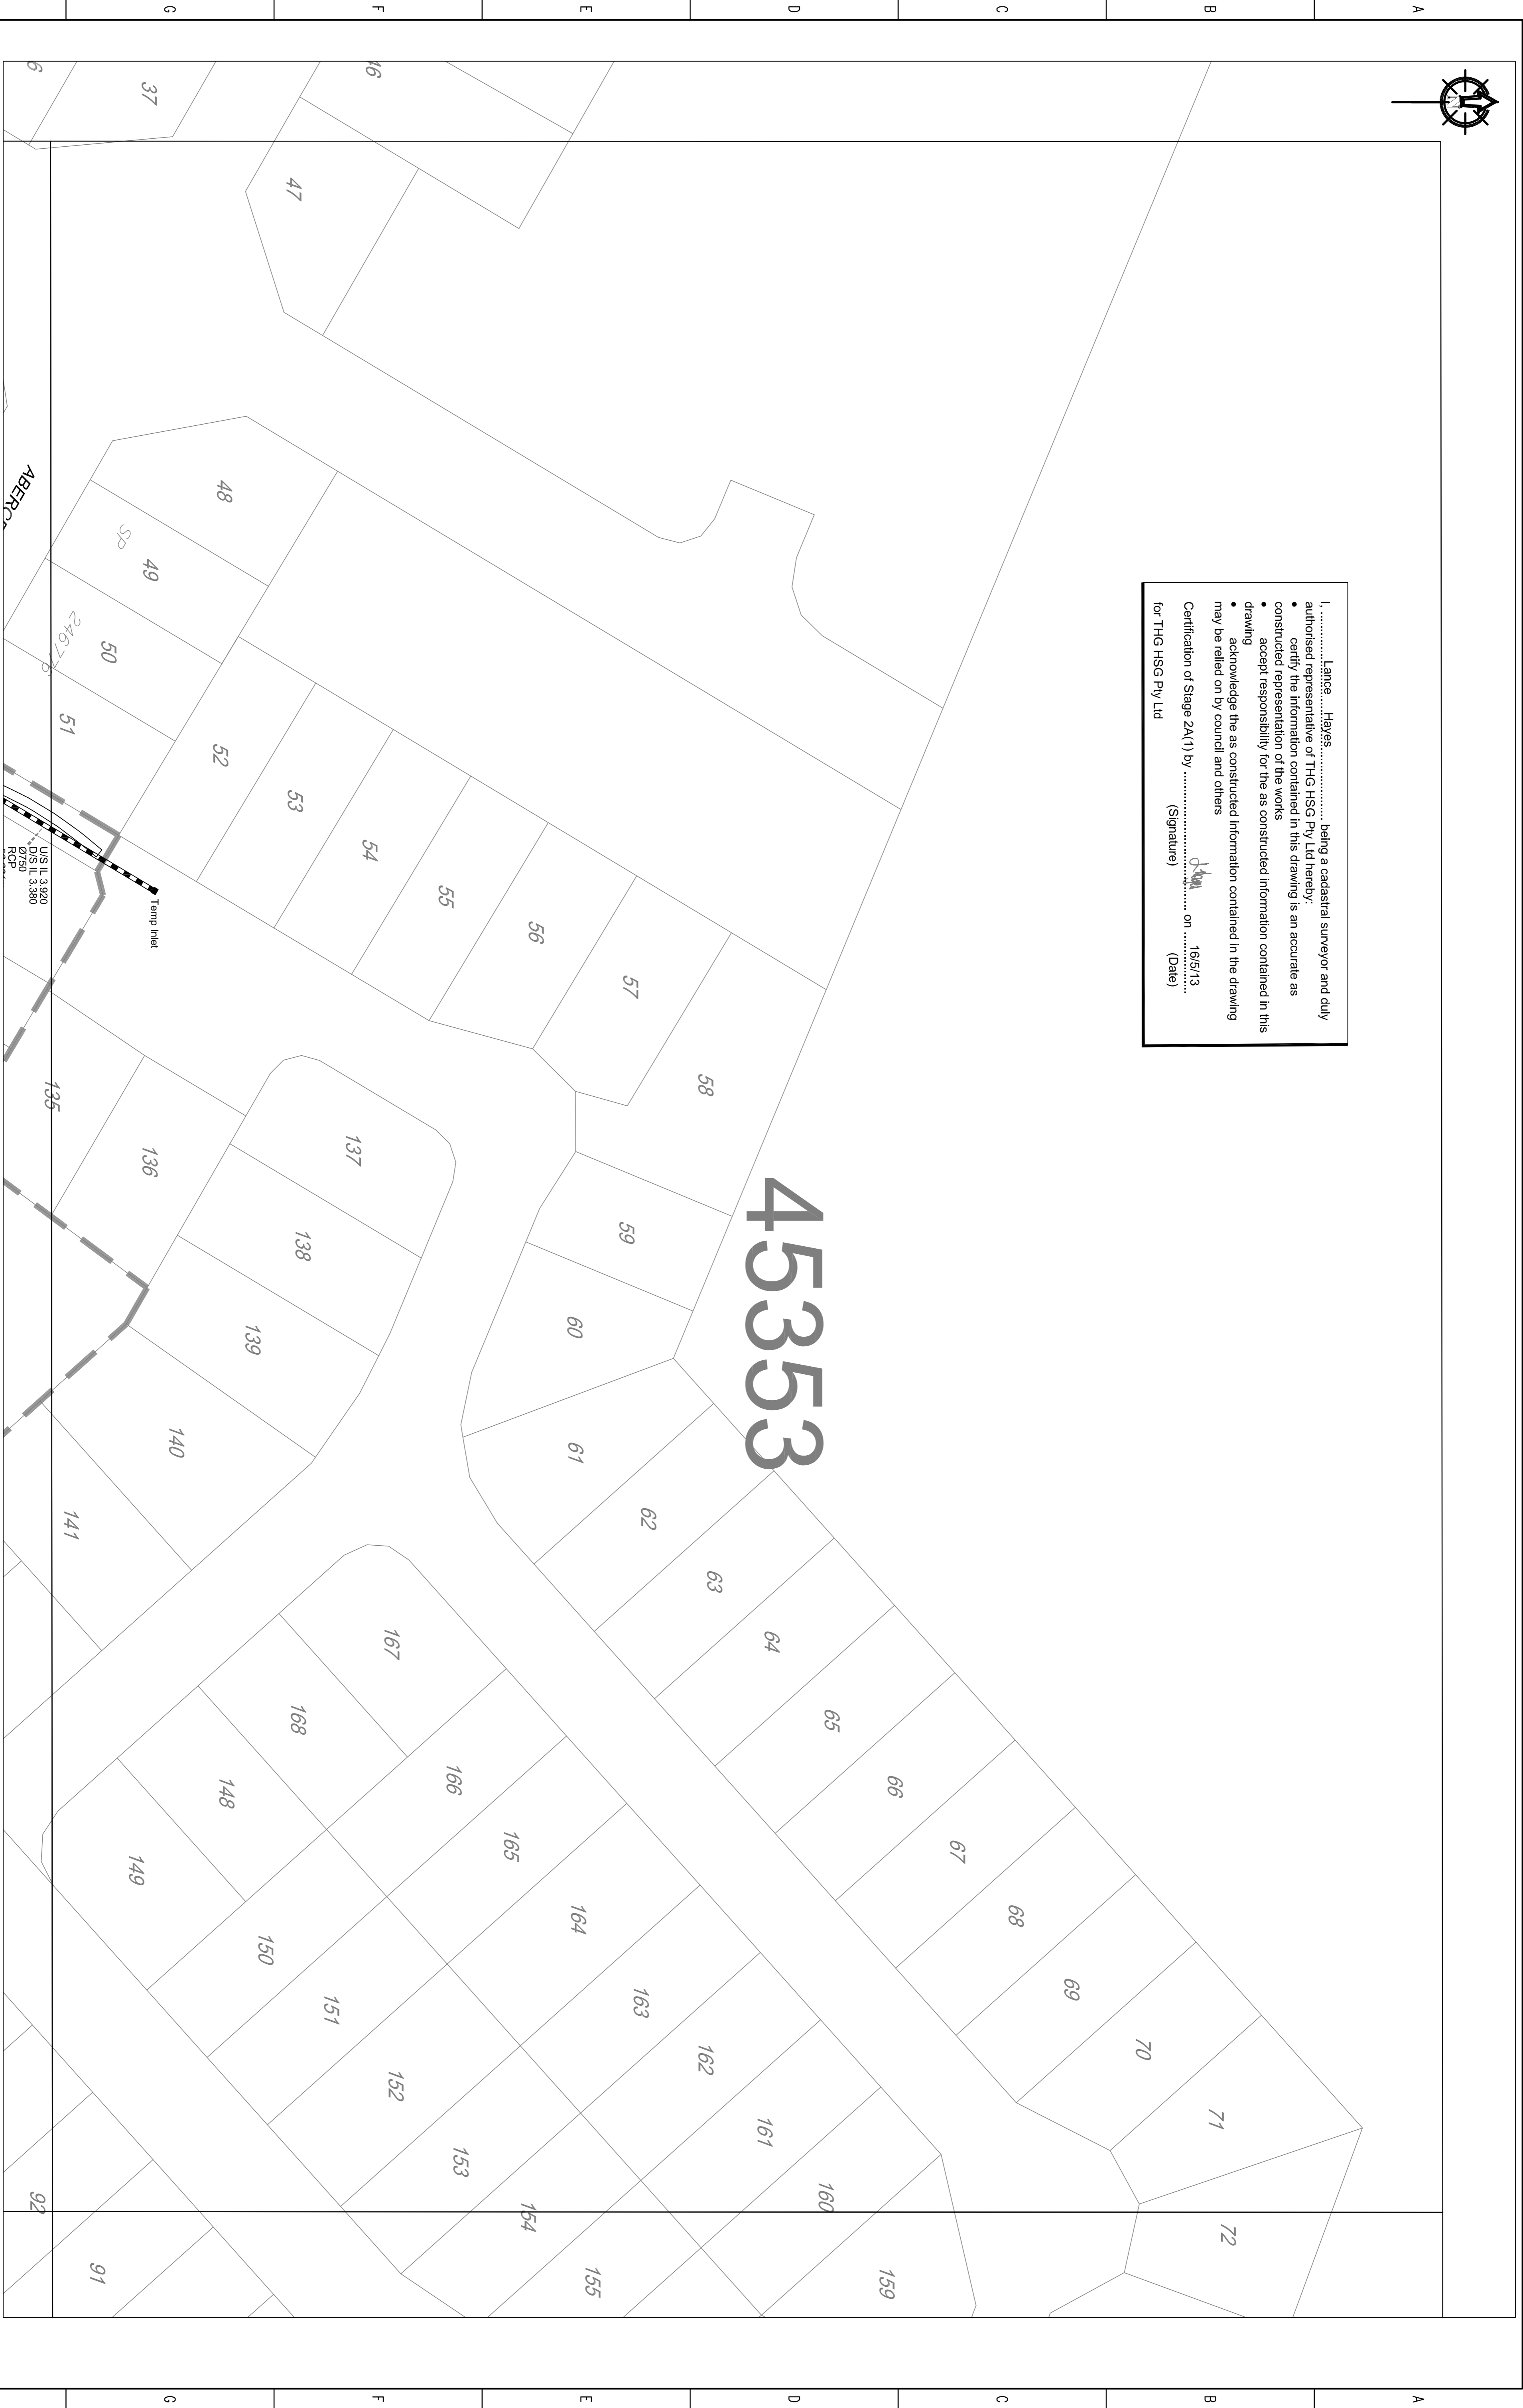

45353

DRAWING REVISIONS		REFERENCE DRAWINGS		DESIGN FILE No.		DESIGNED		THIS WORK WAS PREPARED BY:		MARC SUBDIVISION REFERENCE		
REV.	REVISION DESCRIPTION	DRG. No.	DESCRIPTION	CONSTRUCT. No.	SURVEY FILE No.	DATE	DATE	THG HSG PTY LTD	2007/11561/NECDEC/1	No. 1 OF 2 PLANS	REV.	
A	Original				216602_7	16/5/13	16/5/13				A	
					LOG BOOK	EM	EM					
					LEVEL DATUM	16/5/13	16/5/13					
					DATUM	PM38947						
								SCALE 1:500	ORIGINAL SIZE A1			
										MORETON BAY REGIONAL COUNCIL CABOULTURE DISTRICT OFFICE 2 HASKING STREET CABOULTURE QLD 4510 Telephone: (07) 5433 0100 Fax: (07) 5433 4000		
								STAGE 2A(1) CABBESTONE AS CONSTRUCTED ROADS AND DRAINAGE		45353		