

I, Peter Sippel, being a cadastral surveyor and duly authorised representative of Queensland Surveying Pty Ltd hereby:

- certify the information contained in this drawing is an accurate as constructed representation of the works
- accept responsibility for the as constructed information contained in this drawing
- acknowledge the as constructed information contained in the drawing may be relied on by council and others

Certification by *P. Sippel* on 16/11/2017  
 (Signature) (Date)  
 for Queensland Surveying Pty Ltd

**ENGINEER'S CERTIFICATION**

I, Darryl Hayter, being a Consulting Engineer and duly authorised representative of: - EMPOWER ENGINEERS AND PROJECT MANAGERS hereby:-


- certify the information contained in this drawing is an accurate "as constructed" representation of the works;
- accept responsibility for the "as constructed" information contained in this drawing; and
- acknowledge the "as constructed" information contained in the drawing may be relied on by the Moreton Bay Regional Council and others.

Certification for Stage 19 by *D. Hayter* on 24/11/17  
 For: EMPOWER ENGINEERS AND PROJECT MANAGERS RPEQ 5694

REV.	DRAWING REVISIONS	REFERENCE DRAWINGS	DESIGN FILE No.	DESIGNED	
REV.	REVISION DESCRIPTION	DRG. No.	DESCRIPTION	CONSTRUCT. No.	DATE
A	Progress Plot				
B	Update				
C	Update				
D	Update				

**THIS WORK WAS PREPARED BY:**  
**QUEENSLAND SURVEYING PTY LTD**

SCALE 1:500 ORIGINAL SIZE A1



**MORETON BAY REGIONAL COUNCIL**  
 CABOOLTURE DISTRICT OFFICE  
 2 HASKING STREET CABOOLTURE QLD 4510  
 Telephone: (07) 5433 0100  
 Fax: (07) 5433 4000

**STAGE 19, CAPESTONE**  
**AS CONSTRUCTED**  
**DRAINAGE**

MBRC SUBDIVISION REFERENCE	
DA/32670/2016/V23R	
No. 1 OF 2 PLANS	REV.
DRAWING NUMBER	
30105-190100 AD	D




I, Peter Sippel, being a cadastral surveyor and duly authorised representative of Queensland Surveying Pty Ltd hereby:

- certify the information contained in this drawing is an accurate as constructed representation of the works
- accept responsibility for the as constructed information contained in this drawing
- acknowledge the as constructed information contained in the drawing may be relied on by council and others

Certification by *Peter Sippel* on 16/11/2017  
(Signature) (Date)  
for Queensland Surveying Pty Ltd

○ PM55164

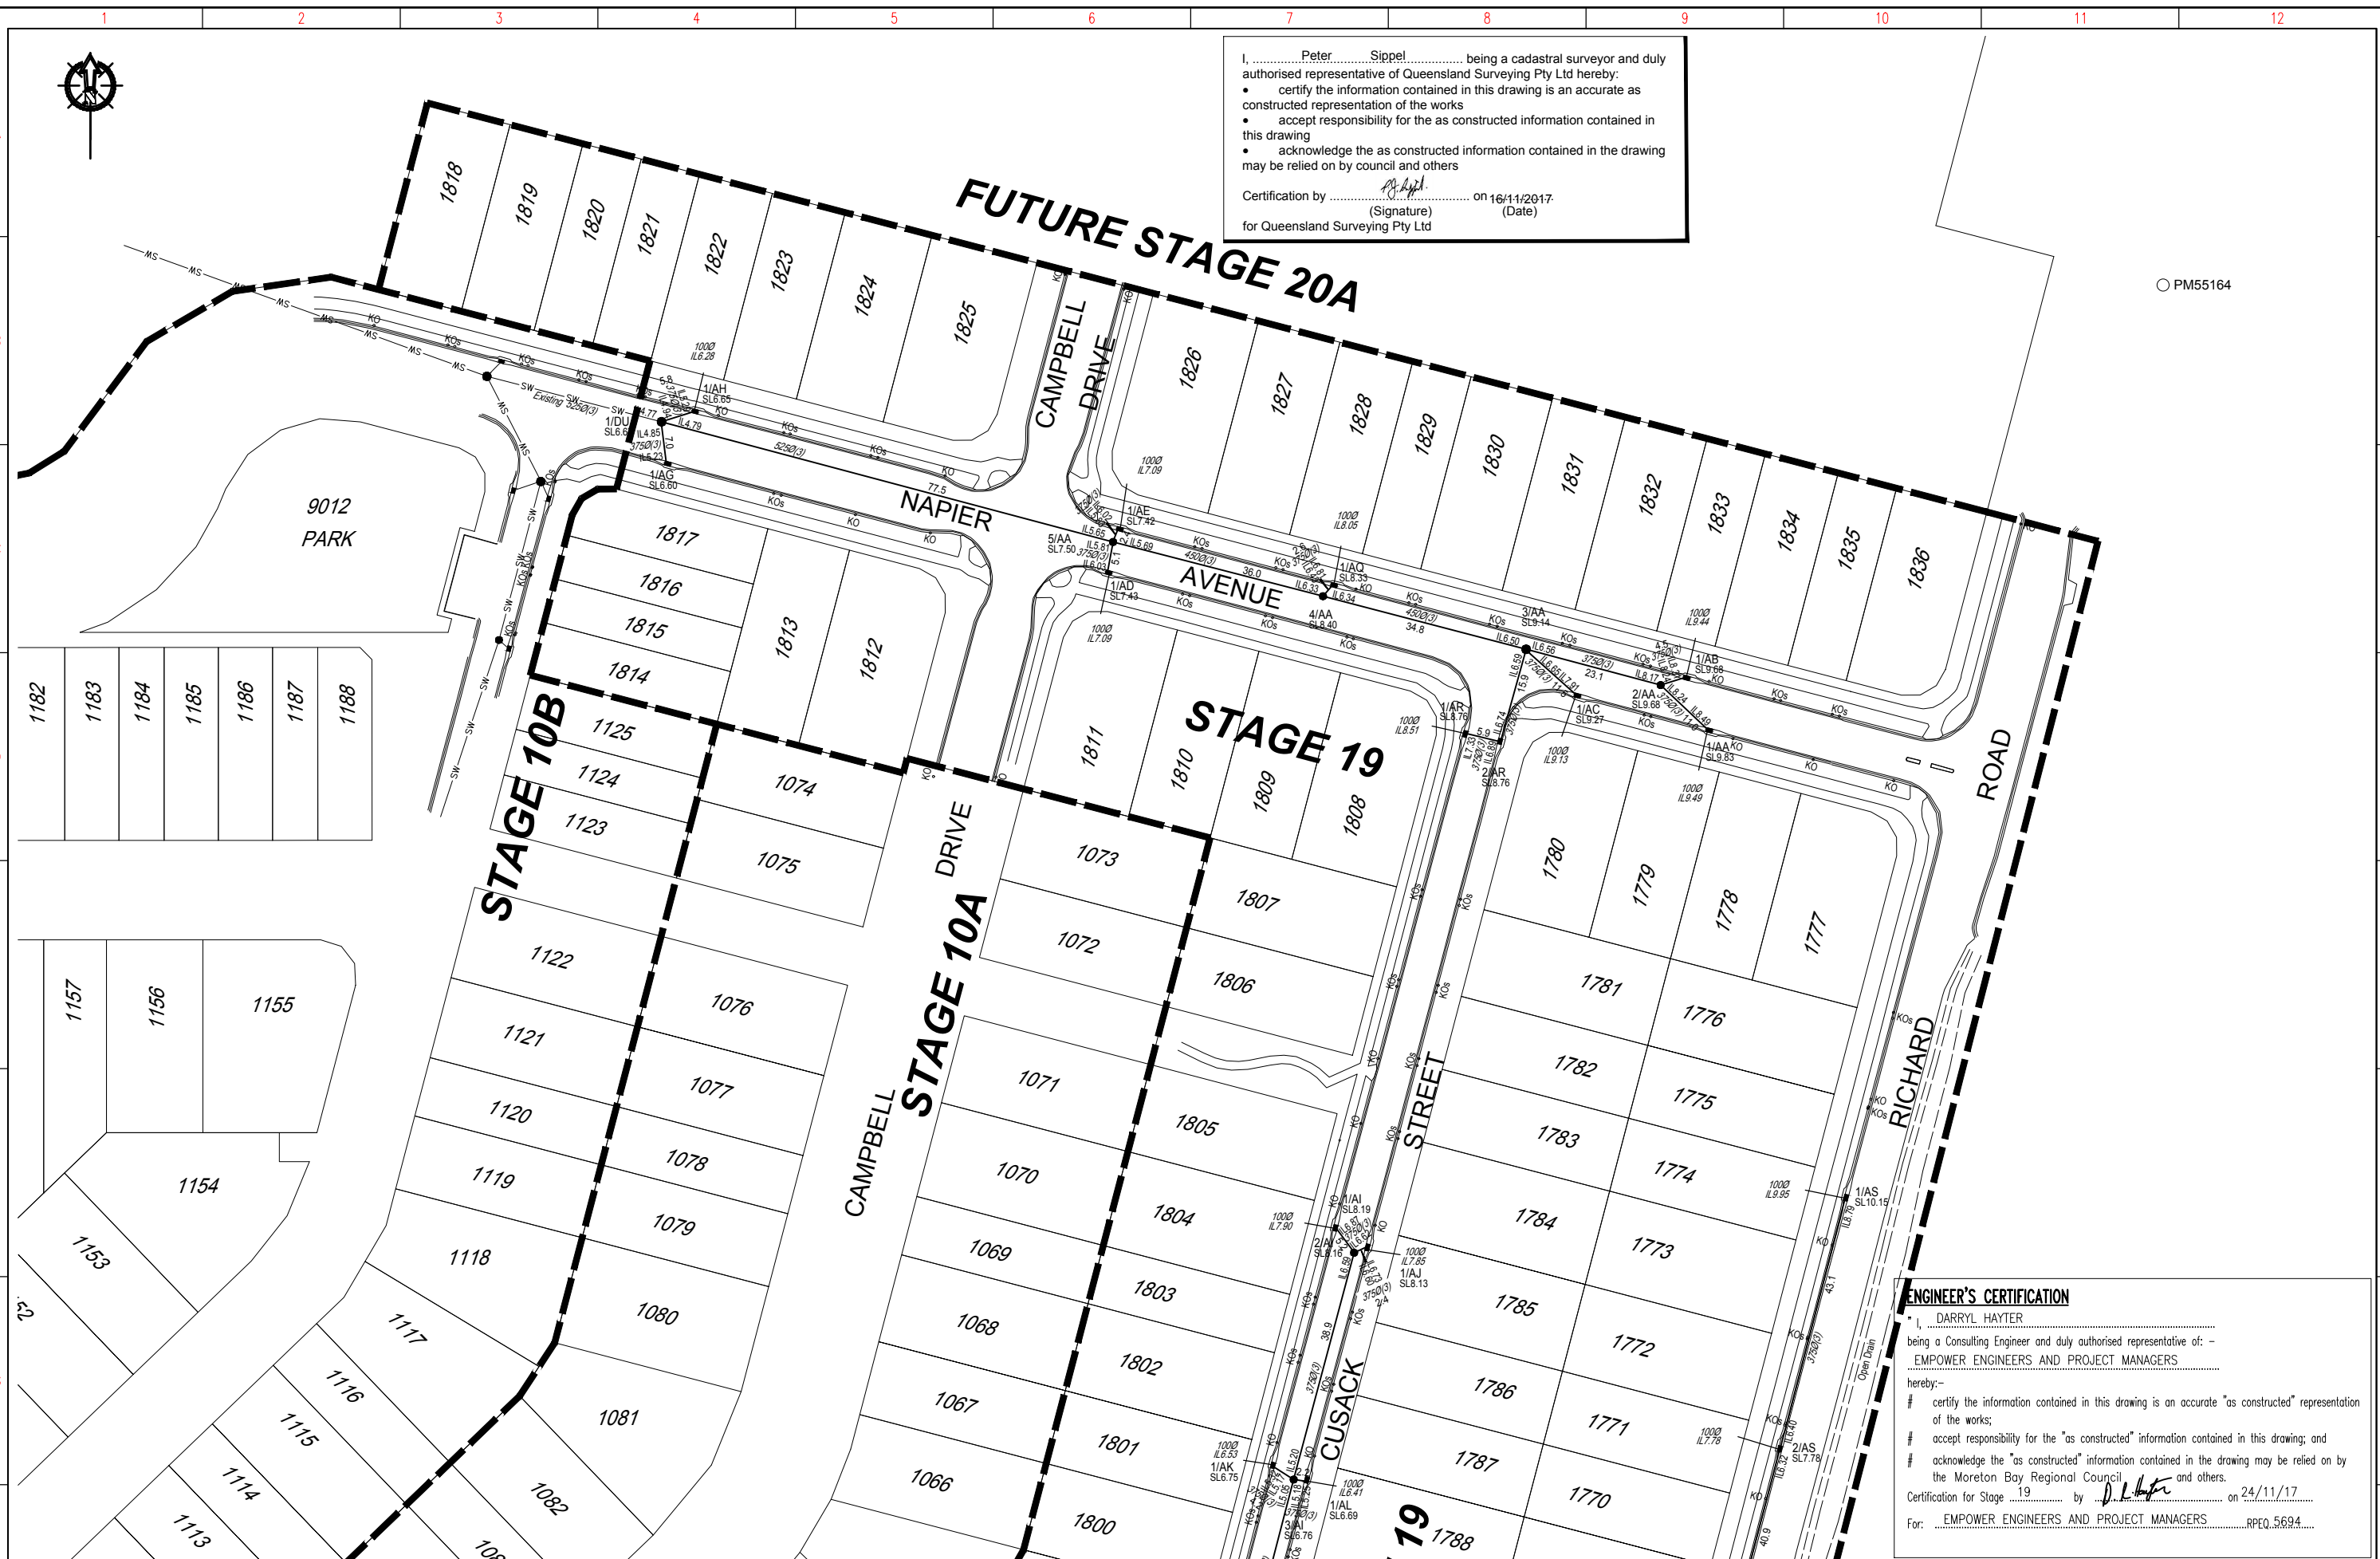

**ENGINEER'S CERTIFICATION**

I, DARRYL HAYTER, being a Consulting Engineer and duly authorised representative of: - EMPOWER ENGINEERS AND PROJECT MANAGERS hereby:-

- certify the information contained in this drawing is an accurate "as constructed" representation of the works;
- accept responsibility for the "as constructed" information contained in this drawing; and
- acknowledge the "as constructed" information contained in the drawing may be relied on by the Moreton Bay Regional Council and others.

Certification for Stage 19 by *D. Hayter* on 24/11/17  
For: EMPOWER ENGINEERS AND PROJECT MANAGERS RPEQ 5694

DRAWING REVISIONS		REFERENCE DRAWINGS		DESIGN FILE No.	DESIGNED
REV.	REVISION DESCRIPTION	DRG. No.	DESCRIPTION	CONSTRUCT. No.	DATE
A	Progress Plot			SURVEY FILE No. 30105-190100 AD	DRAWN EJM
B	Update			FIELD BOOK	DATE 16/11/2017
C	Update			LOG BOOK	CHECKED EJM
D	Update			LEVEL DATUM AHD	DATE 16/11/2017
				DATUM PM177891	

**THIS WORK WAS PREPARED BY:  
QUEENSLAND SURVEYING PTY LTD**

SCALE 1:500 ORIGINAL SIZE A1

**MORETON BAY REGIONAL COUNCIL**  
CABOOLTURE DISTRICT OFFICE  
2 HASKING STREET CABOOLTURE QLD 4510  
PO BOX 159 CABOOLTURE QLD 4510  
Telephone: (07) 5433 0100  
Fax: (07) 5433 4000

**STAGE 19, CAPESTONE  
AS CONSTRUCTED  
DRAINAGE**

MBRC SUBDIVISION REFERENCE	
DA/32670/2016/V23R	
No. 2 OF 2 PLANS	
DRAWING NUMBER	REV.
30105-190100 AD	D