




ENGINEER'S CERTIFICATION
 * I, DARRYL HAYTER
 being a Consulting Engineer and duly authorised representative of: -
 Empower Engineers & Project Managers
 hereby:-
 # certify the information contained in this drawing is an accurate "as constructed" representation of the works;
 # accept responsibility for the "as constructed" information contained in this drawing; and
 # acknowledge the "as constructed" information contained in the drawing may be relied on by the Moreton Bay Regional Council and others.
 Certification for Stage 20A by *D.L.H.* on 28/06/18
 For: Empower Engineers & Project Managers RPEQ 5694

Registered Surveyor's Certification.
 We, Veris Australia Pty Ltd hereby certify that the horizontal and vertical locations, and dimensions shown on this plan are a true and correct record of the As Constructed information.
 Signed: *A. J. Apple* Cadastral Surveyor & Delegate, Reg. No. 6448, Dated 29/06/2018

LEGEND

5.4 — AS CONSTRUCTED CONTOURS (Interval 0.2m)

— RETAINING WALL

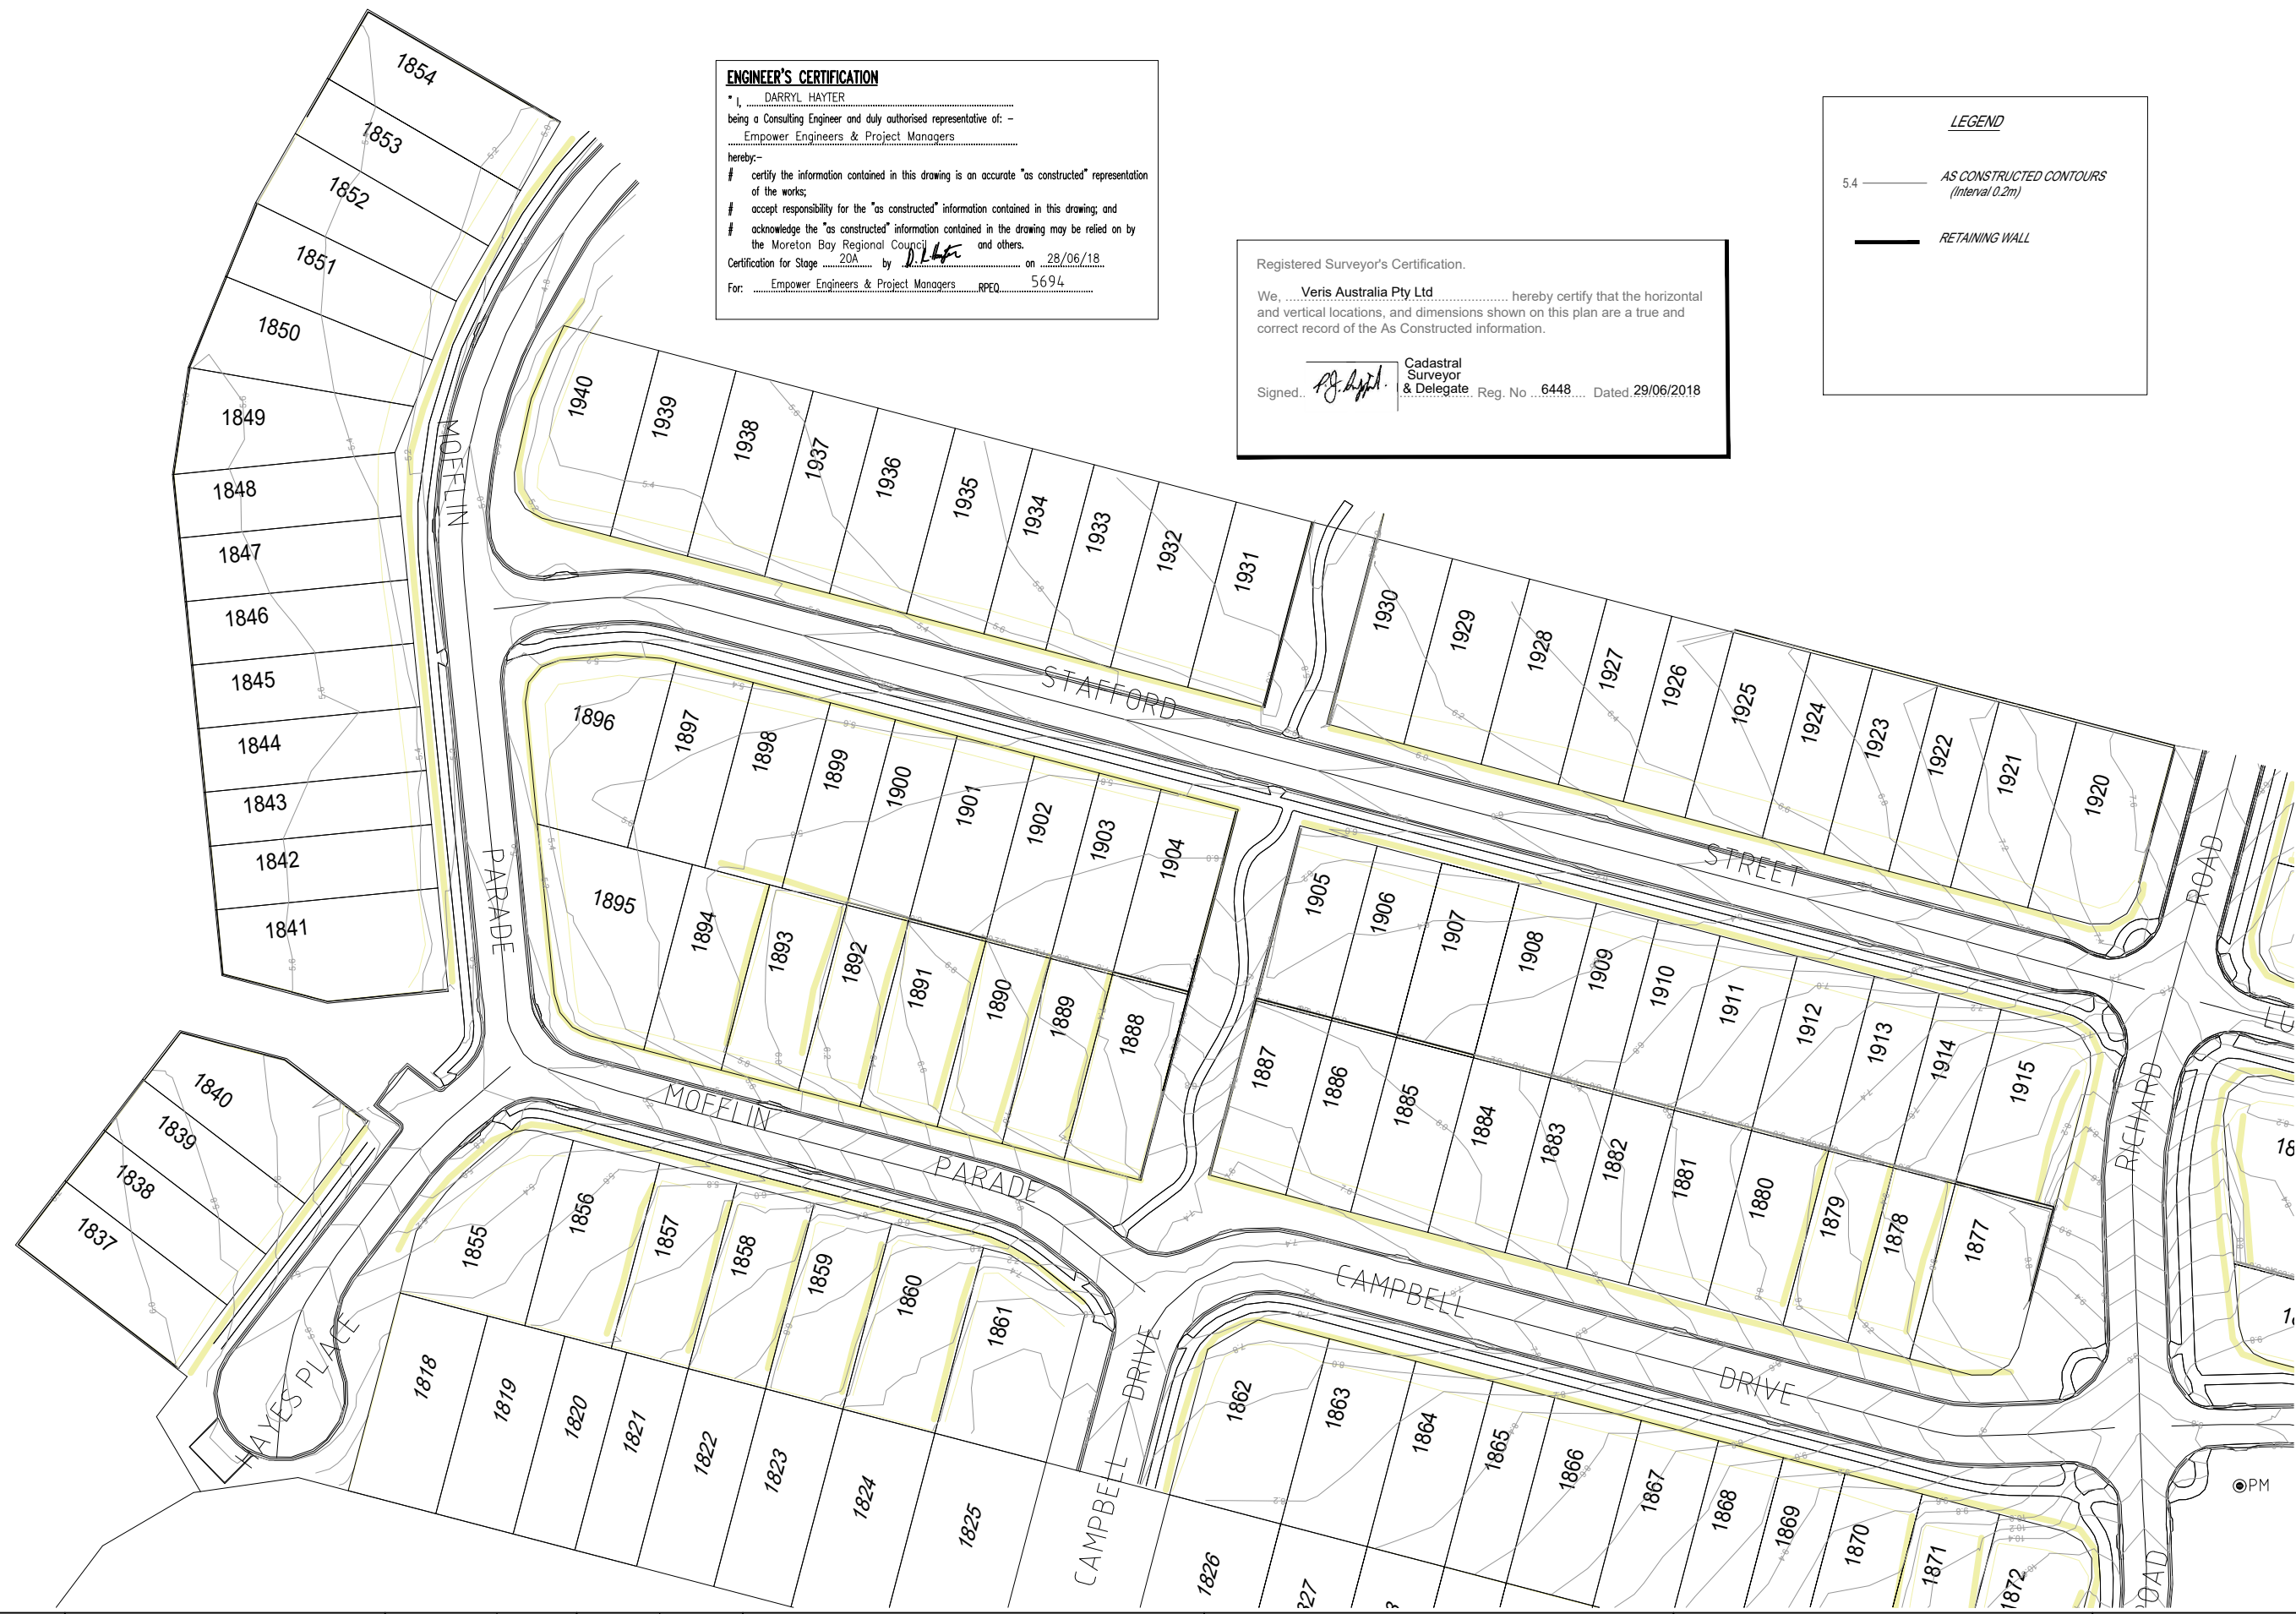

DRAWING REVISIONS		REFERENCE DRAWINGS		DESIGN FILE No.	DESIGNED
REV.	REVISION DESCRIPTION	DRG. No.	DESCRIPTION	CONSTRUCT. No.	DATE
A	Progress Plot			30105-20A100 AE	14/06/2018
				FIELD BOOK	14/06/2018
				LOG BOOK	
				LEVEL DATUM	AHD
				DATUM	PM177891

veris

BRISBANE (07) 3888 4700
 MACKAY (07) 461 2911
 PROSERPINE (07) 466 1752
 CAIRNS (07) 451 6722
 veris.com.au
 ACN 604 871 374
 Queensland Surveying 79, 134 & Veris Company

SCALE 1:500 ORIGINAL SIZE A1


Moreton Bay
 Regional Council

MORETON BAY REGIONAL COUNCIL
 CABOOLTURE DISTRICT OFFICE
 2 HASKING STREET CABOOLTURE QLD 4510
 PO BOX 159 CABOOLTURE QLD 4510
 Telephone: (07) 5433 0100
 Fax: (07) 5433 4000

STAGE 20A, CAPESTONE AS CONSTRUCTED EARTHWORKS

MBRC SUBDIVISION REFERENCE

No. 1 OF 2 PLANS	REV.
DRAWING NUMBER	A
30105-20A100 AE	

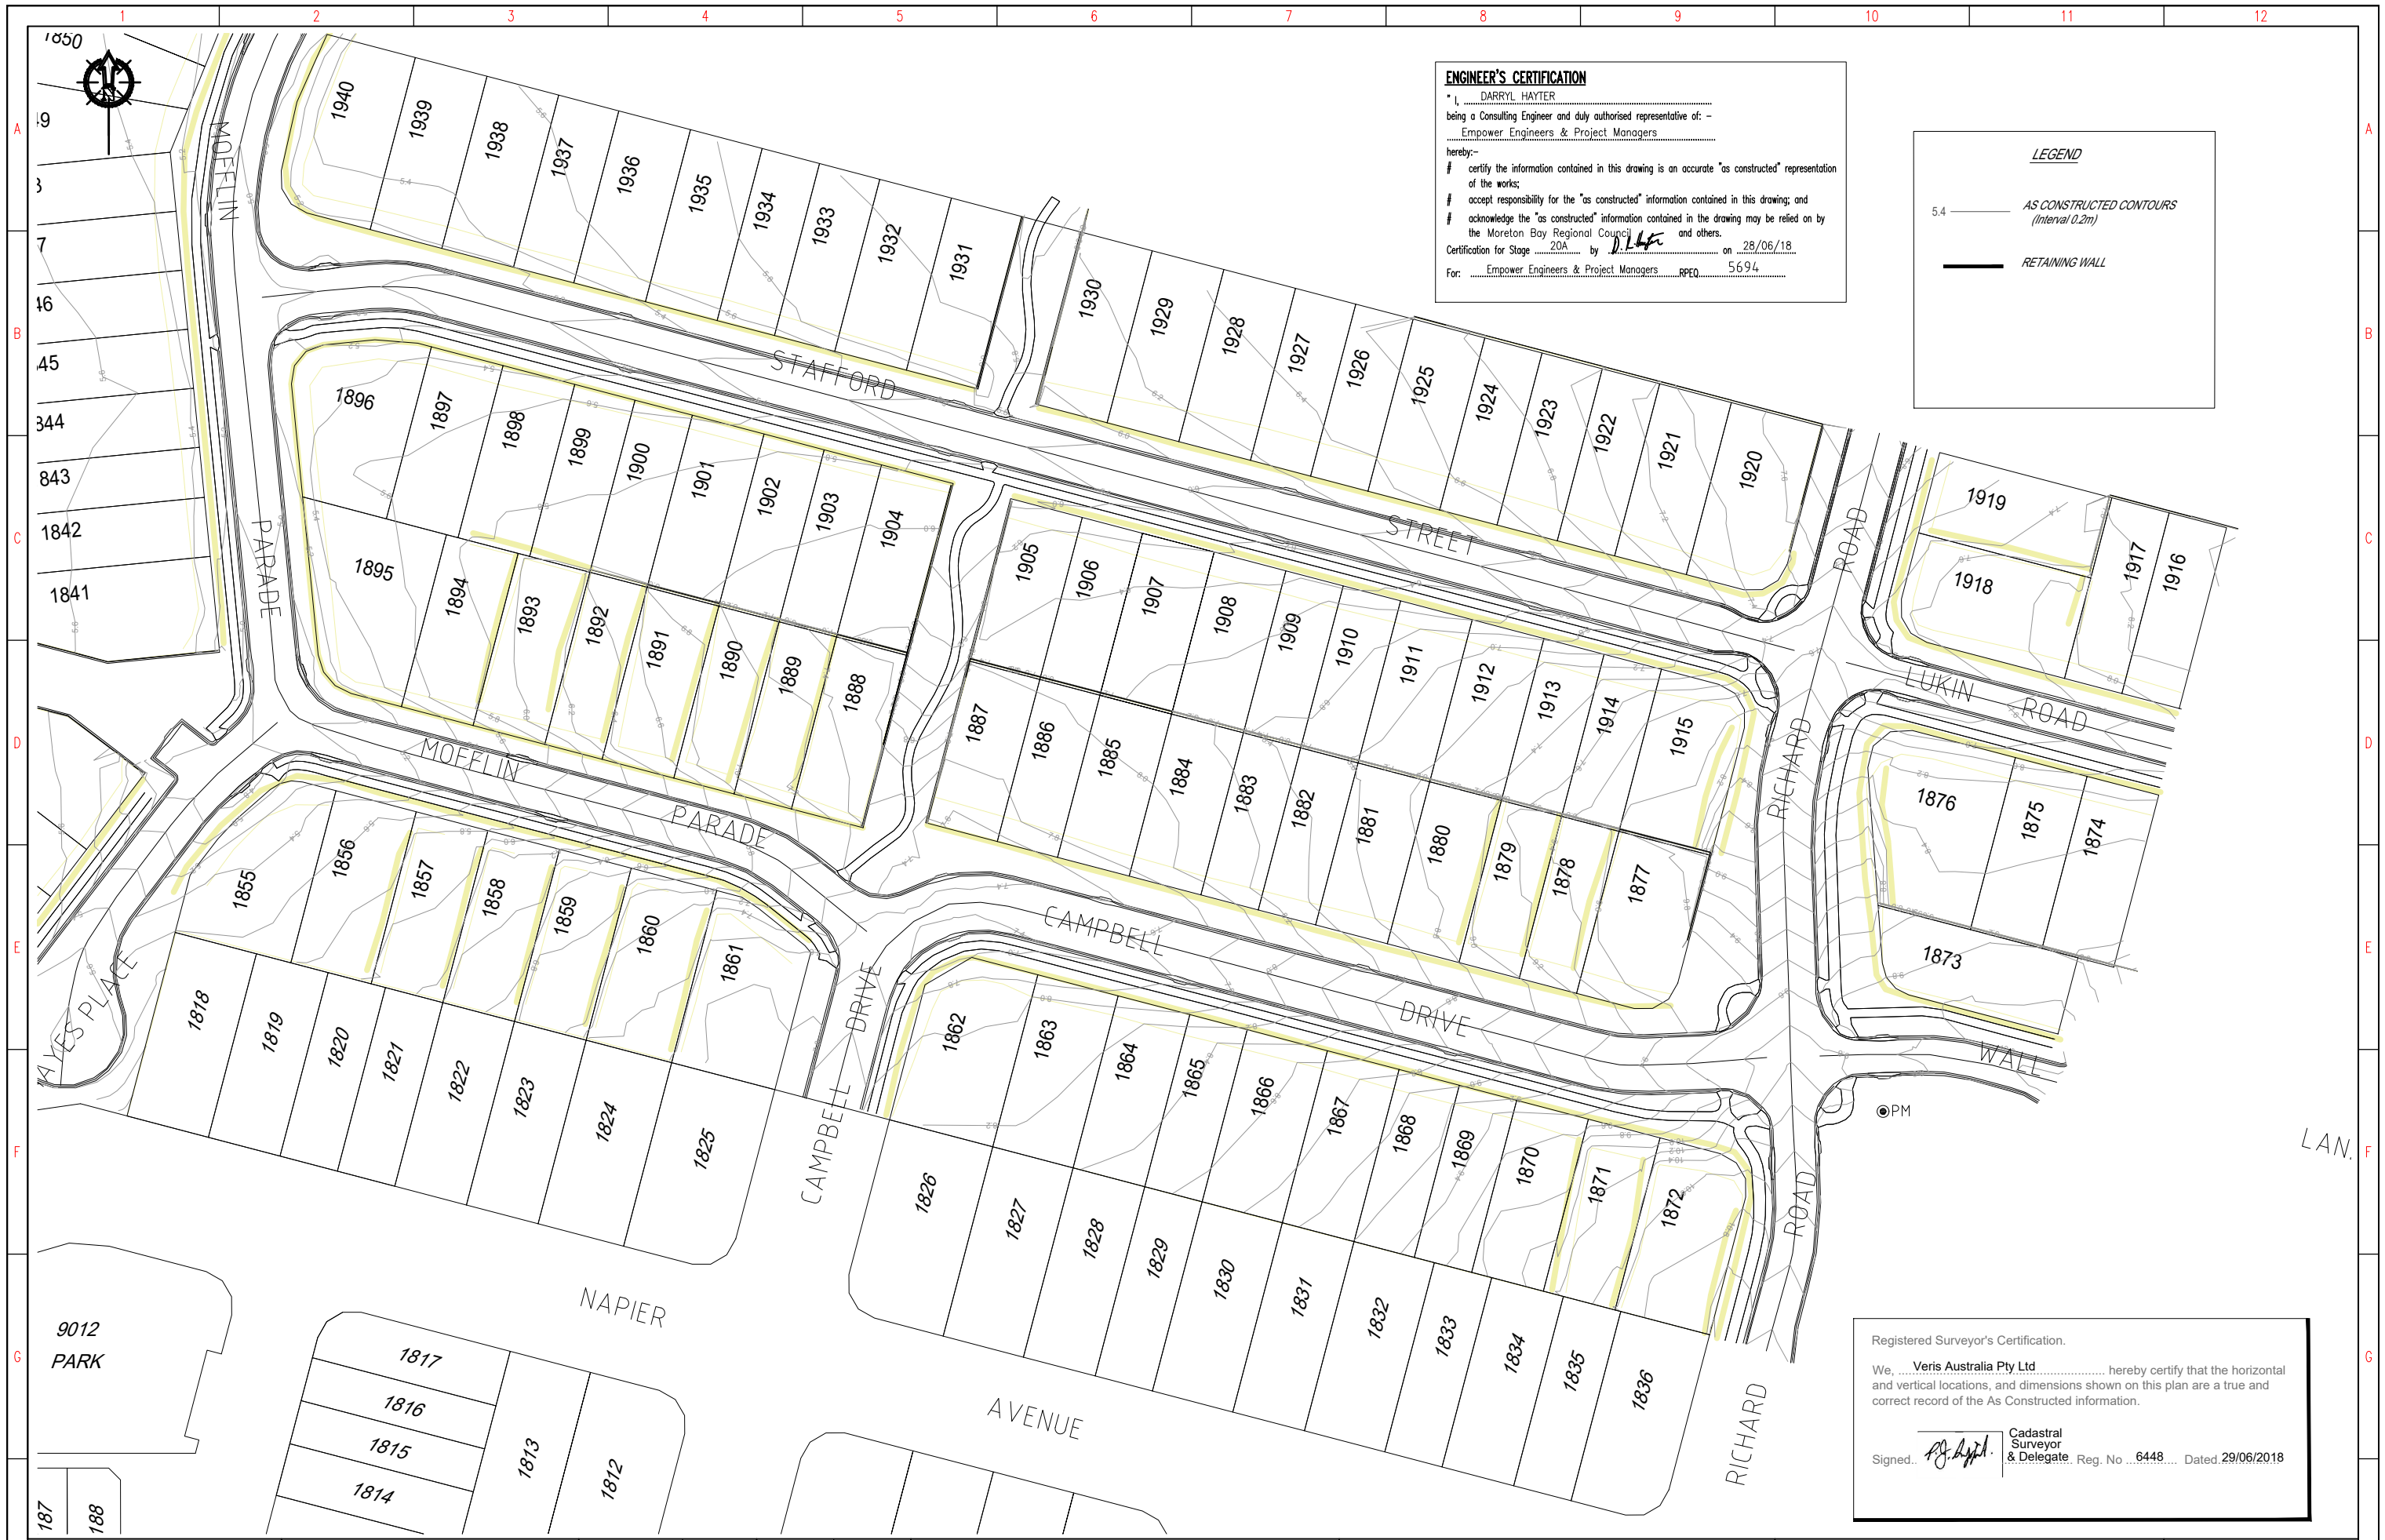

ENGINEER'S CERTIFICATION
 I, DARRYL HAYTER
 being a Consulting Engineer and duly authorised representative of: -
 Empower Engineers & Project Managers
 hereby:-
 # certify the information contained in this drawing is an accurate "as constructed" representation of the works;
 # accept responsibility for the "as constructed" information contained in this drawing; and
 # acknowledge the "as constructed" information contained in the drawing may be relied on by the Moreton Bay Regional Council and others.
 Certification for Stage 20A by D.H.F. on 28/06/18
 For: Empower Engineers & Project Managers RPEQ 5694

LEGEND

5.4 ——— AS CONSTRUCTED CONTOURS
 (Interval 0.2m)

————— RETAINING WALL

Registered Surveyor's Certification.
 We, Veris Australia Pty Ltd hereby certify that the horizontal and vertical locations, and dimensions shown on this plan are a true and correct record of the As Constructed information.
 Signed: [Signature] Cadastral Surveyor & Delegate, Reg. No. 6448 Dated: 29/06/2018

DRAWING REVISIONS		REFERENCE DRAWINGS		DESIGN FILE No.	DESIGNED		BRISBANE (07) 366 4700 MACKAY (07) 4621 2911 PROSERPINE (07) 4645 1732 CAIRNS (07) 4631 6722 veris.com.au ACN 604 671 374 Queensland Surveying Pty Ltd, a Veris Company		MORETON BAY REGIONAL COUNCIL CABOOLTURE DISTRICT OFFICE 2 HASKING STREET CABOOLTURE QLD 4510 PO BOX 159 CABOOLTURE QLD 4510 Telephone: (07) 5433 0100 Fax: (07) 5433 4000	STAGE 20A, CAPESTONE AS CONSTRUCTED EARTHWORKS		MBRC SUBDIVISION REFERENCE	
REV.	REVISION DESCRIPTION	DRG. No.	DESCRIPTION	CONSTRUCT. No.	DATE					SCALE 1:500	ORIGINAL SIZE A1	No. 2 OF 2 PLANS	DRAWING NUMBER
A	Progress Plot			30105-20A100 AE	14/06/2018				30105-20A100 AE	A			