


ENGINEER'S CERTIFICATION
 I, DARRYL HAYTER
 being a Consulting Engineer and duly authorised representative of:
Empower Engineers & Project Managers
 hereby:
 # certify the information contained in this drawing is an accurate "as constructed" representation of the works;
 # accept responsibility for the "as constructed" information contained in this drawing; and
 # acknowledge the "as constructed" information contained in the drawing may be relied on by the Moreton Bay Regional Council and others.
 Certification for Stage 20A by D.H. on 28/06/18
 For: Empower Engineers & Project Managers RPEQ 5694

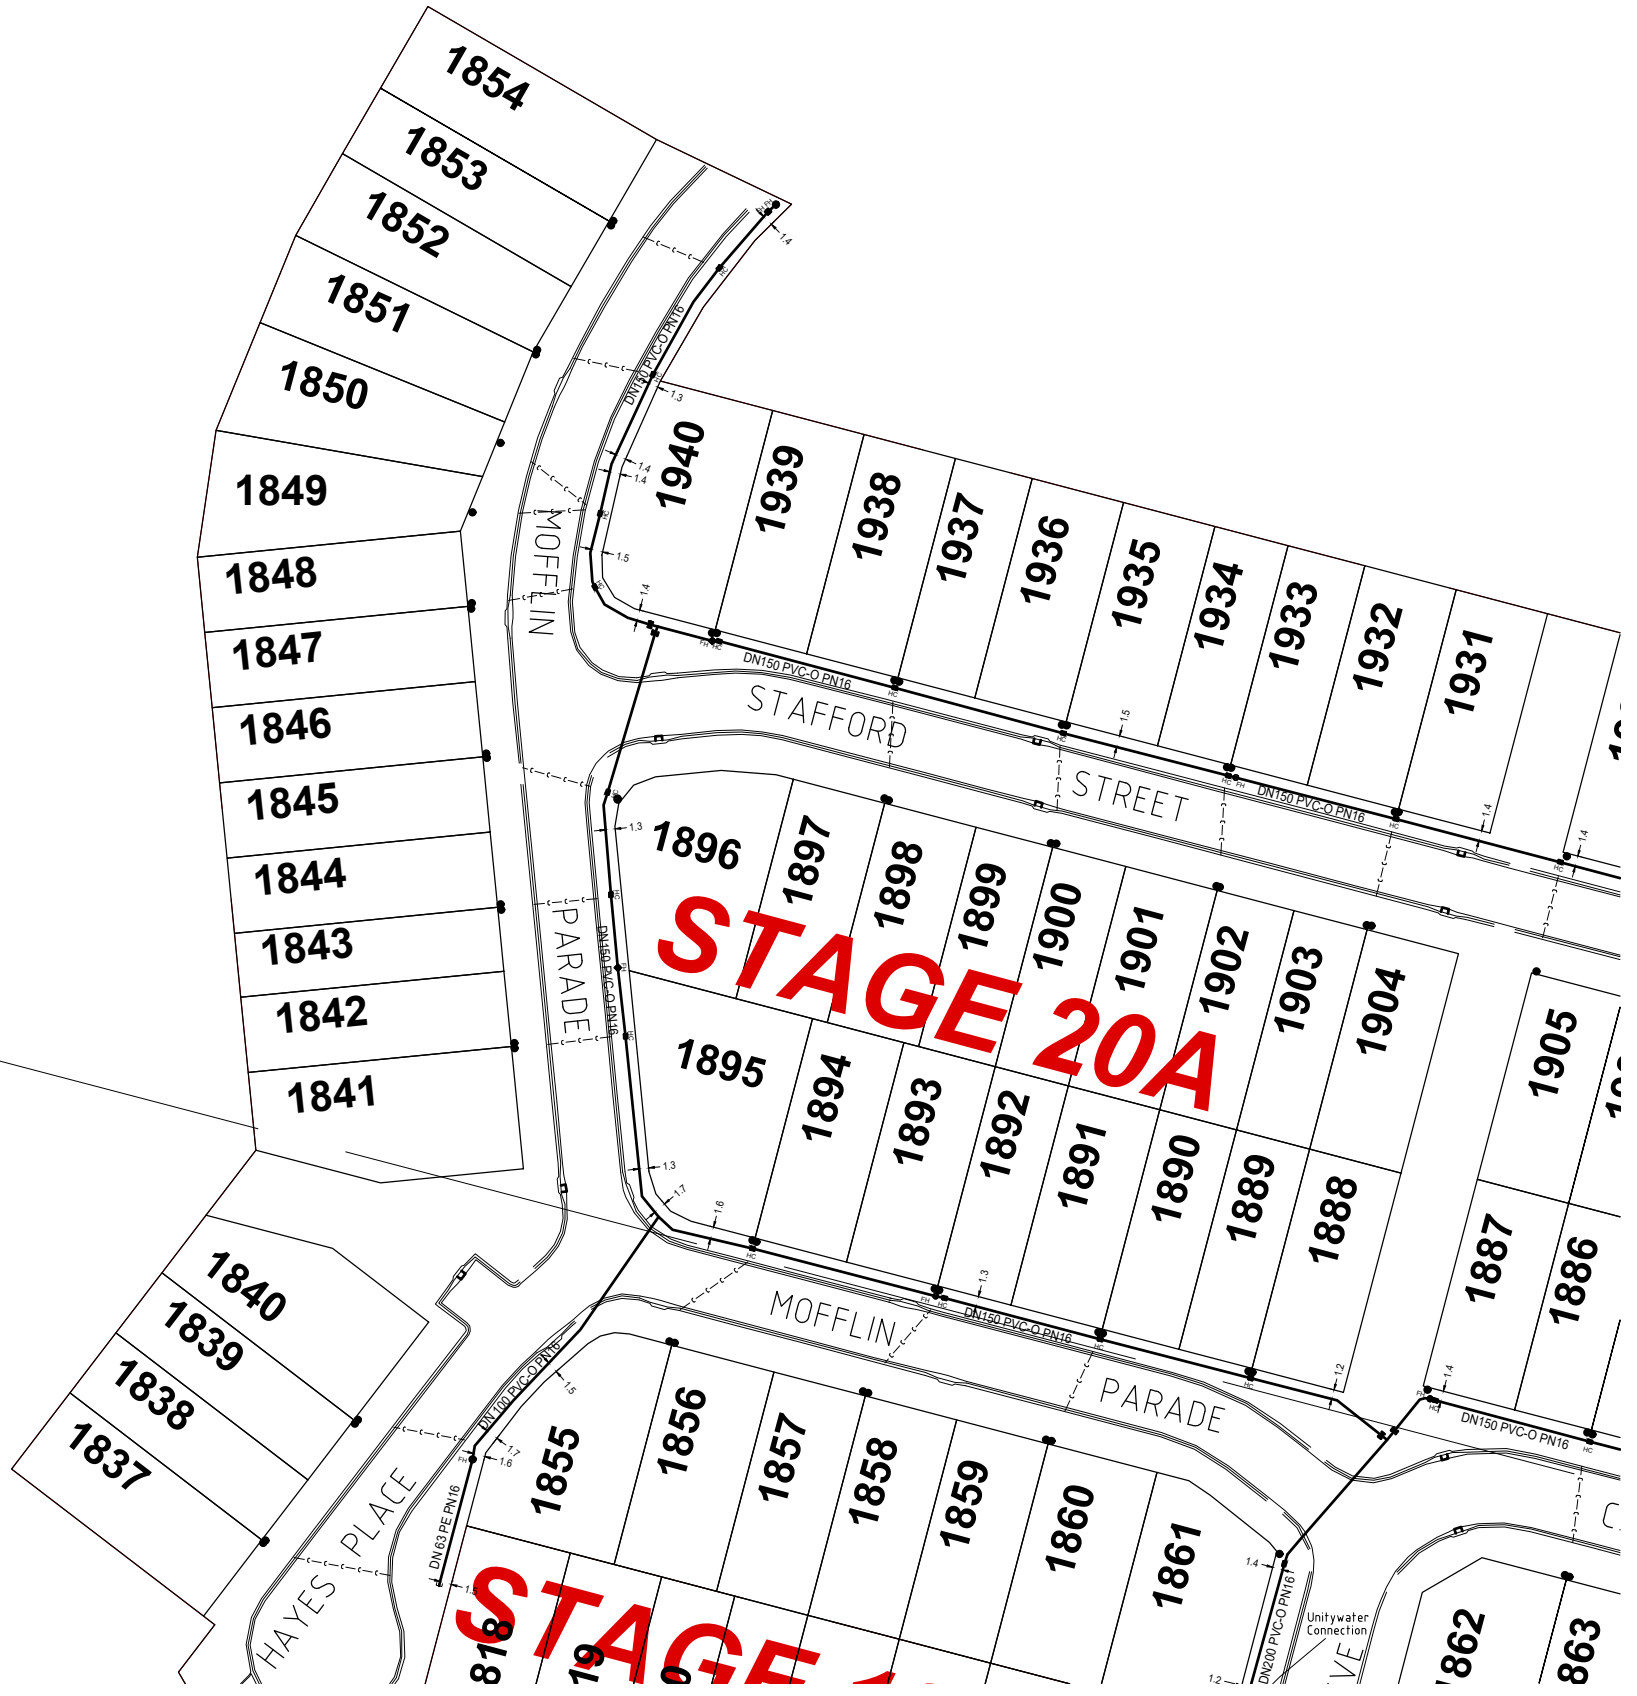

Registered Surveyor's certification
 We, QUEENSLAND SURVEYING PTY LTD, hereby certify that the vertical and horizontal locations, and dimensions shown on this plan are a true and correct record and were located by survey.
R. A. King 6152 21/06/2018
 Delegate Cadastral Surveyor Date

LEGEND

- New Hydrant
- New Isolation Valve
- New End Cap
- New Scour Valve
- New Taper
- New Water Service Conduit (Ø100 uPVC PN9)
- New Water Meter
- New Water House connection

NOTES:
 • All mains DN150 PVC-O PN16 unless noted otherwise.

COORDINATE DATUM NOTE:
 HORIZONTAL COORDINATES(E,N) SUPPLIED ARE MAPPING GRID OF AUSTRALIA(MGA), ZONE 56 BASED ON THE UNIVERSAL TRANSVERSE MERCATOR PROJECTION AND THE GEOCENTRIC DATUM OF AUSTRALIA 1994.
 HORIZONTAL DATUM DERIVED FROM PSM186710, E 503315 600, N 6987236.028.
 LEVELS SUPPLIED ARE ON THE AUSTRALIAN HEIGHT DATUM(AHD)
 LEVEL DATUM DERIVED FROM PSM177891 RL 16.396 (AHD)

A1	INDEX	DATE	ORIGINAL	REVISIONS	DRAWN	CHECKED	PASSED	INITIALS	DATE	 <small>BRISBANE 071 308 4700 MACKAY 071 4051 2911 PROSERPINE 071 4051 7122 CARNS 071 4051 6722 veris.com.au ACN 804 671 374 Queensland Surveying Pty Ltd, a Veris Company</small>	 Unitywater	Unitywater <small>2017009844</small> STAGE 20A CAPESTONE ESTATE KINSELLES ROAD EAST, MANGO HILL AS-CONSTRUCTED WATER	SHEET 1 OF 2 SHEETS	SCALE 1:500
	A	21/06/2018	ORIGINAL		JMc	JMc								REVISION DATE 21/06/2018



Registered Surveyor's certification
 We, QUEENSLAND SURVEYING PTY LTD, hereby certify that the vertical and horizontal locations, and dimensions shown on this plan are a true and correct record and were located by survey.
 Delegate Cadastral Surveyor 6152 21/06/2018 Date

- LEGEND**
- New Hydrant
 - New Isolation Valve
 - New End Cap
 - New Scour Valve
 - New Taper
 - New Water Service Conduit (Ø100 uPVC PN9)
 - New Water Meter
 - New Water House connection

NOTES:
 • All mains DN150 PVC-0 PN16 unless noted otherwise.

COORDINATE DATUM NOTE:
 HORIZONTAL COORDINATES(E,N) SUPPLIED ARE MAPPING GRID OF AUSTRALIA(MGA), ZONE 56 BASED ON THE UNIVERSAL TRANSVERSE MERCATOR PROJECTION AND THE GEOCENTRIC DATUM OF AUSTRALIA 1994.
 HORIZONTAL DATUM DERIVED FROM PSM186710, E 503315 600, N 6987236.028.
 LEVELS SUPPLIED ARE ON THE AUSTRALIAN HEIGHT DATUM(AHD)
 LEVEL DATUM DERIVED FROM PSM177891 RL 16.396 (AHD)

ENGINEER'S CERTIFICATION
 I, DARRYL HAYTER
 being a Consulting Engineer and duly authorised representative of: -
 Empower Engineers & Project Managers
 hereby:-
 # certify the information contained in this drawing is an accurate "as constructed" representation of the works;
 # accept responsibility for the "as constructed" information contained in this drawing; and
 # acknowledge the "as constructed" information contained in the drawing may be relied on by the Moreton Bay Regional Council and others.
 Certification for Stage 20A by D.H. on 28/06/18
 For: Empower Engineers & Project Managers RPEQ 5694

A1	A	21/06/2018	ORIGINAL	JMc	JMc		DRAWN	JMc	21/06/2018
	INDEX	DATE	REVISIONS	DRAWN	CHECKED	PASSED	INITIALS	DATE	



BRISBANE 07 306 4300
 MACKAY 07 4651 2911
 PROSERPINE 07 4651 7122
 CAIRNS 07 4651 6722
 veris.com.au
 ACN 804 671 374
 Queensland Surveying Pty Ltd a Veris Company



Unitywater
 2017009844
 STAGE 20A CAPESTONE ESTATE
 KINSELLES ROAD EAST, MANGO HILL
 AS-CONSTRUCTED WATER

SHEET 2 OF 2 SHEETS	SCALE 1:500
REVISION DATE 21/06/2018	REVISION A
DISCIPLINE CODE C	
DRAWING NO. U-2018-STG20A-AW(A)	