

Registered Surveyor's Certification.

We, Veris Australia Pty Ltd, hereby certify that the horizontal and vertical locations, and dimensions shown on this plan are a true and correct record of the As Constructed information.

Signed: *[Signature]* Cadastral Surveyor & Delegate, Reg. No. 6448, Dated 30/01/2019



**ENGINEER'S CERTIFICATION**

I, DARRYL HAYTER, being a Consulting Engineer and duly authorised representative of: Empower Engineers & Project Managers hereby:-

- certify the information contained in this drawing is an accurate "as constructed" representation of the works;
- accept responsibility for the "as constructed" information contained in this drawing; and
- acknowledge the "as constructed" information contained in the drawing may be relied on by the Moreton Bay Regional Council and others.

Certification for Stage 12B by *[Signature]* on 04/02/19


For: Empower Engineers & Project Managers RPEQ 5694

**LEGEND**

6.2 — AS CONSTRUCTED CONTOURS (Interval 0.2m)

— RETAINING WALL

<b>DRAWING REVISIONS</b> REV. REVISION DESCRIPTION A Progress Plot		<b>REFERENCE DRAWINGS</b> DRG. No. DESCRIPTION		<b>DESIGN FILE No.</b> CONSTRUCT. No. SURVEY FILE No. 30105-12B100 AE FIELD BOOK LOG BOOK LEVEL DATUM DATUM		<b>DESIGNED</b> DATE DRAWN JMc DATE 30/01/2019 CHECKED JMc DATE 30/01/2019		BRISBANE (07) 3666 4700 MACKAY (07) 9381 2811 VERIS.com.au ACN 604 671 374 Queensland Surveying Pty Ltd a Veris Company		<b>MORETON BAY REGIONAL COUNCIL</b> CABOOLTURE DISTRICT OFFICE 2 HASKING STREET CABOOLTURE QLD 4510 Telephone: (07) 5433 0100 Fax: (07) 5433 4000		<b>STAGE 12B, CAPESTONE AS CONSTRUCTED EARTHWORKS</b>		<b>MBRC SUBDIVISION REFERENCE</b> DA/30479/2015/V23R No. 1 OF 2 PLANS <b>DRAWING NUMBER</b> REV. 30105-12B100 AE A	
SCALE 1:500				ORIGINAL SIZE A1											

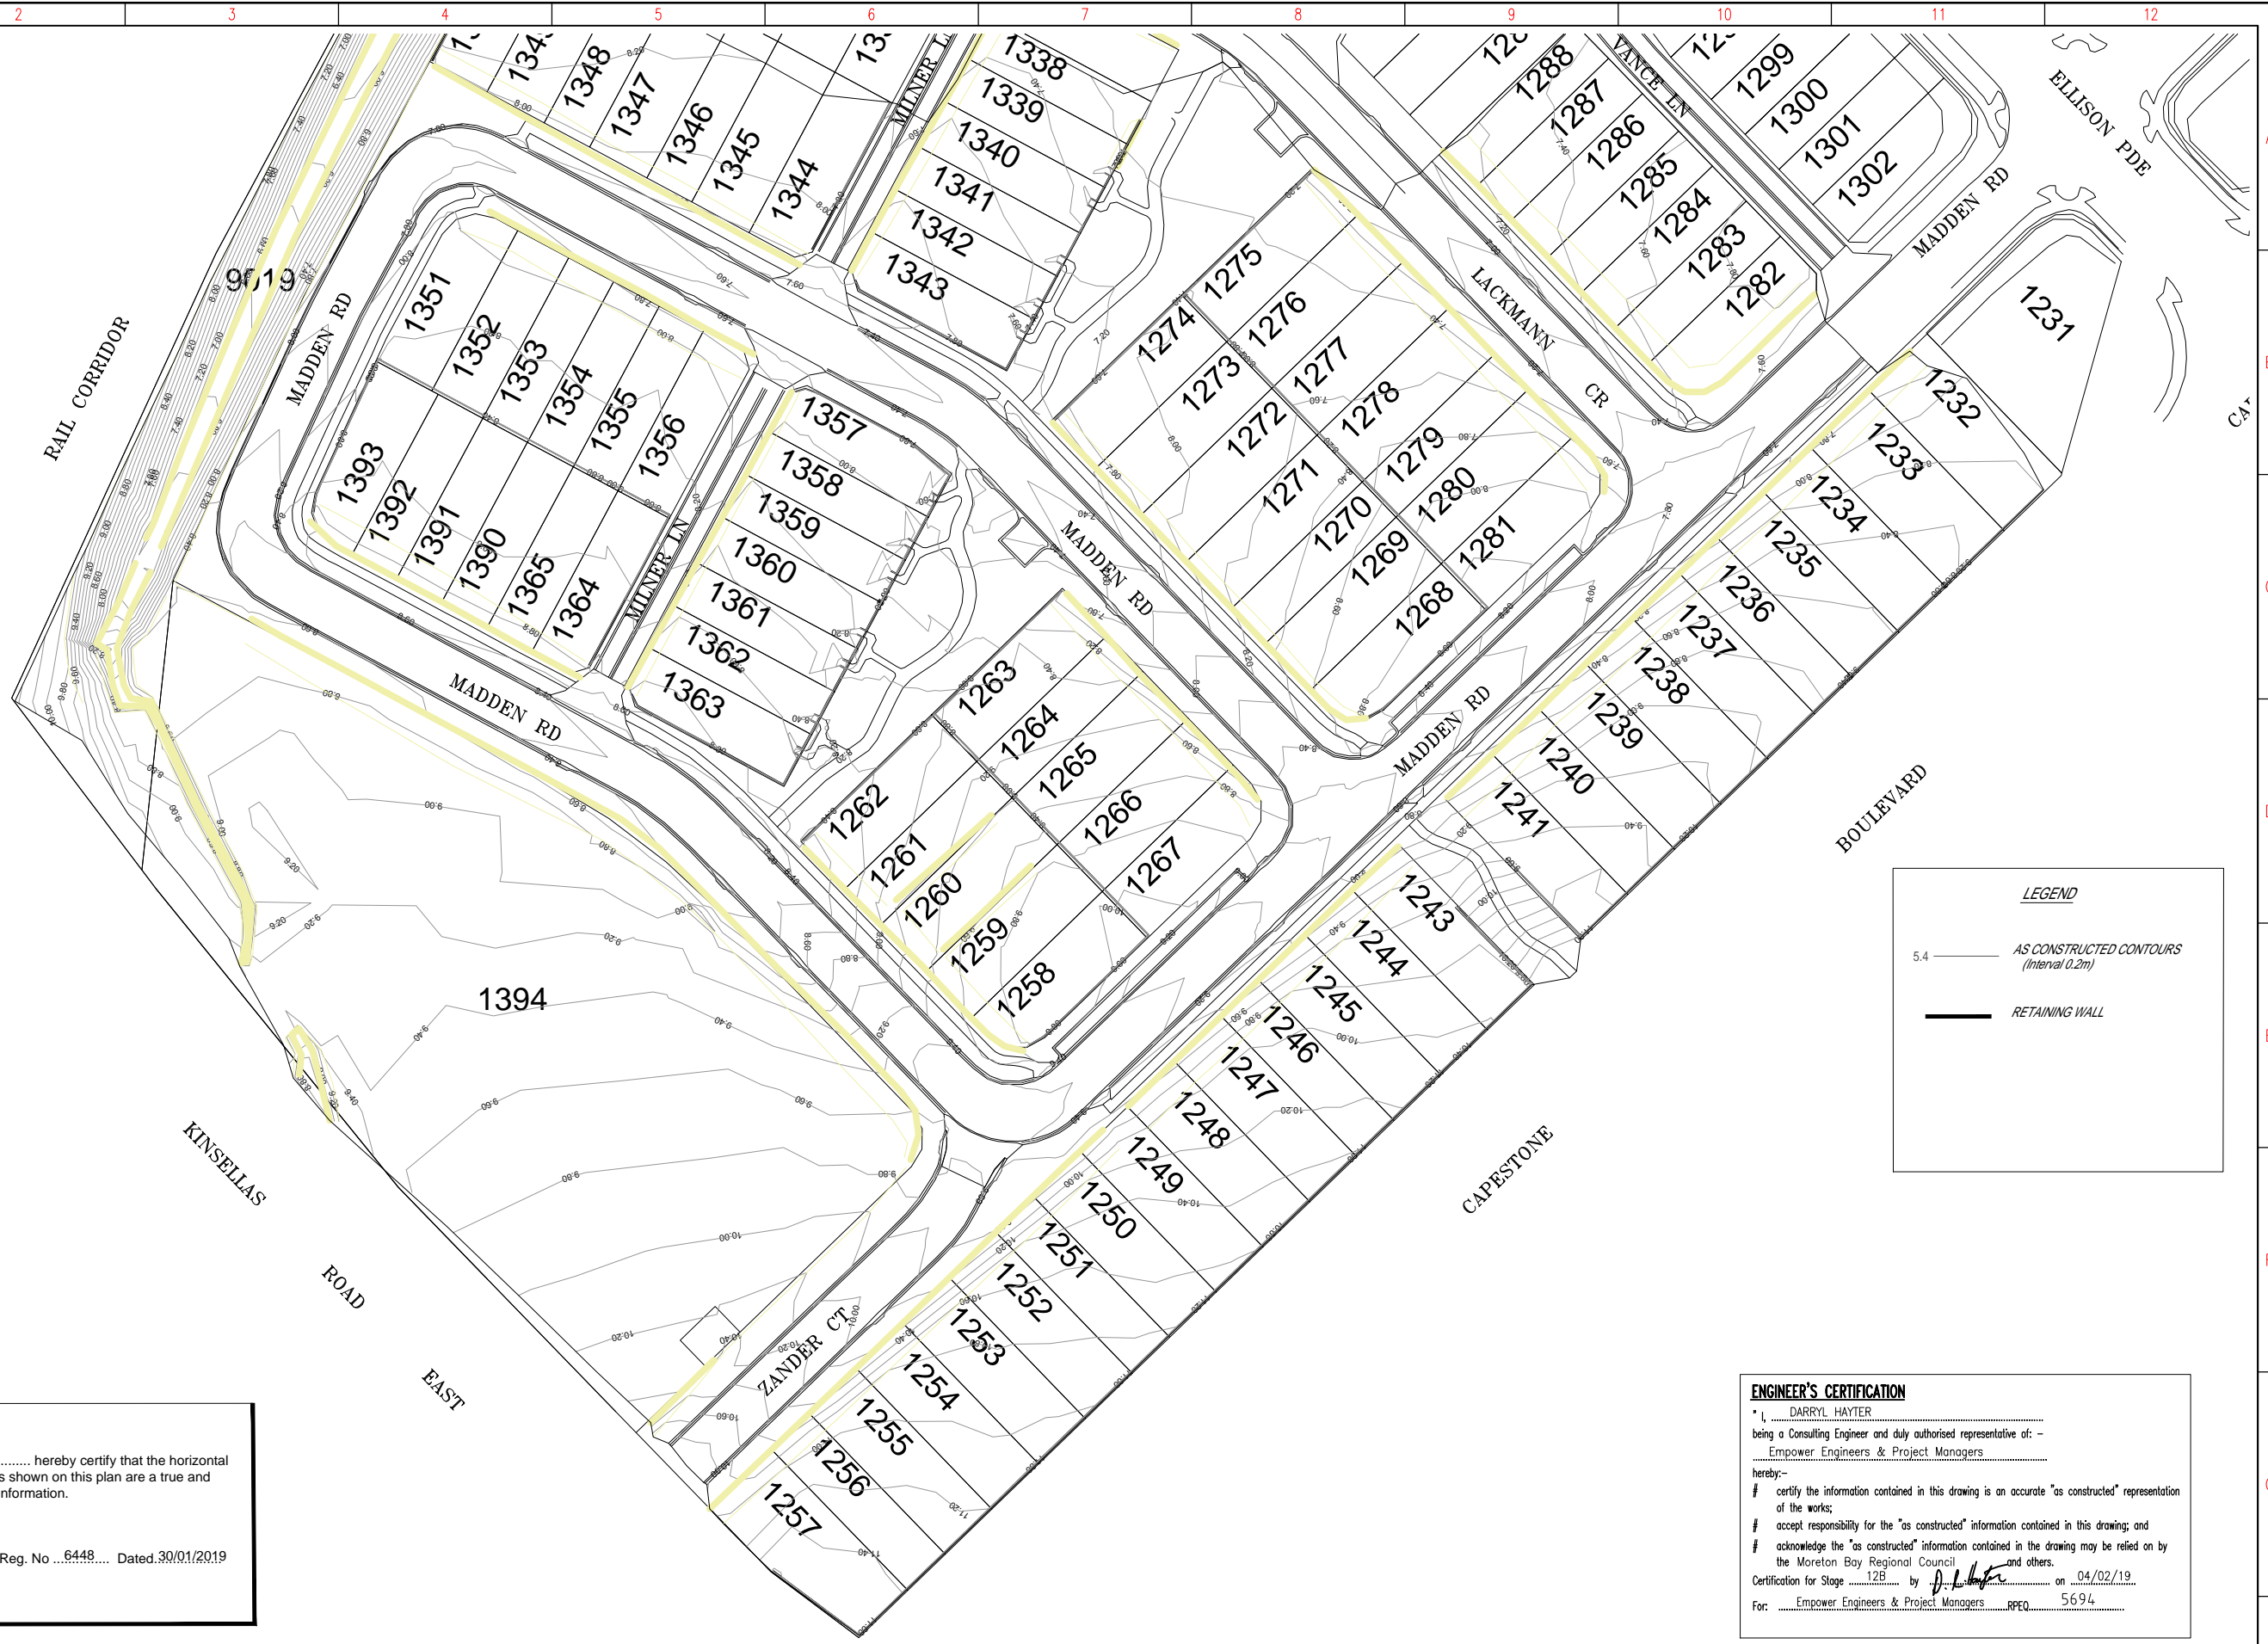

**LEGEND**

5.4 — AS CONSTRUCTED CONTOURS  
(Interval 0.2m)

— RETAINING WALL

Registered Surveyor's Certification.

We, Veris Australia Pty Ltd hereby certify that the horizontal and vertical locations, and dimensions shown on this plan are a true and correct record of the As Constructed information.

Signed: *[Signature]* Cadastral Surveyor & Delegate, Reg. No. 6448, Dated 30/01/2019

**ENGINEER'S CERTIFICATION**

I, DARRYL HAYTER being a Consulting Engineer and duly authorised representative of: Empower Engineers & Project Managers hereby:-

- certify the information contained in this drawing is an accurate "as constructed" representation of the works;
- accept responsibility for the "as constructed" information contained in this drawing; and
- acknowledge the "as constructed" information contained in the drawing may be relied on by the Moreton Bay Regional Council and others.

Certification for Stage 12B by *[Signature]* on 04/02/19

For: Empower Engineers & Project Managers RPEQ 5694

DRAWING REVISIONS		REFERENCE DRAWINGS		DESIGN FILE No.	DESIGNED	BRISBANE 075 3684 4700 MACKAY 075 4551 2911	PROSERPINE 071 446 1122 CAIRNS 071 4551 6222		<b>MORETON BAY REGIONAL COUNCIL</b> CABOOLTURE DISTRICT OFFICE 2 HASKING STREET CABOOLTURE QLD 4510 PO BOX 159 CABOOLTURE QLD 4510 Telephone: (07) 5433 0100 Fax: (07) 5433 4000	MBRC SUBDIVISION REFERENCE	
REV.	REVISION DESCRIPTION	DRG. No.	DESCRIPTION	CONSTRUCT. No.	DATE					DA/30479/2015/V23R	No. 2 OF 2 PLANS
A	Progress Plot			30105-12B100 AE	JMc 30/01/2019					DRAWING NUMBER	REV.
				FIELD BOOK	JMc 30/01/2019					30105-12B100 AE	A
				LOG BOOK							
				LEVEL DATUM	AHD						
				DATUM	PM177891						
						SCALE 1:500	ORIGINAL SIZE A1				