


Registered Surveyor's certification
We, VERIS AUSTRALIA Pty Ltd, hereby certify that the vertical and horizontal locations, and dimensions shown on this plan are a true and correct record and were located by survey.

6448 24/01/2019

Delegate Cadastral Surveyor Date

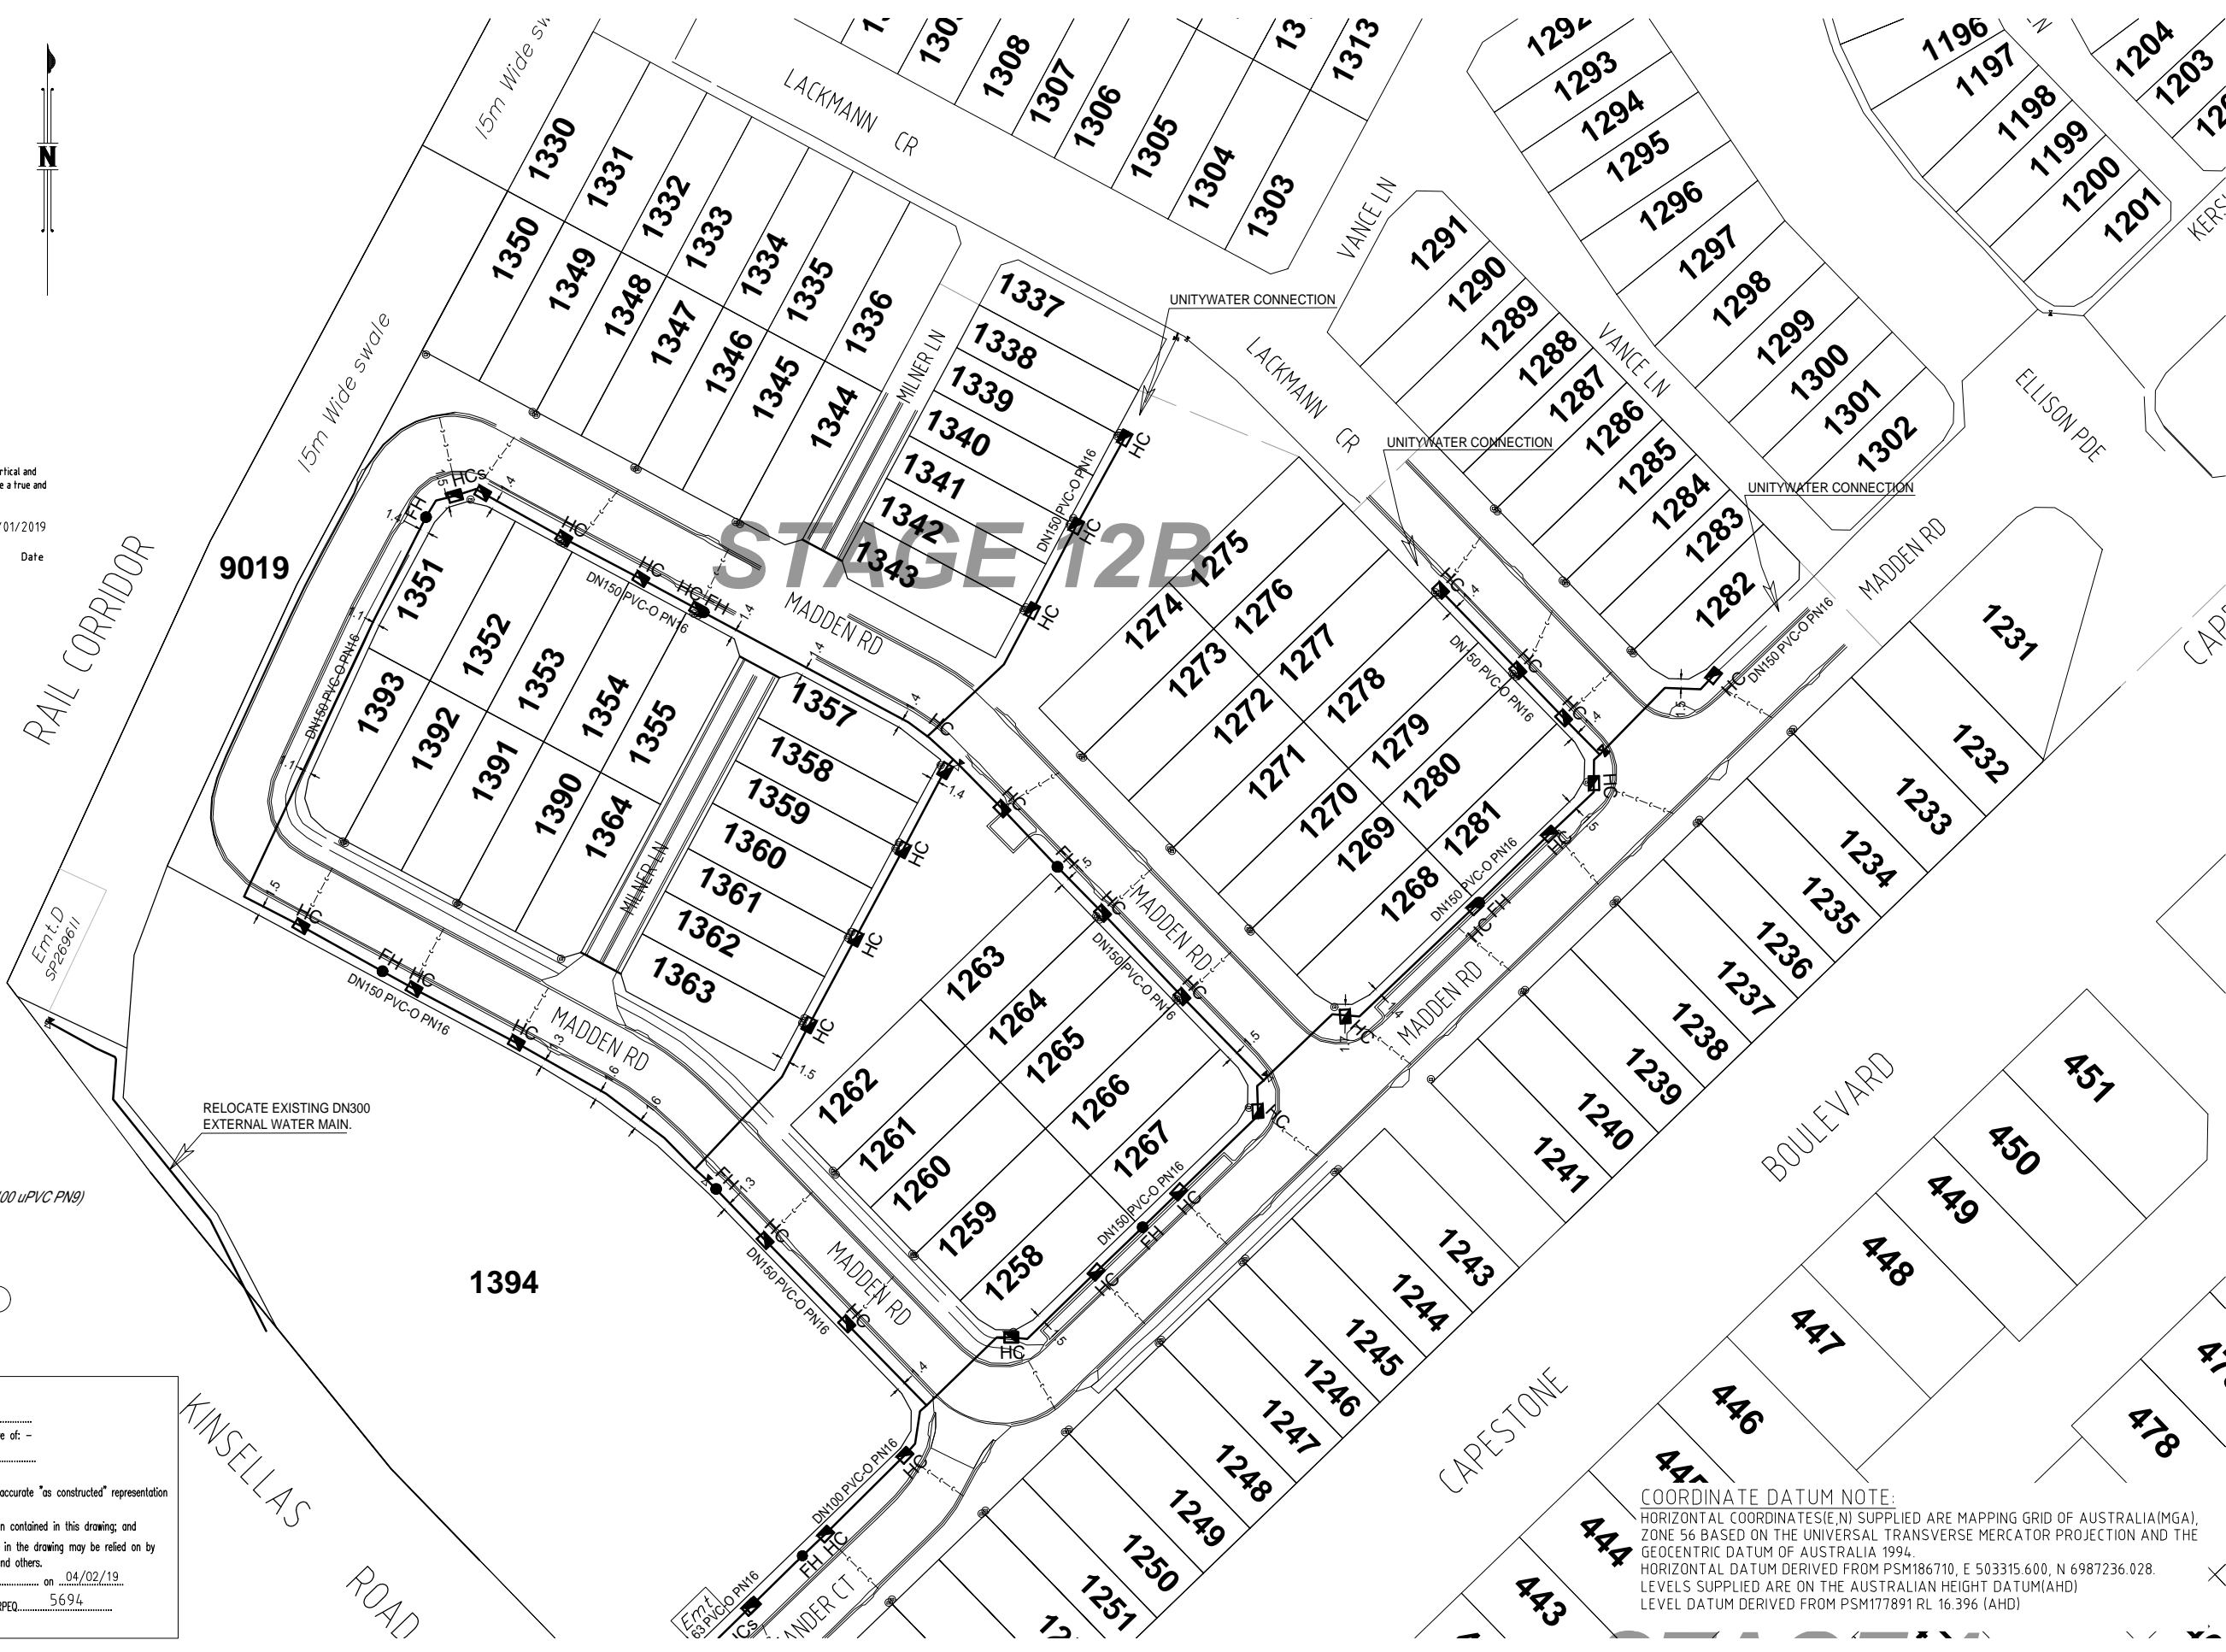

- LEGEND**
- New Hydrant
 - New Isolation Valve
 - New End Cap
 - New Scour Valve
 - New Taper
 - New Water Service Conduit (Ø100 uPVC PN9)
 - New Water Meter
 - New Water House connection

PM186710

NOTES:
• All mains DN150 PVC-O PN16 unless noted otherwise.

ENGINEER'S CERTIFICATION

I, DARRYL HAYTER
being a Consulting Engineer and duly authorised representative of: -
Empower Engineers & Project Managers
hereby:-
certify the information contained in this drawing is an accurate "as constructed" representation of the works;
accept responsibility for the "as constructed" information contained in this drawing; and
acknowledge the "as constructed" information contained in the drawing may be relied on by the Moreton Bay Regional Council and others.
Certification for Stage 12B by [Signature] on 04/02/19
For: Empower Engineers & Project Managers RPEQ 5694

COORDINATE DATUM NOTE:
HORIZONTAL COORDINATES(E,N) SUPPLIED ARE MAPPING GRID OF AUSTRALIA(MGA), ZONE 56 BASED ON THE UNIVERSAL TRANSVERSE MERCATOR PROJECTION AND THE GEOCENTRIC DATUM OF AUSTRALIA 1994.
HORIZONTAL DATUM DERIVED FROM PSM186710, E 503315.600, N 6987236.028.
LEVELS SUPPLIED ARE ON THE AUSTRALIAN HEIGHT DATUM(AHD)
LEVEL DATUM DERIVED FROM PSM177891 RL 16.396 (AHD)

A1

INDEX	DATE	ORIGINAL	REVISIONS	DRAWN	CHECKED	PASSED
A	24/01/2019	ORIGINAL		JMc	JMc	

PASSED	INITIALS	DATE
	JMc	24/01/2019
	JMc	24/01/2019



BRISBANE PROSERPINE
(07) 3888 4700 (07) 4046 1722
MACKAY CAIRNS
(07) 5481 2011 (07) 4046 9722
veris.com.au
ACN 604 671 374
Queensland Surveying Pty Ltd, a Veris Company



Unitywater

2018012900-01
STAGE 12B CAPESTONE ESTATE
KINSELLAS ROAD EAST, MANGO HILL
AS-CONSTRUCTED WATER

SHEET 1 OF 2 SHEETS	SCALE 1:500
REVISION DATE 24/01/2019	REVISION A
DISCIPLINE CODE C	
DRAWING NO. U-2018-0850 AW	

