

ENGINEER'S CERTIFICATION
 I, DARRYL HAYTER
 being a Consulting Engineer and duly authorised representative of: -
EMPOWER ENGINEERS & PROJECT MANAGERS Pty Ltd
 hereby:-
 # certify the information contained in this drawing is an accurate "as constructed" representation of the works;
 # accept responsibility for the "as constructed" information contained in this drawing; and
 # acknowledge the "as constructed" information contained in the drawing may be relied on by the MORETON BAY REGIONAL COUNCIL and others.
 Certification for Stage 20B by D.H.F. on 23/05/19.
 For: EMPOWER ENGINEERS & PROJECT MANAGERS Pty Ltd
 RPEQ No: 5694

Registered Surveyor's certification
 We, VERIS AUSTRALIA Pty Ltd, hereby certify that the vertical and horizontal locations, and dimensions shown on this plan are a true and correct record and were located by survey.
D.H.F. 6448 22/05/2019
 Delegate Cadastral Surveyor Date



STAGE 18A
STAGE 20B
STAGE 20A

- LEGEND**
- NEW HYDRANT
 - NEW SLUICE VALVE
 - NEW TEE
 - NEW END CAP
 - NEW TAPER
 - CONDUIT
 - NEW WATER SERVICE CONDUIT (ø100 oPVC PN16)
 - NEW WATER SERVICE (ø25 DI)
 - NEW WATER METER
 - NEW WATER HOUSE CONNECTION
 - EXISTING HYDRANT
 - EXISTING SLUICE VALVE
 - EXISTING TEE
 - EXISTING WATER MAIN

COORDINATE DATUM NOTE:
 HORIZONTAL COORDINATES(E,N) SUPPLIED ARE MAPPING GRID OF AUSTRALIA(MGA), ZONE 56 BASED ON THE UNIVERSAL TRANSVERSE MERCATOR PROJECTION AND THE GEOCENTRIC DATUM OF AUSTRALIA 1994.
 HORIZONTAL DATUM DERIVED FROM PSM186710, E 503315 600, N 6987236.028.
 LEVELS SUPPLIED ARE ON THE AUSTRALIAN HEIGHT DATUM(AHD)
 LEVEL DATUM DERIVED FROM PSM177891 RL 16.396 (AHD)

A1	INDEX	DATE	ORIGINAL	REVISIONS	DRAWN	CHECKED	PASSED	DRAWN	CHECKED	PASSED	INITIALS	DATE
	A	20/02/2019	ORIGINAL		JMc	JMc		JMc	JMc			20/02/2019




BRISBANE (07) 396 4332
 MACKAY (07) 4651 2011
 PROSERPINE (07) 4661 1122
 CARNS (07) 4651 6722
 veris.com.au
 ACN 604 671 374
 Queensland Surveying Pty Ltd & Veris Company



Unitywater
 2018012582
 STAGE 20B CAPESTONE ESTATE
 KINSELLES ROAD EAST, MANGO HILL
 AS-CONSTRUCTED WATER

SHEET 1 OF 2 SHEETS	SCALE 1500
REVISION DATE 20/02/2019	REVISION A
DISCIPLINE CODE C	
DRAWING NO. U-2018-0916 AW	

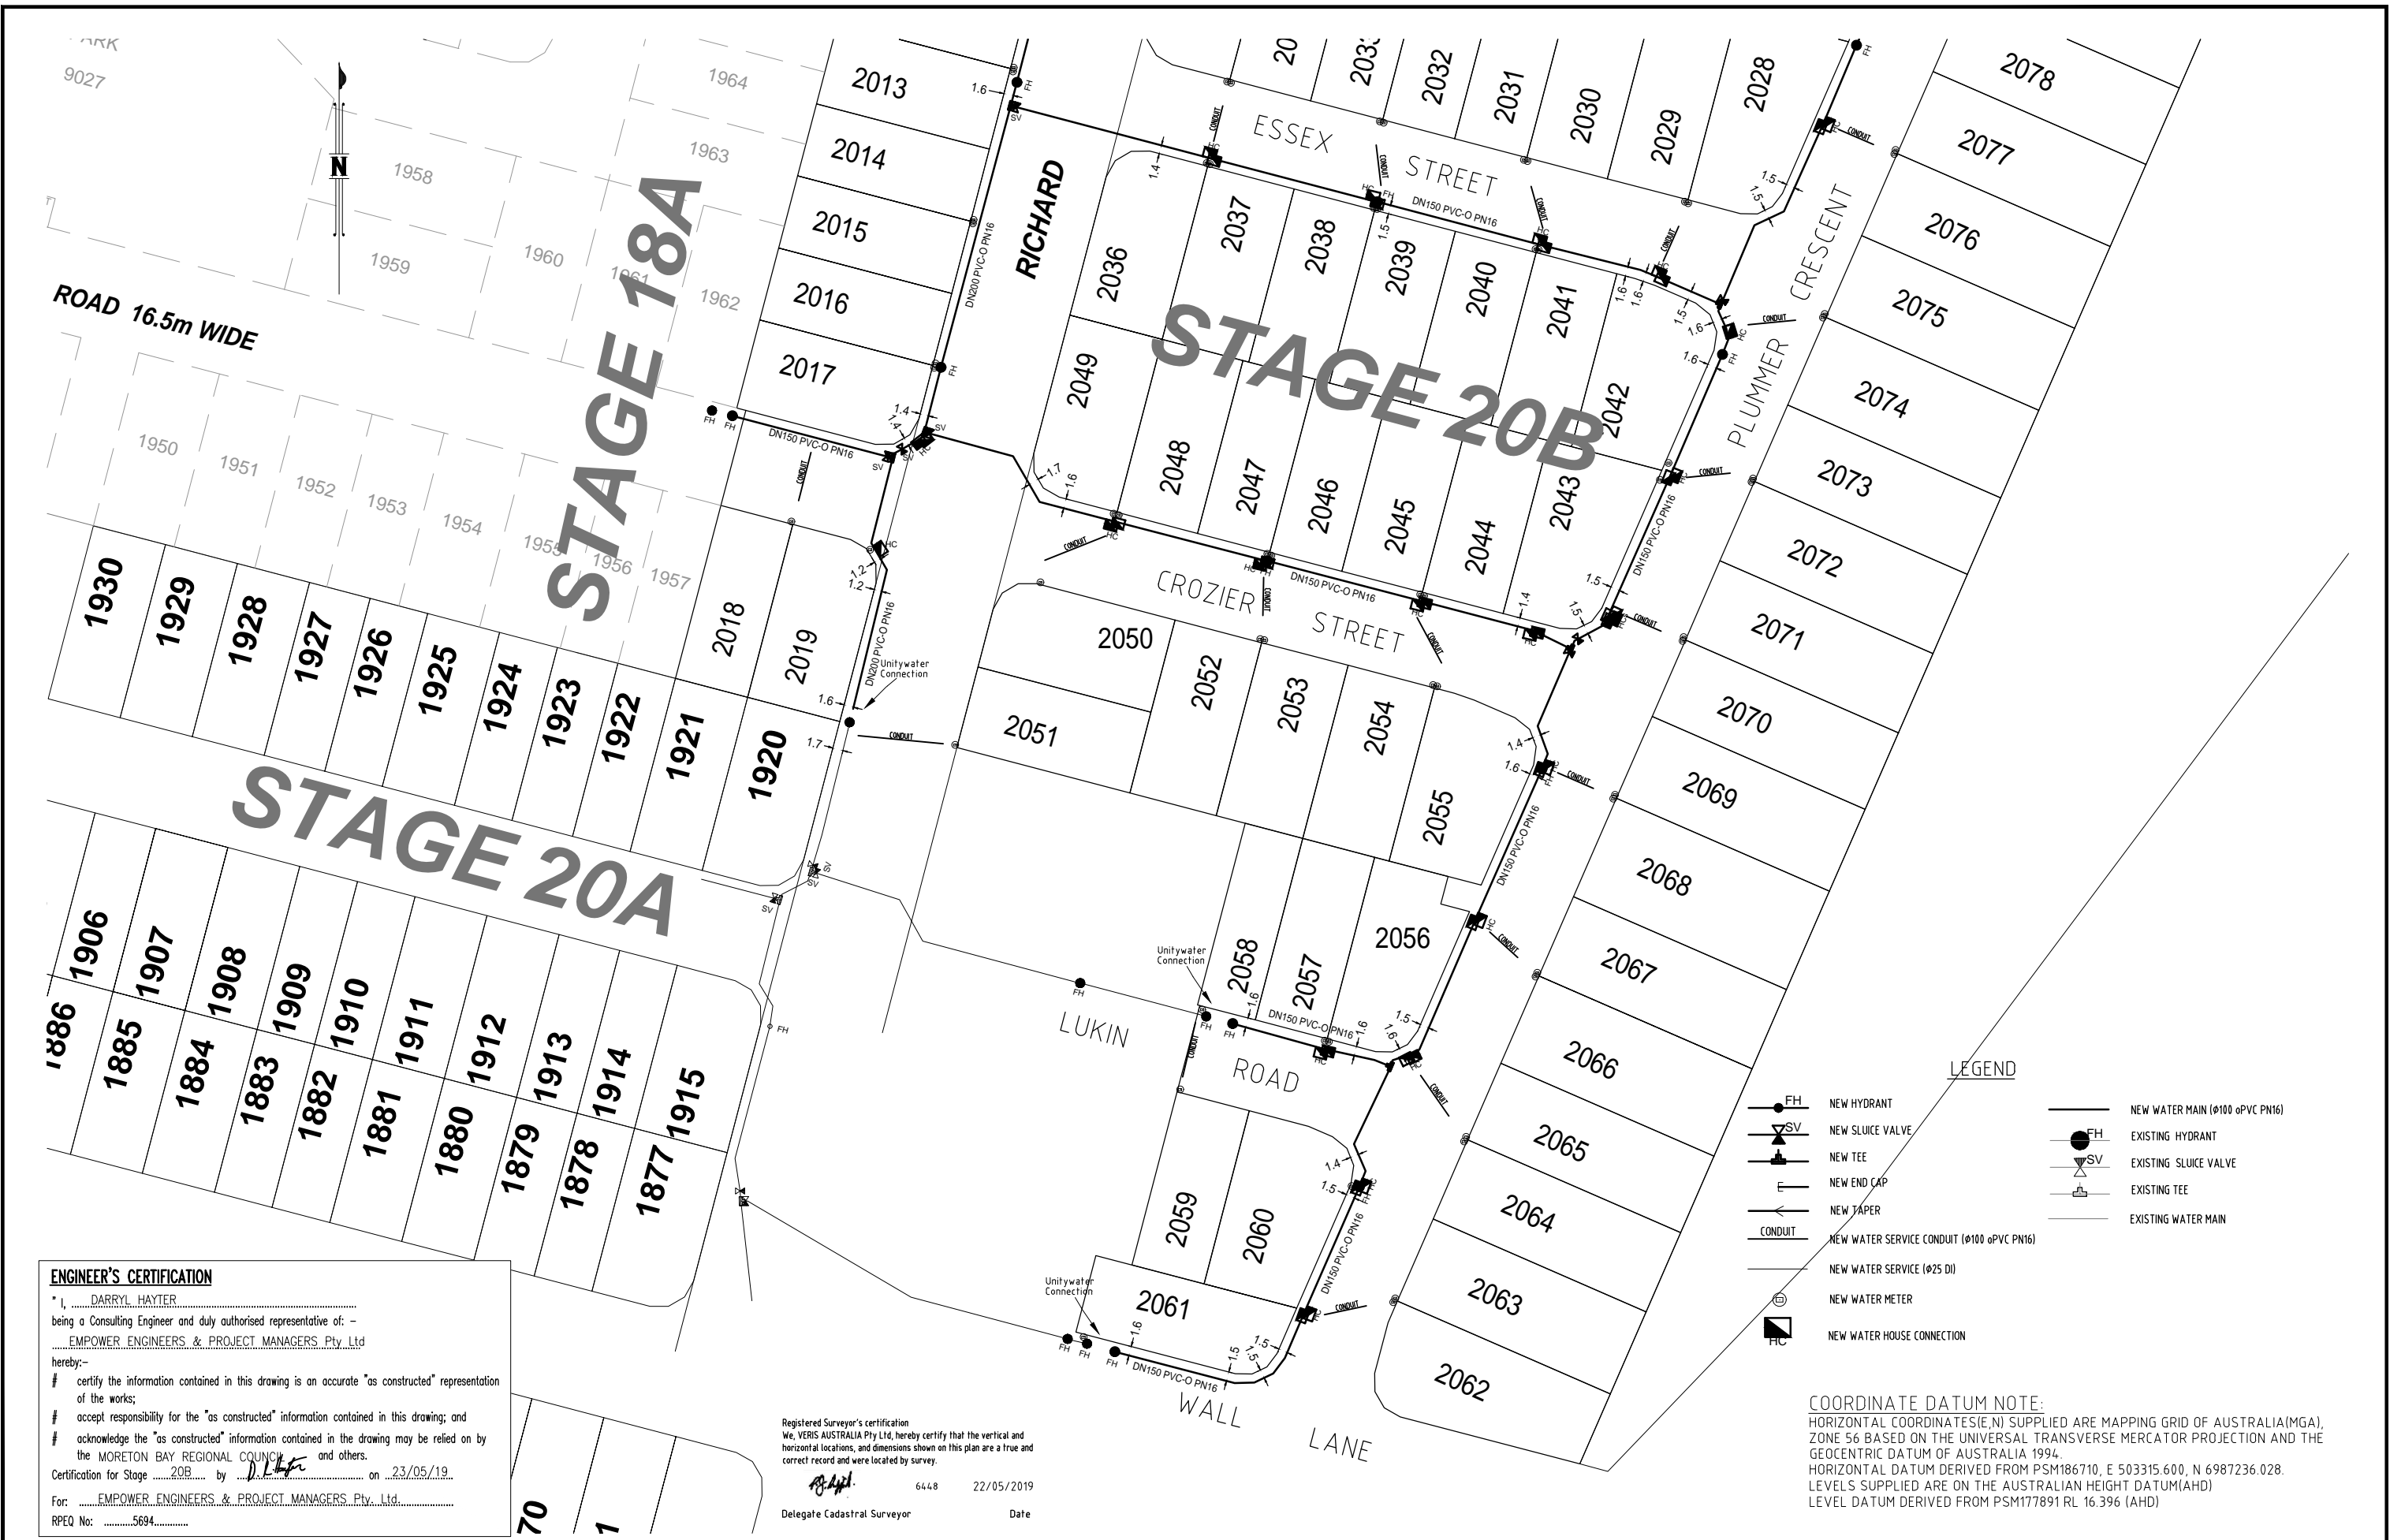

LEGEND

- NEW HYDRANT
- NEW SLUICE VALVE
- NEW TEE
- NEW END CAP
- NEW TAPER
- NEW WATER SERVICE CONDUIT (Ø100 oPVC PN16)
- NEW WATER SERVICE (Ø25 DI)
- NEW WATER METER
- NEW WATER HOUSE CONNECTION
- EXISTING HYDRANT
- EXISTING SLUICE VALVE
- EXISTING TEE
- EXISTING WATER MAIN

COORDINATE DATUM NOTE:
 HORIZONTAL COORDINATES(E,N) SUPPLIED ARE MAPPING GRID OF AUSTRALIA(MGA), ZONE 56 BASED ON THE UNIVERSAL TRANSVERSE MERCATOR PROJECTION AND THE GEOCENTRIC DATUM OF AUSTRALIA 1994.
 HORIZONTAL DATUM DERIVED FROM PSM186710, E 503315 600, N 6987236.028.
 LEVELS SUPPLIED ARE ON THE AUSTRALIAN HEIGHT DATUM(AHD)
 LEVEL DATUM DERIVED FROM PSM177891 RL 16.396 (AHD)

Registered Surveyor's certification
 We, VERIS AUSTRALIA Pty Ltd, hereby certify that the vertical and horizontal locations, and dimensions shown on this plan are a true and correct record and were located by survey.
 6448 22/05/2019
 Delegate Cadastral Surveyor Date

ENGINEER'S CERTIFICATION
 I, DARRYL HAYTER
 being a Consulting Engineer and duly authorised representative of: -
EMPOWER ENGINEERS & PROJECT MANAGERS Pty Ltd
 hereby:-
 # certify the information contained in this drawing is an accurate "as constructed" representation of the works;
 # accept responsibility for the "as constructed" information contained in this drawing; and
 # acknowledge the "as constructed" information contained in the drawing may be relied on by the MORETON BAY REGIONAL COUNCIL and others.
 Certification for Stage 20B by D.H. on 23/05/19
 For: EMPOWER ENGINEERS & PROJECT MANAGERS Pty. Ltd.
 RPEQ No: 5694

A1	INDEX	DATE	ORIGINAL	REVISIONS	DRAWN	CHECKED	PASSED
	A	20/02/2019	ORIGINAL		JMc	JMc	

DRAWN	JMc	20/02/2019
CHECKED	JMc	20/02/2019
PASSED		
INITIALS		DATE

BRISBANE (07) 398 4300
 MACKAY (07) 4651 2011
 PROSERPINE (07) 4961 1122
 CARNS (07) 4591 8722
 veris.com.au
 ACN 604 671 374
 Queensland Surveying Pty Ltd & Veris Company



Unitywater
 201802582
 STAGE 20B CAPESTONE ESTATE
 KINSELLES ROAD EAST, MANGO HILL
 AS-CONSTRUCTED WATER

SHEET 2 OF 2 SHEETS	SCALE 1500
REVISION DATE 20/02/2019	REVISION A
DISCIPLINE CODE C	
DRAWING NO. U-2018-0916 AW	