


Registered Surveyor's certification  
 We, VERIS AUSTRALIA Pty Ltd, hereby certify that the vertical and horizontal locations, and dimensions shown on this plan are a true and correct record and were located by survey.

6448 22/05/2019  
 Delegate Cadastral Surveyor Date

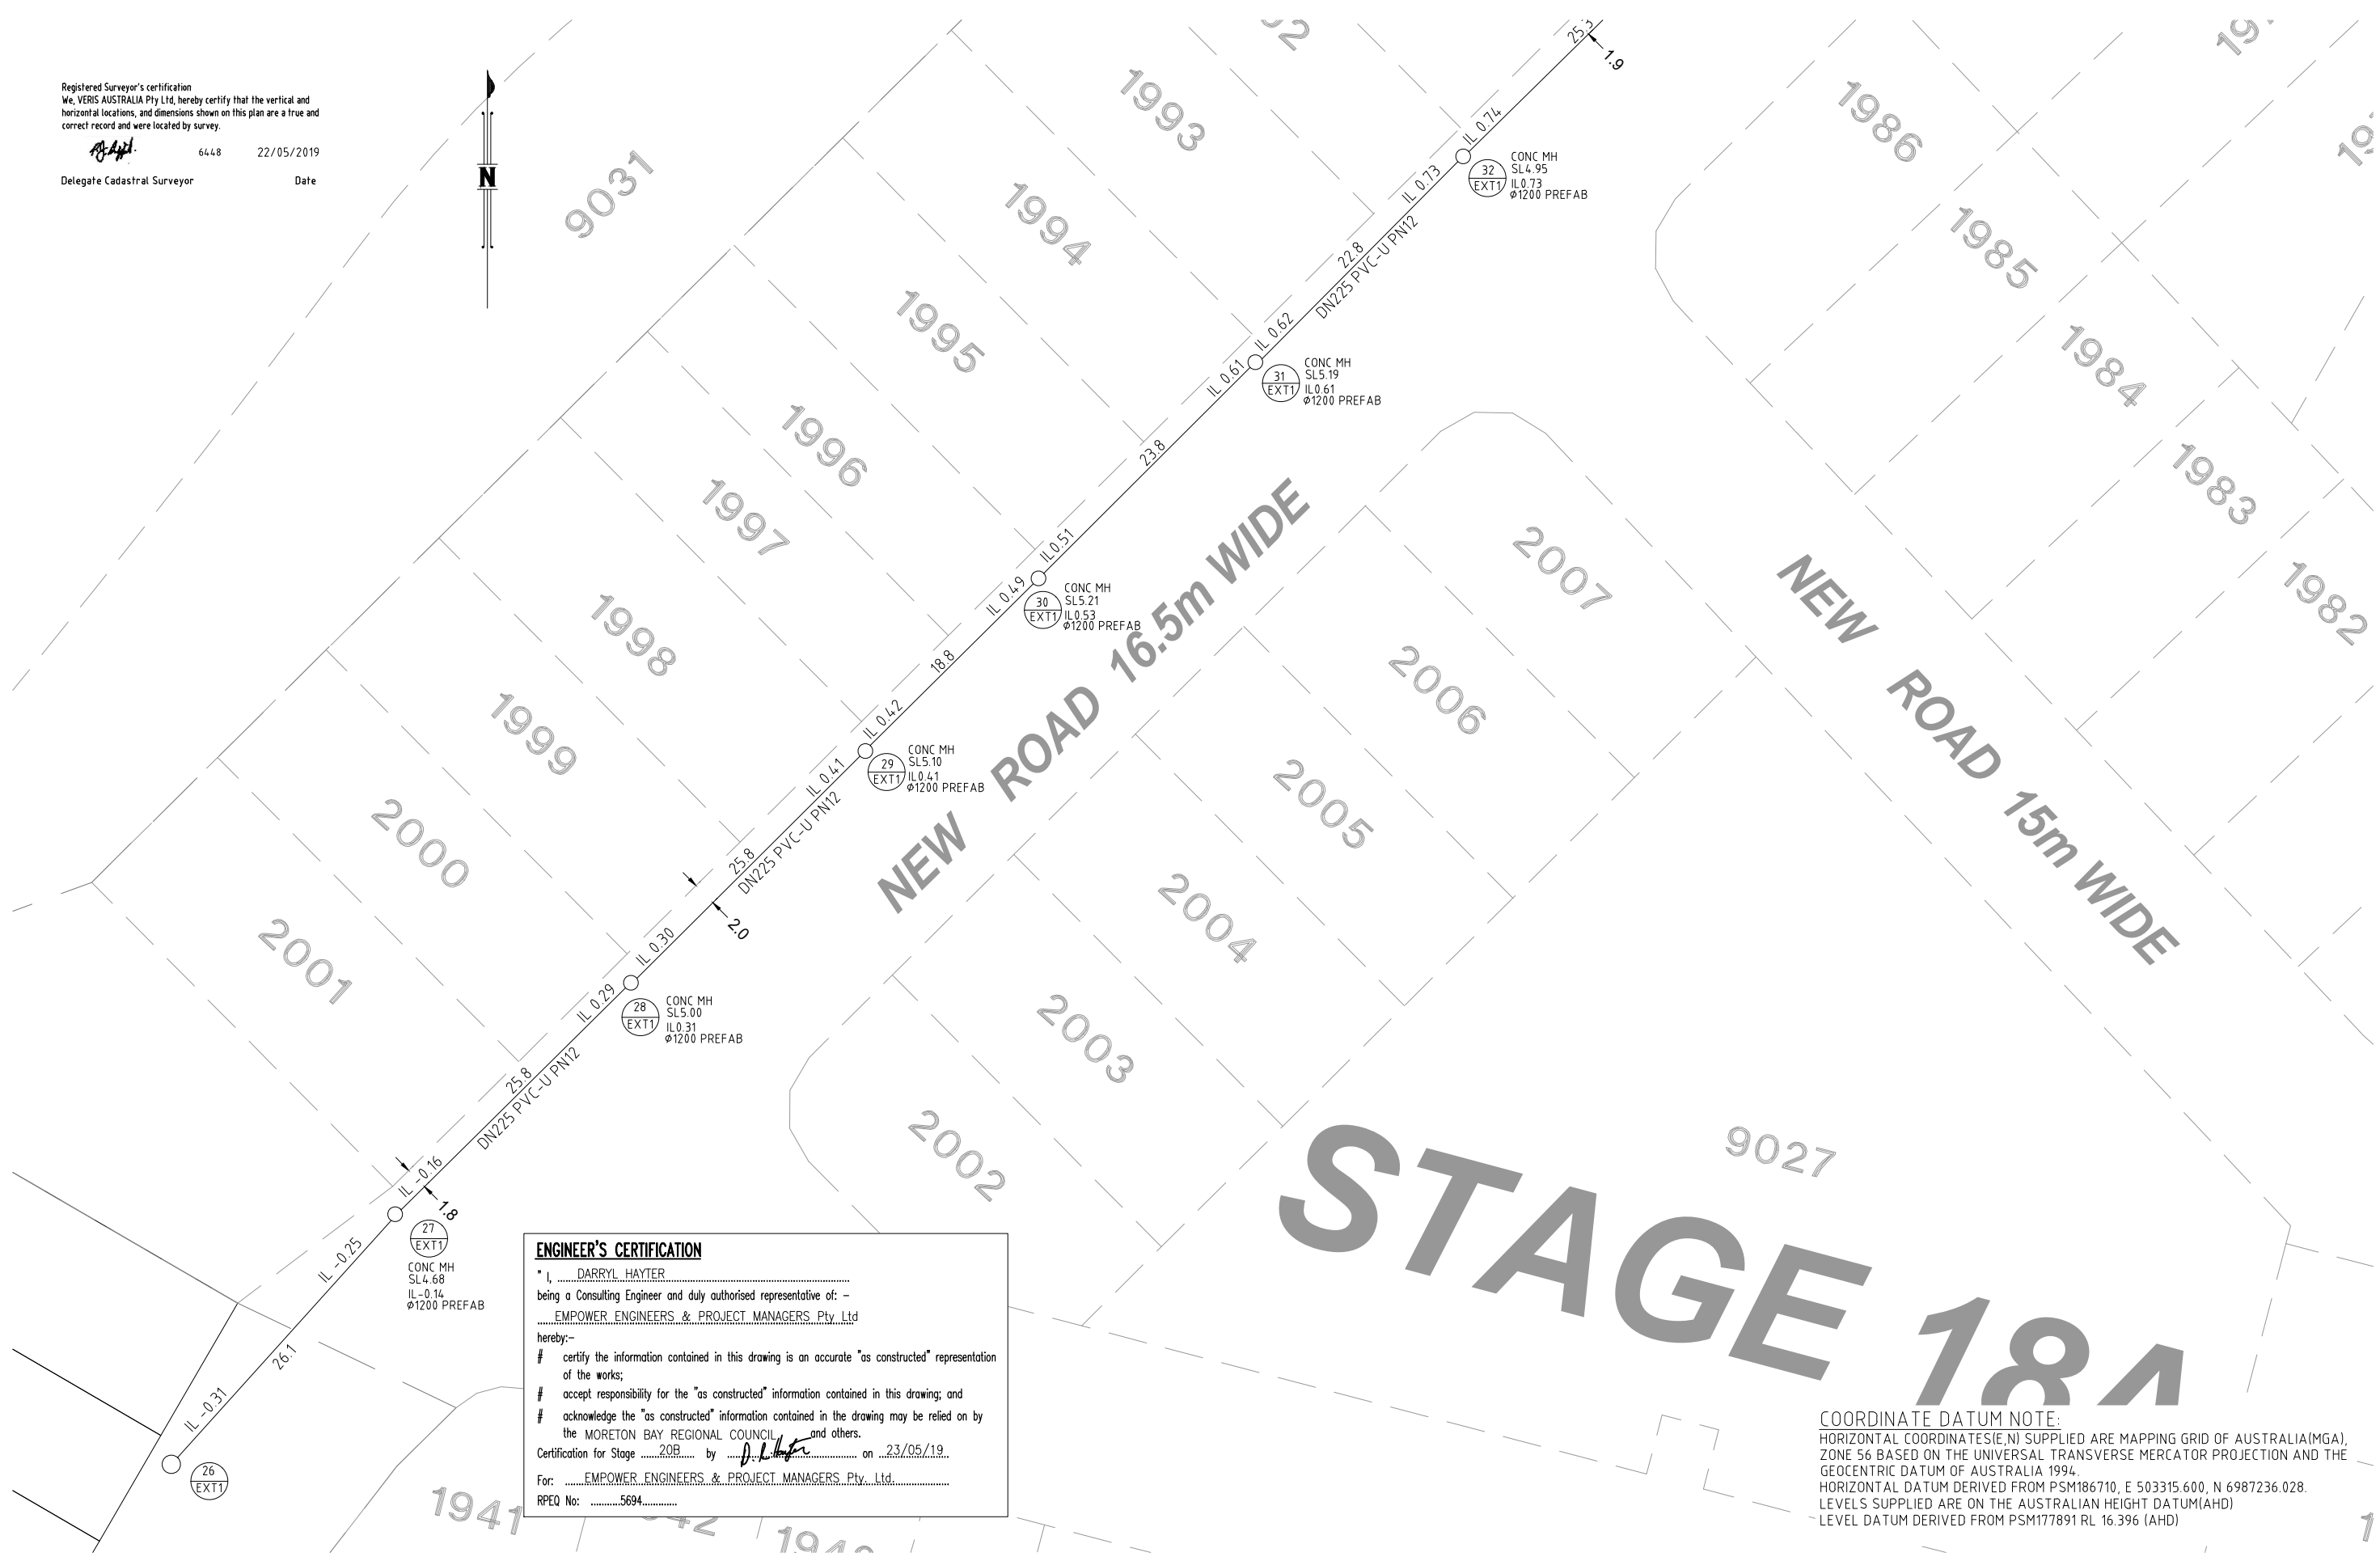

**ENGINEER'S CERTIFICATION**

I, DARRYL HAYTER  
 being a Consulting Engineer and duly authorised representative of: -  
EMPOWER ENGINEERS & PROJECT MANAGERS Pty Ltd  
 hereby:-  
 # certify the information contained in this drawing is an accurate "as constructed" representation of the works;  
 # accept responsibility for the "as constructed" information contained in this drawing; and  
 # acknowledge the "as constructed" information contained in the drawing may be relied on by the MORETON BAY REGIONAL COUNCIL and others.  
 Certification for Stage 20B by D. Hayter on 23/05/19  
 For: EMPOWER ENGINEERS & PROJECT MANAGERS Pty Ltd  
 RPEQ No: 5694

**COORDINATE DATUM NOTE:**  
 HORIZONTAL COORDINATES(E,N) SUPPLIED ARE MAPPING GRID OF AUSTRALIA(MGA), ZONE 56 BASED ON THE UNIVERSAL TRANSVERSE MERCATOR PROJECTION AND THE GEOCENTRIC DATUM OF AUSTRALIA 1994.  
 HORIZONTAL DATUM DERIVED FROM PSM186710, E 503315 600, N 6987236 028.  
 LEVELS SUPPLIED ARE ON THE AUSTRALIAN HEIGHT DATUM(AHD)  
 LEVEL DATUM DERIVED FROM PSM177891 RL 16.396 (AHD)

A1

INDEX	DATE	REVISIONS	DRAWN	CHECKED	PASSED
A	22/05/2019	ORIGINAL	JMc	JMc	

DRAWN	CHECKED	DATE
JMc	JMc	22/05/2019
		22/05/2019




BRISBANE PROSERPINE  
 (07) 206 4300 (07) 4961 7122  
 MACKAY CAIRNS  
 (07) 4651 2011 (07) 4591 8722  
 veris.com.au  
 ACN 604 671 374  
 Queensland Surveying Pty Ltd a Veris Company



**Unitywater**

2018012582  
 STAGE 20B CAPESTONE ESTATE  
 KINSELLES ROAD EAST, MANGO HILL  
 AS-CONSTRUCTED SEWER

SHEET 1 OF 5 SHEETS	SCALE 1:250
REVISION DATE 22/05/2019	REVISION A
DISCIPLINE CODE C	
DRAWING NO. U-2018-0916 AS	

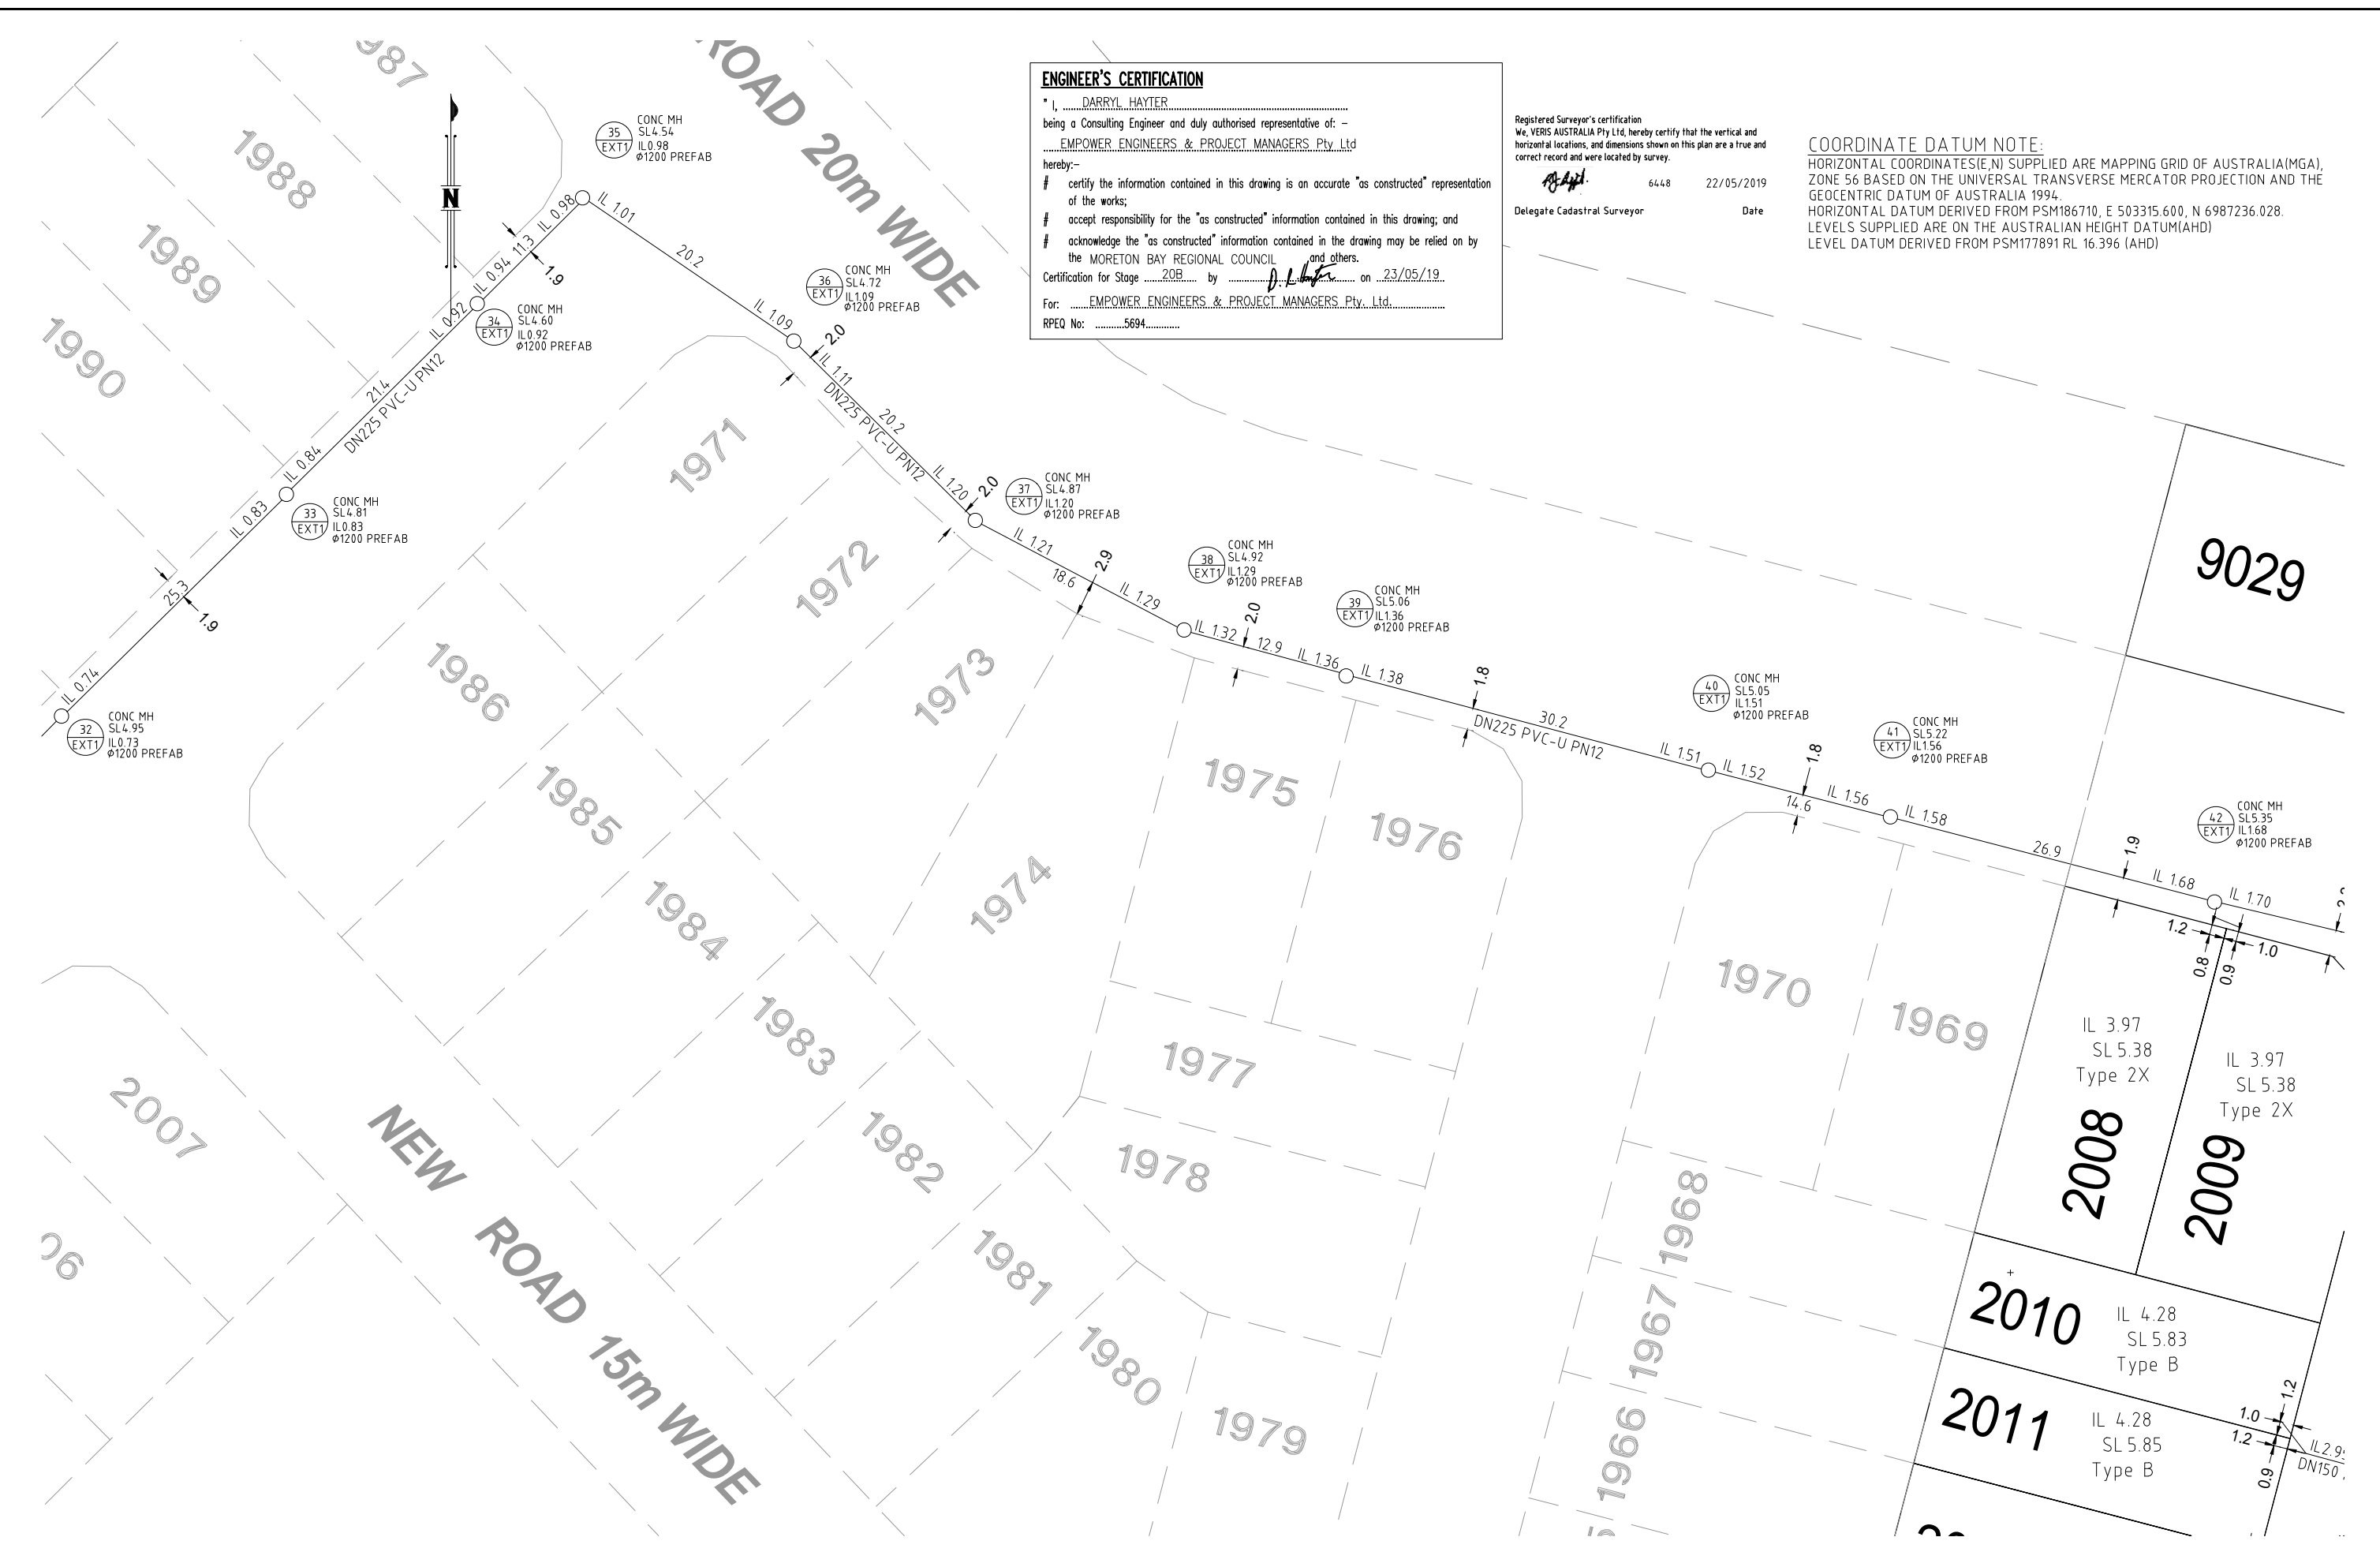

**ENGINEER'S CERTIFICATION**

I, DARRYL HAYTER  
 being a Consulting Engineer and duly authorised representative of: -  
EMPOWER ENGINEERS & PROJECT MANAGERS Pty Ltd  
 hereby:-  
 # certify the information contained in this drawing is an accurate "as constructed" representation of the works;  
 # accept responsibility for the "as constructed" information contained in this drawing; and  
 # acknowledge the "as constructed" information contained in the drawing may be relied on by the MORETON BAY REGIONAL COUNCIL and others.  
 Certification for Stage 20B by D. Hayter on 23/05/19  
 For: EMPOWER ENGINEERS & PROJECT MANAGERS Pty. Ltd.  
 RPEQ No: 5694

Registered Surveyor's certification  
 We, VERIS AUSTRALIA Pty Ltd, hereby certify that the vertical and horizontal locations, and dimensions shown on this plan are a true and correct record and were located by survey.  
[Signature] 6448 22/05/2019  
 Delegate Cadastral Surveyor Date

**COORDINATE DATUM NOTE:**  
 HORIZONTAL COORDINATES(E,N) SUPPLIED ARE MAPPING GRID OF AUSTRALIA(MGA), ZONE 56 BASED ON THE UNIVERSAL TRANSVERSE MERCATOR PROJECTION AND THE GEOCENTRIC DATUM OF AUSTRALIA 1994.  
 HORIZONTAL DATUM DERIVED FROM PSM186710, E 503315.600, N 6987236.028.  
 LEVELS SUPPLIED ARE ON THE AUSTRALIAN HEIGHT DATUM(AHD)  
 LEVEL DATUM DERIVED FROM PSM177891 RL 16.396 (AHD)

A1	INDEX	DATE	REVISIONS	DRAWN	CHECKED	PASSED	INITIALS	DATE
	A	22/05/2019	ORIGINAL	JMc	JMc			

DRAWN	JMc	22/05/2019
CHECKED	JMc	22/05/2019
PASSED		

BRISBANE (07) 206 4300  
 MACKAY (07) 4651 2011  
 PROSERPINE (07) 4661 1122  
 CARNS (07) 4651 8722  
 veris.com.au  
 ACN 604 671 374  
 Queensland Surveying Pty Ltd a Veris Company



**Unitywater**  
 2018012582  
 STAGE 20B CAPESTONE ESTATE  
 KINSELLES ROAD EAST, MANGO HILL  
 AS-CONSTRUCTED SEWER


SHEET 2 OF 5 SHEETS	SCALE 1:250
REVISION DATE 22/05/2019	REVISION A
DISCIPLINE CODE C	
DRAWING NO. U-2018-0916 AS	

**COORDINATE DATUM NOTE:**  
 HORIZONTAL COORDINATES(E,N) SUPPLIED ARE MAPPING GRID OF AUSTRALIA(MGA), ZONE 56 BASED ON THE UNIVERSAL TRANSVERSE MERCATOR PROJECTION AND THE GEOCENTRIC DATUM OF AUSTRALIA 1994.  
 HORIZONTAL DATUM DERIVED FROM PSM186710, E 503315.600, N 6987236.028.  
 LEVELS SUPPLIED ARE ON THE AUSTRALIAN HEIGHT DATUM(AHD)  
 LEVEL DATUM DERIVED FROM PSM177891 RL 16.396 (AHD)

**ENGINEER'S CERTIFICATION**


I, DARRYL HAYTER  
 being a Consulting Engineer and duly authorised representative of -  
EMPOWER ENGINEERS & PROJECT MANAGERS Pty Ltd  
 hereby:-  
 # certify the information contained in this drawing is an accurate "as constructed" representation of the works;  
 # accept responsibility for the "as constructed" information contained in this drawing; and  
 # acknowledge the "as constructed" information contained in the drawing may be relied on by the MORETON BAY REGIONAL COUNCIL and others.  
 Certification for Stage 20B by D. Hayter on 23/05/19  
 For: EMPOWER ENGINEERS & PROJECT MANAGERS Pty Ltd  
 RPEQ No: 5694

Registered Surveyor's certification  
 We, VERIS AUSTRALIA Pty Ltd, hereby certify that the vertical and horizontal locations, and dimensions shown on this plan are a true and correct record and were located by survey.  
[Signature] 6448 22/05/2019 Date  
 Delegate Cadastral Surveyor

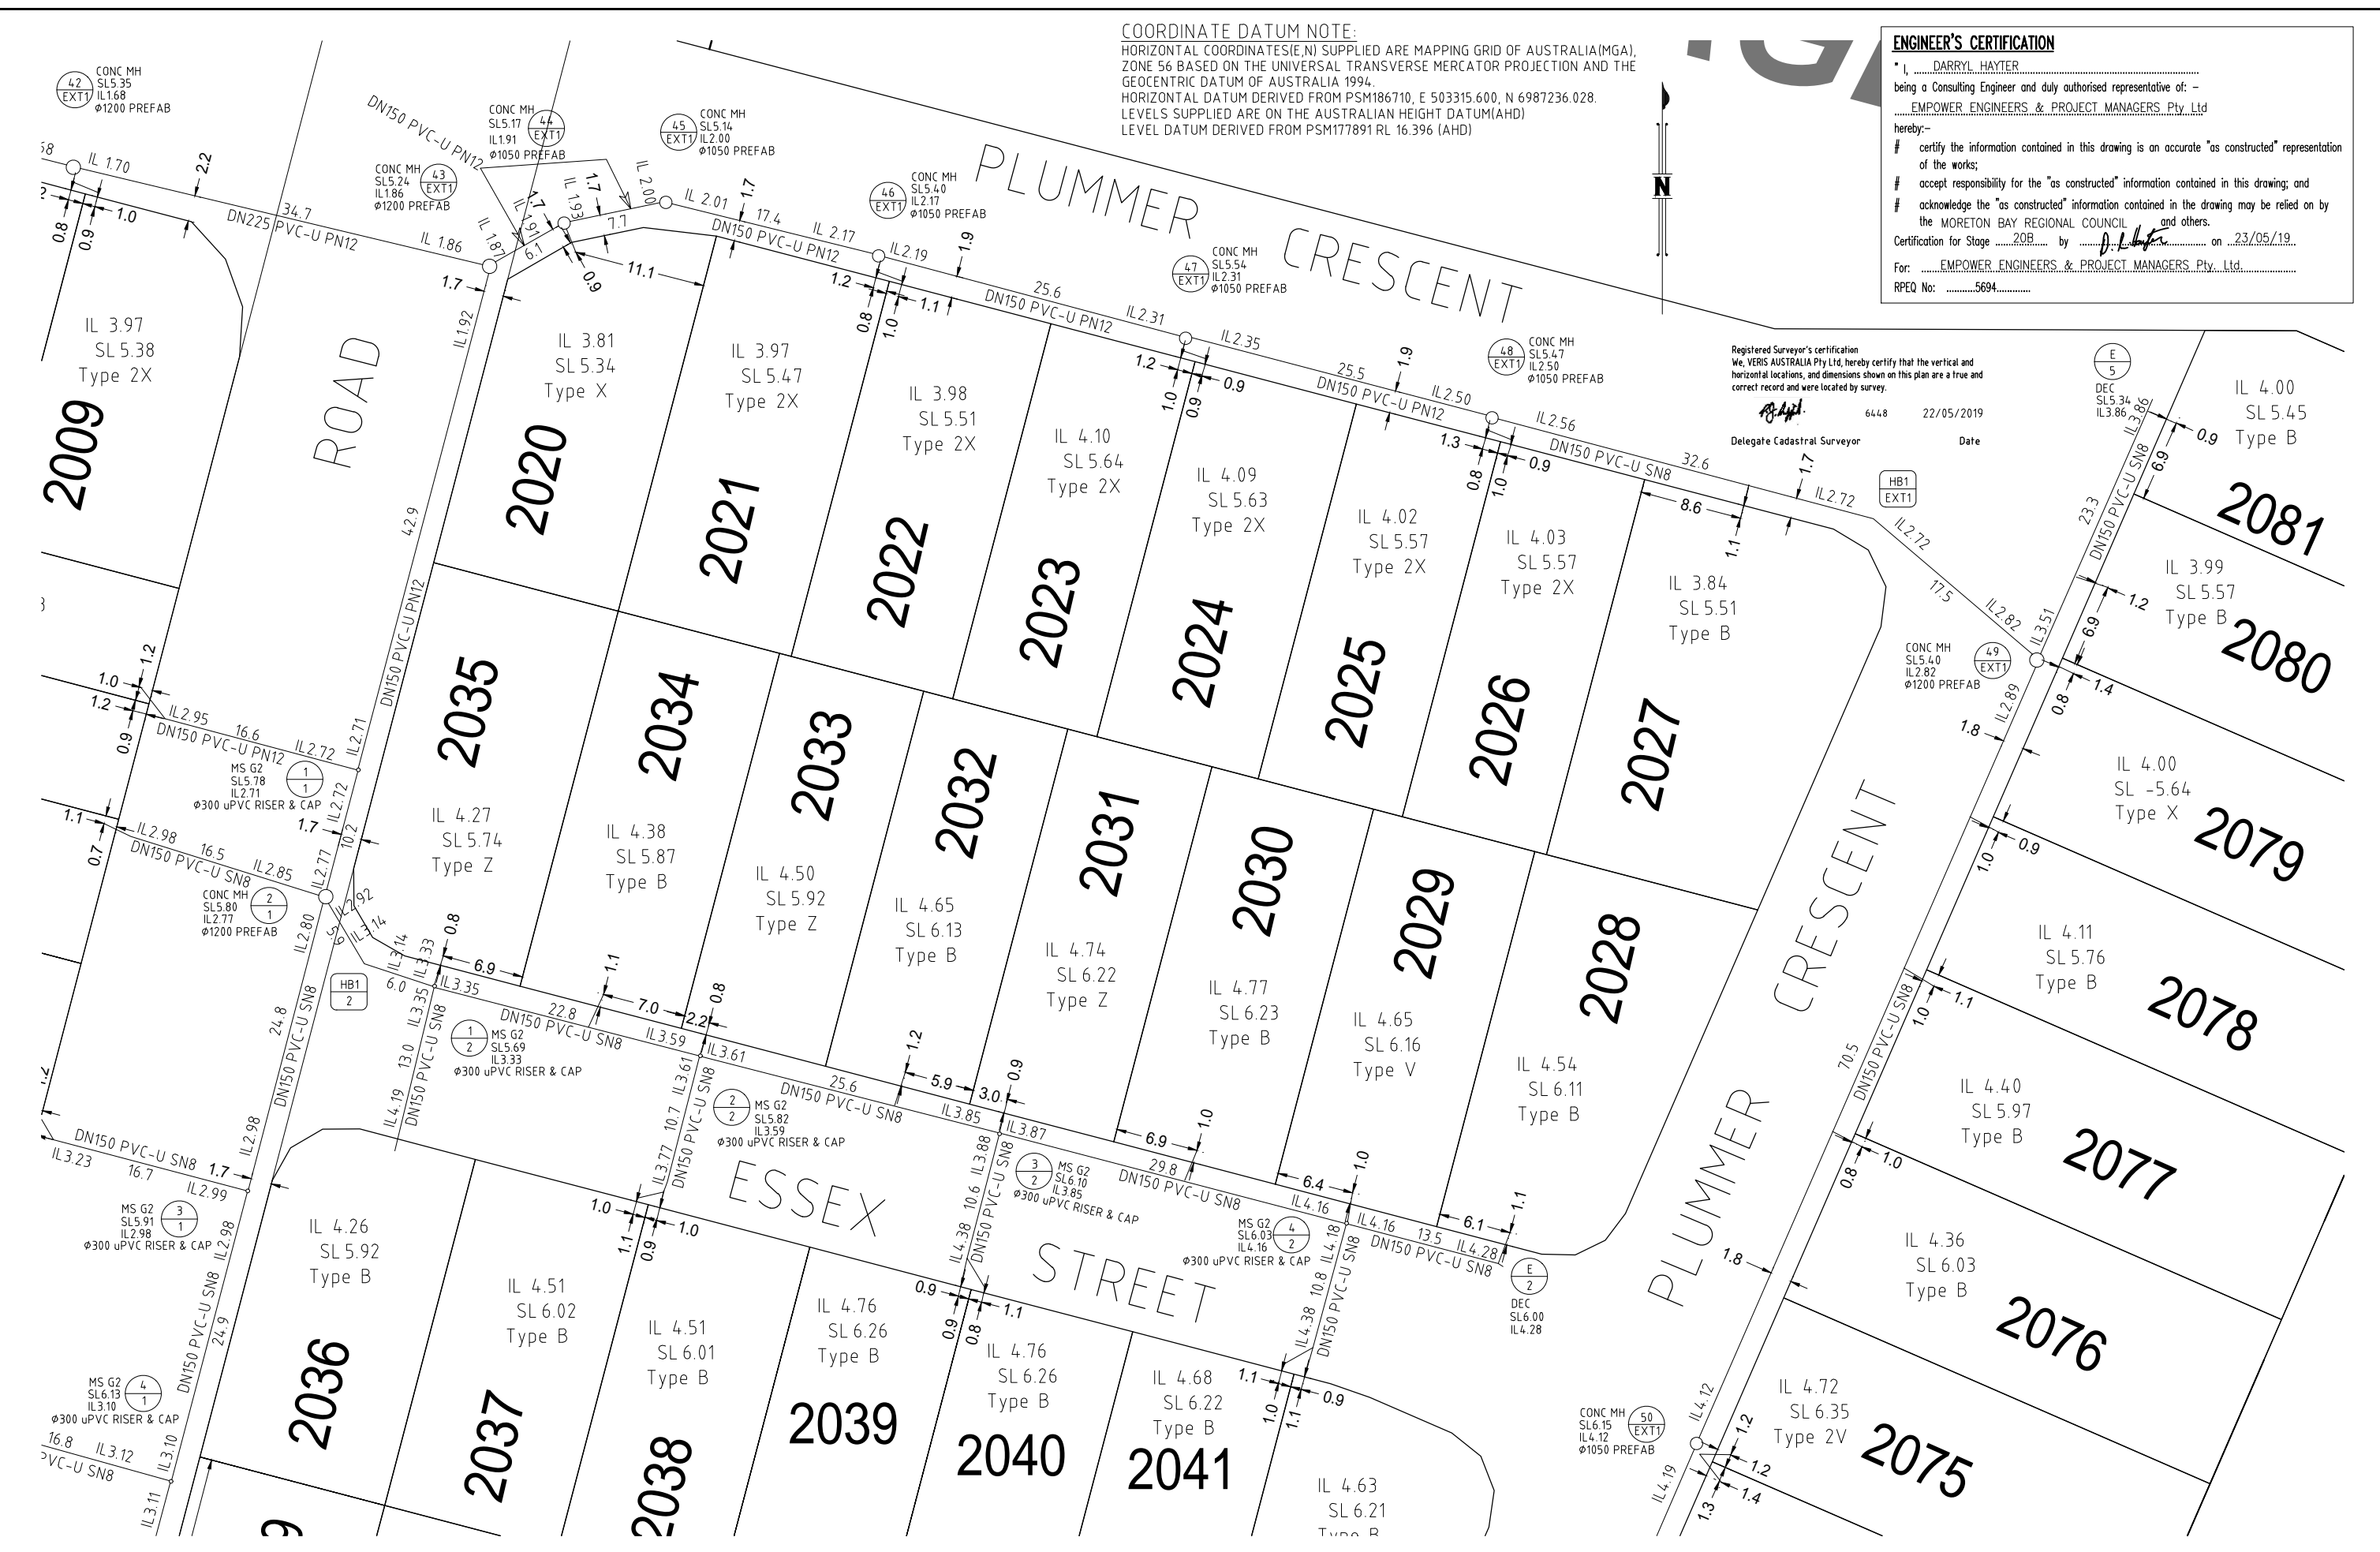

A1	INDEX	DATE	ORIGINAL	REVISIONS	DRAWN	CHECKED	PASSED
	A	22/05/2019	ORIGINAL		JMc	JMc	

DRAWN	JMc	22/05/2019
CHECKED	JMc	22/05/2019
PASSED		

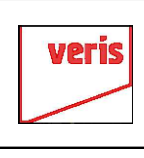

BRISBANE (07) 206 4300  
 MACKAY (07) 4651 2011  
 PROSERPINE (07) 4651 1222  
 CARNS (07) 4651 6722  
 veris.com.au  
 ACN 604 671 374  
 Queensland Surveying Pty Ltd a Veris Company




**Unitywater**  
 2018012582  
 STAGE 20B CAPESTONE ESTATE  
 KINSELLES ROAD EAST, MANGO HILL  
 AS-CONSTRUCTED SEWER

SHEET 3 OF 5 SHEETS	SCALE 1:250
REVISION DATE 22/05/2019	REVISION A
DISCIPLINE CODE C	
DRAWING NO. U-2018-0916 AS	

Registered Surveyor's certification  
 We, VERIS AUSTRALIA Pty Ltd, hereby certify that the vertical and horizontal locations, and dimensions shown on this plan are a true and correct record and were located by survey.

6448  
 22/05/2019  
 Delegate Cadastral Surveyor

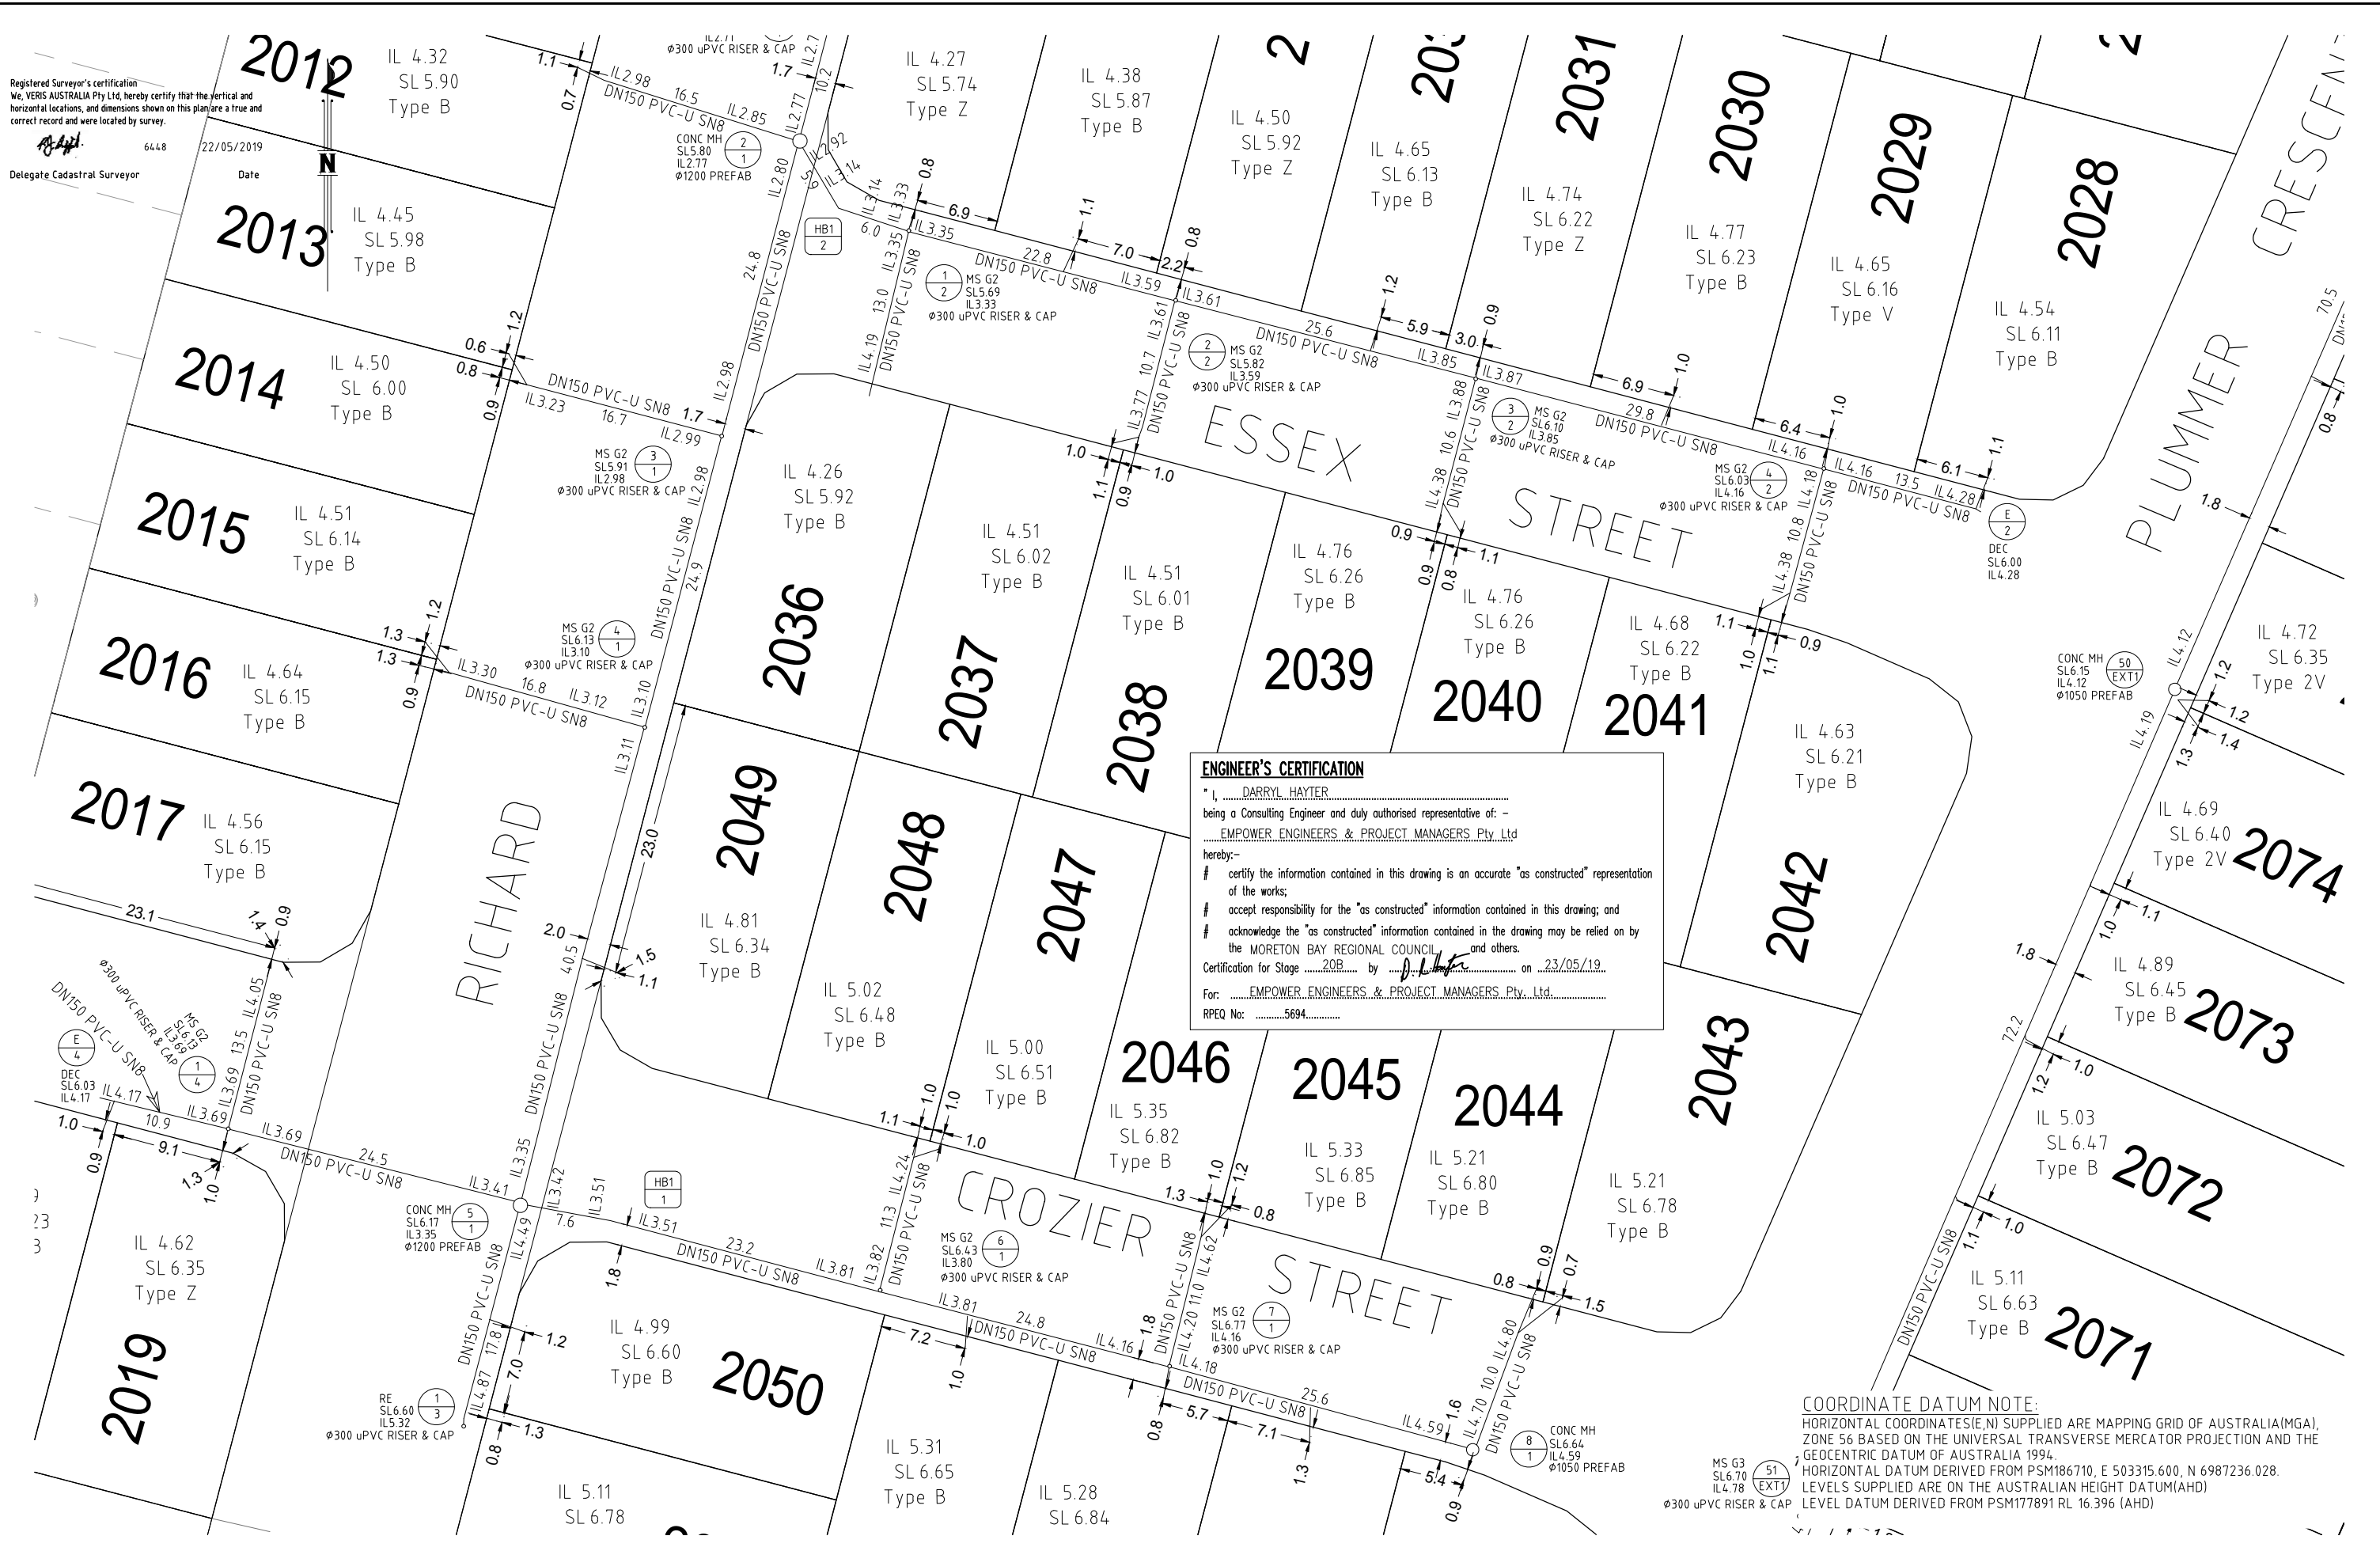

**ENGINEER'S CERTIFICATION**

I, DARRYL HAYTER  
 being a Consulting Engineer and duly authorised representative of: -  
EMPOWER ENGINEERS & PROJECT MANAGERS Pty Ltd  
 hereby:-  
 # certify the information contained in this drawing is an accurate "as constructed" representation of the works;  
 # accept responsibility for the "as constructed" information contained in this drawing; and  
 # acknowledge the "as constructed" information contained in the drawing may be relied on by the MORETON BAY REGIONAL COUNCIL, and others.  
 Certification for Stage 20B by D. Hayter on 23/05/19  
 For: EMPOWER ENGINEERS & PROJECT MANAGERS Pty Ltd  
 RPEQ No: 5694

**COORDINATE DATUM NOTE:**  
 HORIZONTAL COORDINATES (E, N) SUPPLIED ARE MAPPING GRID OF AUSTRALIA (MGA), ZONE 56 BASED ON THE UNIVERSAL TRANSVERSE MERCATOR PROJECTION AND THE GEOCENTRIC DATUM OF AUSTRALIA 1994.  
 HORIZONTAL DATUM DERIVED FROM PSM186710, E 503315 600, N 6987236 028.  
 LEVELS SUPPLIED ARE ON THE AUSTRALIAN HEIGHT DATUM (AHD)  
 LEVEL DATUM DERIVED FROM PSM177891 RL 16.396 (AHD)

A1	INDEX	DATE	ORIGINAL	REVISIONS	DRAWN	CHECKED	PASSED
	A	22/05/2019	ORIGINAL		JMc	JMc	

DRAWN	JMc	22/05/2019
CHECKED	JMc	22/05/2019
PASSED		
INITIALS		DATE




BRISBANE (07) 396 4300  
 PROSERPINE (07) 4681 7122  
 MACKAY (07) 4681 2011  
 CAIRNS (07) 4681 6722  
 veris.com.au  
 ACN 604 671 374  
 Queensland Surveying Pty Ltd a Veris Company



**Unitywater**  
 2018012582  
 STAGE 20B CAPESTONE ESTATE  
 KINSELLES ROAD EAST, MANGO HILL  
 AS-CONSTRUCTED SEWER

SHEET 4 OF 5 SHEETS	SCALE 1:250
REVISION DATE 22/05/2019	REVISION A
DISCIPLINE CODE C	
DRAWING NO. U-2018-0916 AS	

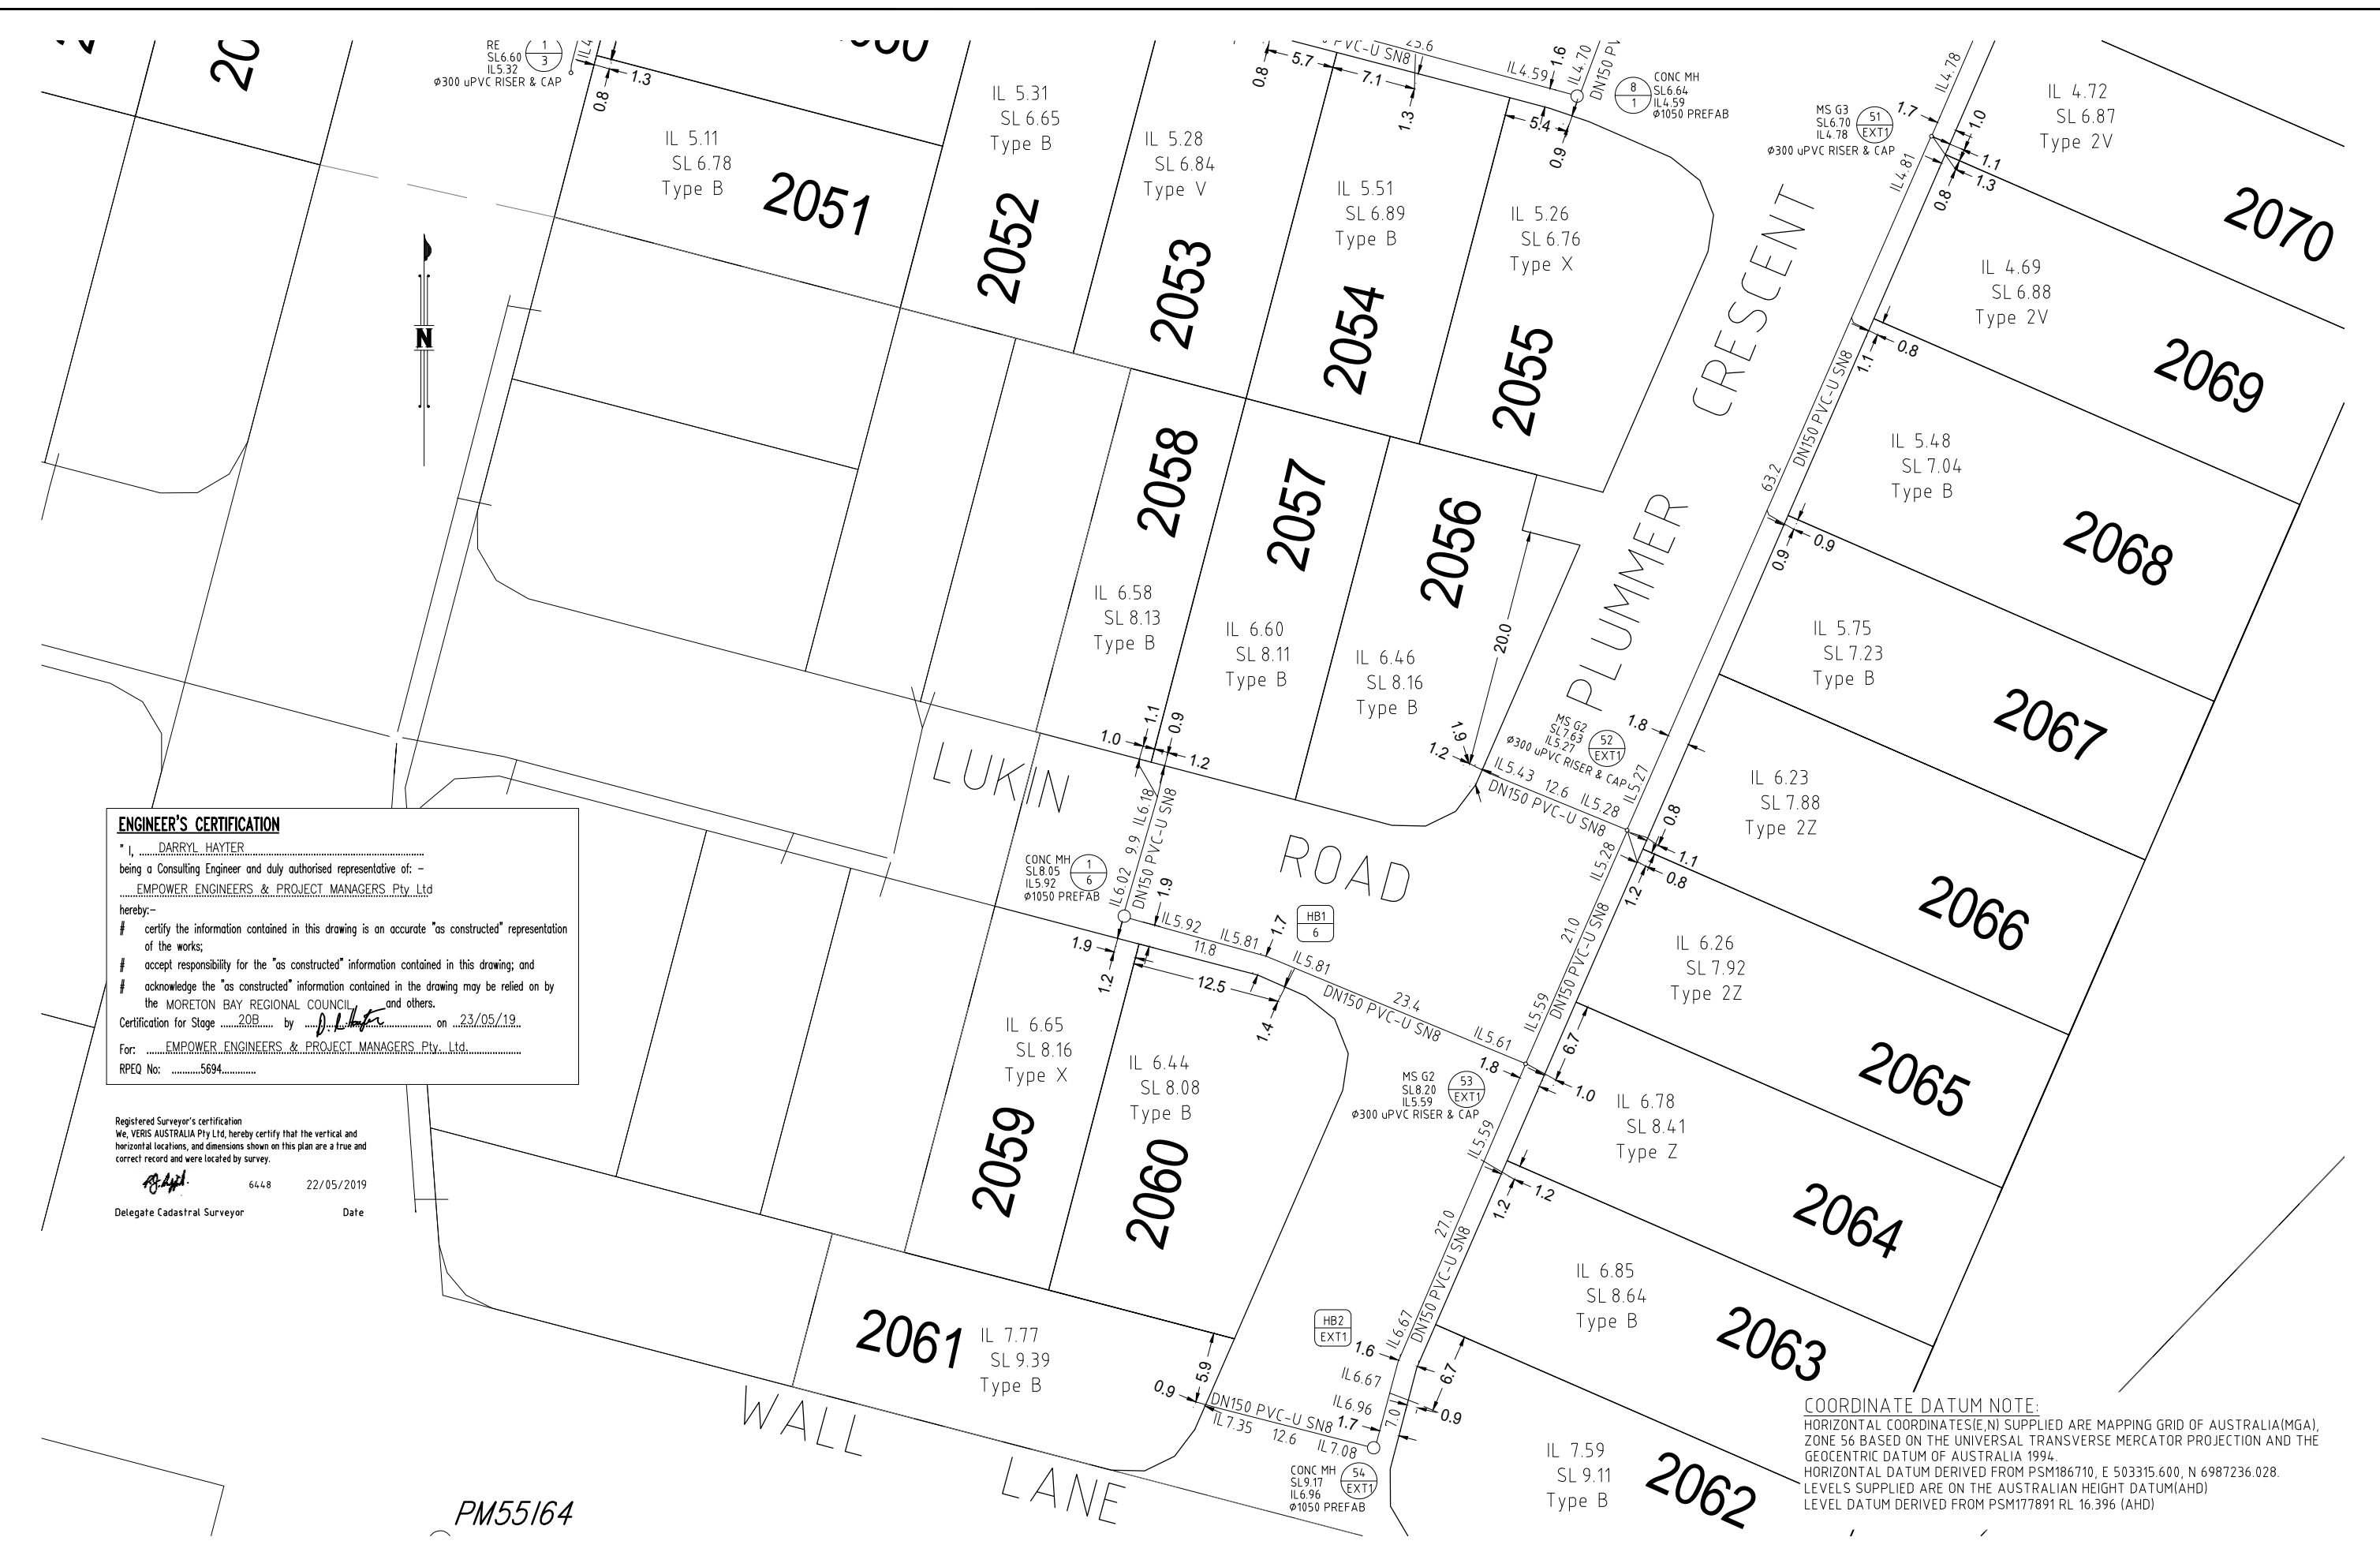

**ENGINEER'S CERTIFICATION**  
 I, DARRYL HAYTER  
 being a Consulting Engineer and duly authorised representative of -  
EMPOWER ENGINEERS & PROJECT MANAGERS Pty Ltd  
 hereby:-  
 # certify the information contained in this drawing is an accurate "as constructed" representation of the works;  
 # accept responsibility for the "as constructed" information contained in this drawing; and  
 # acknowledge the "as constructed" information contained in the drawing may be relied on by the MORETON BAY REGIONAL COUNCIL and others.  
 Certification for Stage 20B by D. Hayter on 23/05/19  
 For: EMPOWER ENGINEERS & PROJECT MANAGERS Pty Ltd  
 RPEQ No: 5694

Registered Surveyor's certification  
 We, VERIS AUSTRALIA Pty Ltd, hereby certify that the vertical and horizontal locations, and dimensions shown on this plan are a true and correct record and were located by survey.  
6448 22/05/2019  
 Delegate Cadastral Surveyor Date

**COORDINATE DATUM NOTE:**  
 HORIZONTAL COORDINATES(E,N) SUPPLIED ARE MAPPING GRID OF AUSTRALIA(MGA), ZONE 56 BASED ON THE UNIVERSAL TRANSVERSE MERCATOR PROJECTION AND THE GEOCENTRIC DATUM OF AUSTRALIA 1994.  
 HORIZONTAL DATUM DERIVED FROM PSM186710, E 503315 600, N 6987236 028.  
 LEVELS SUPPLIED ARE ON THE AUSTRALIAN HEIGHT DATUM(AHD)  
 LEVEL DATUM DERIVED FROM PSM177891 RL 16.396 (AHD)

A1	INDEX	DATE	REVISIONS	DRAWN	CHECKED	PASSED	INITIALS	DATE	 BRISBANE (07) 308 4300 PROSERPINE (07) 4981 7122 MACKAY (07) 4651 2011 CARNS (07) 4651 8722 veris.com.au ACN 604 671 374 Queensland Surveying Pty Ltd a Veris Company	 2018012582 STAGE 20B CAPESTONE ESTATE KINSELLES ROAD EAST, MANGO HILL AS-CONSTRUCTED SEWER	SHEET 5 OF 5 SHEETS	SCALE 1:250
	A	22/05/2019	ORIGINAL	JMc	JMc						REVISION DATE 22/05/2019 REVISION A DISCIPLINE CODE C DRAWING NO. U-2018-0916 AS	