


Registered Surveyor's certification
 We, VERIS AUSTRALIA Pty Ltd, hereby certify that the vertical and horizontal locations, and dimensions shown on this plan are a true and correct record and were located by survey.

[Signature] 6448 30/08/2019
 Delegate Cadastral Surveyor Date



ENGINEER'S CERTIFICATION

I, DARRYL HAYTER
 being a Consulting Engineer and duly authorised representative of: -
EMPOWER ENGINEERS & PROJECT MANAGERS Pty Ltd
 hereby:-
 # certify the information contained in this drawing is an accurate "as constructed" representation of the works;
 # accept responsibility for the "as constructed" information contained in this drawing; and
 # acknowledge the "as constructed" information contained in the drawing may be relied on by the MORETON BAY REGIONAL COUNCIL and others.
 Certification for Stage 18A by [Signature] on 17/09/19.
 For: EMPOWER ENGINEERS & PROJECT MANAGERS Pty Ltd
 RPEQ No: 5694.

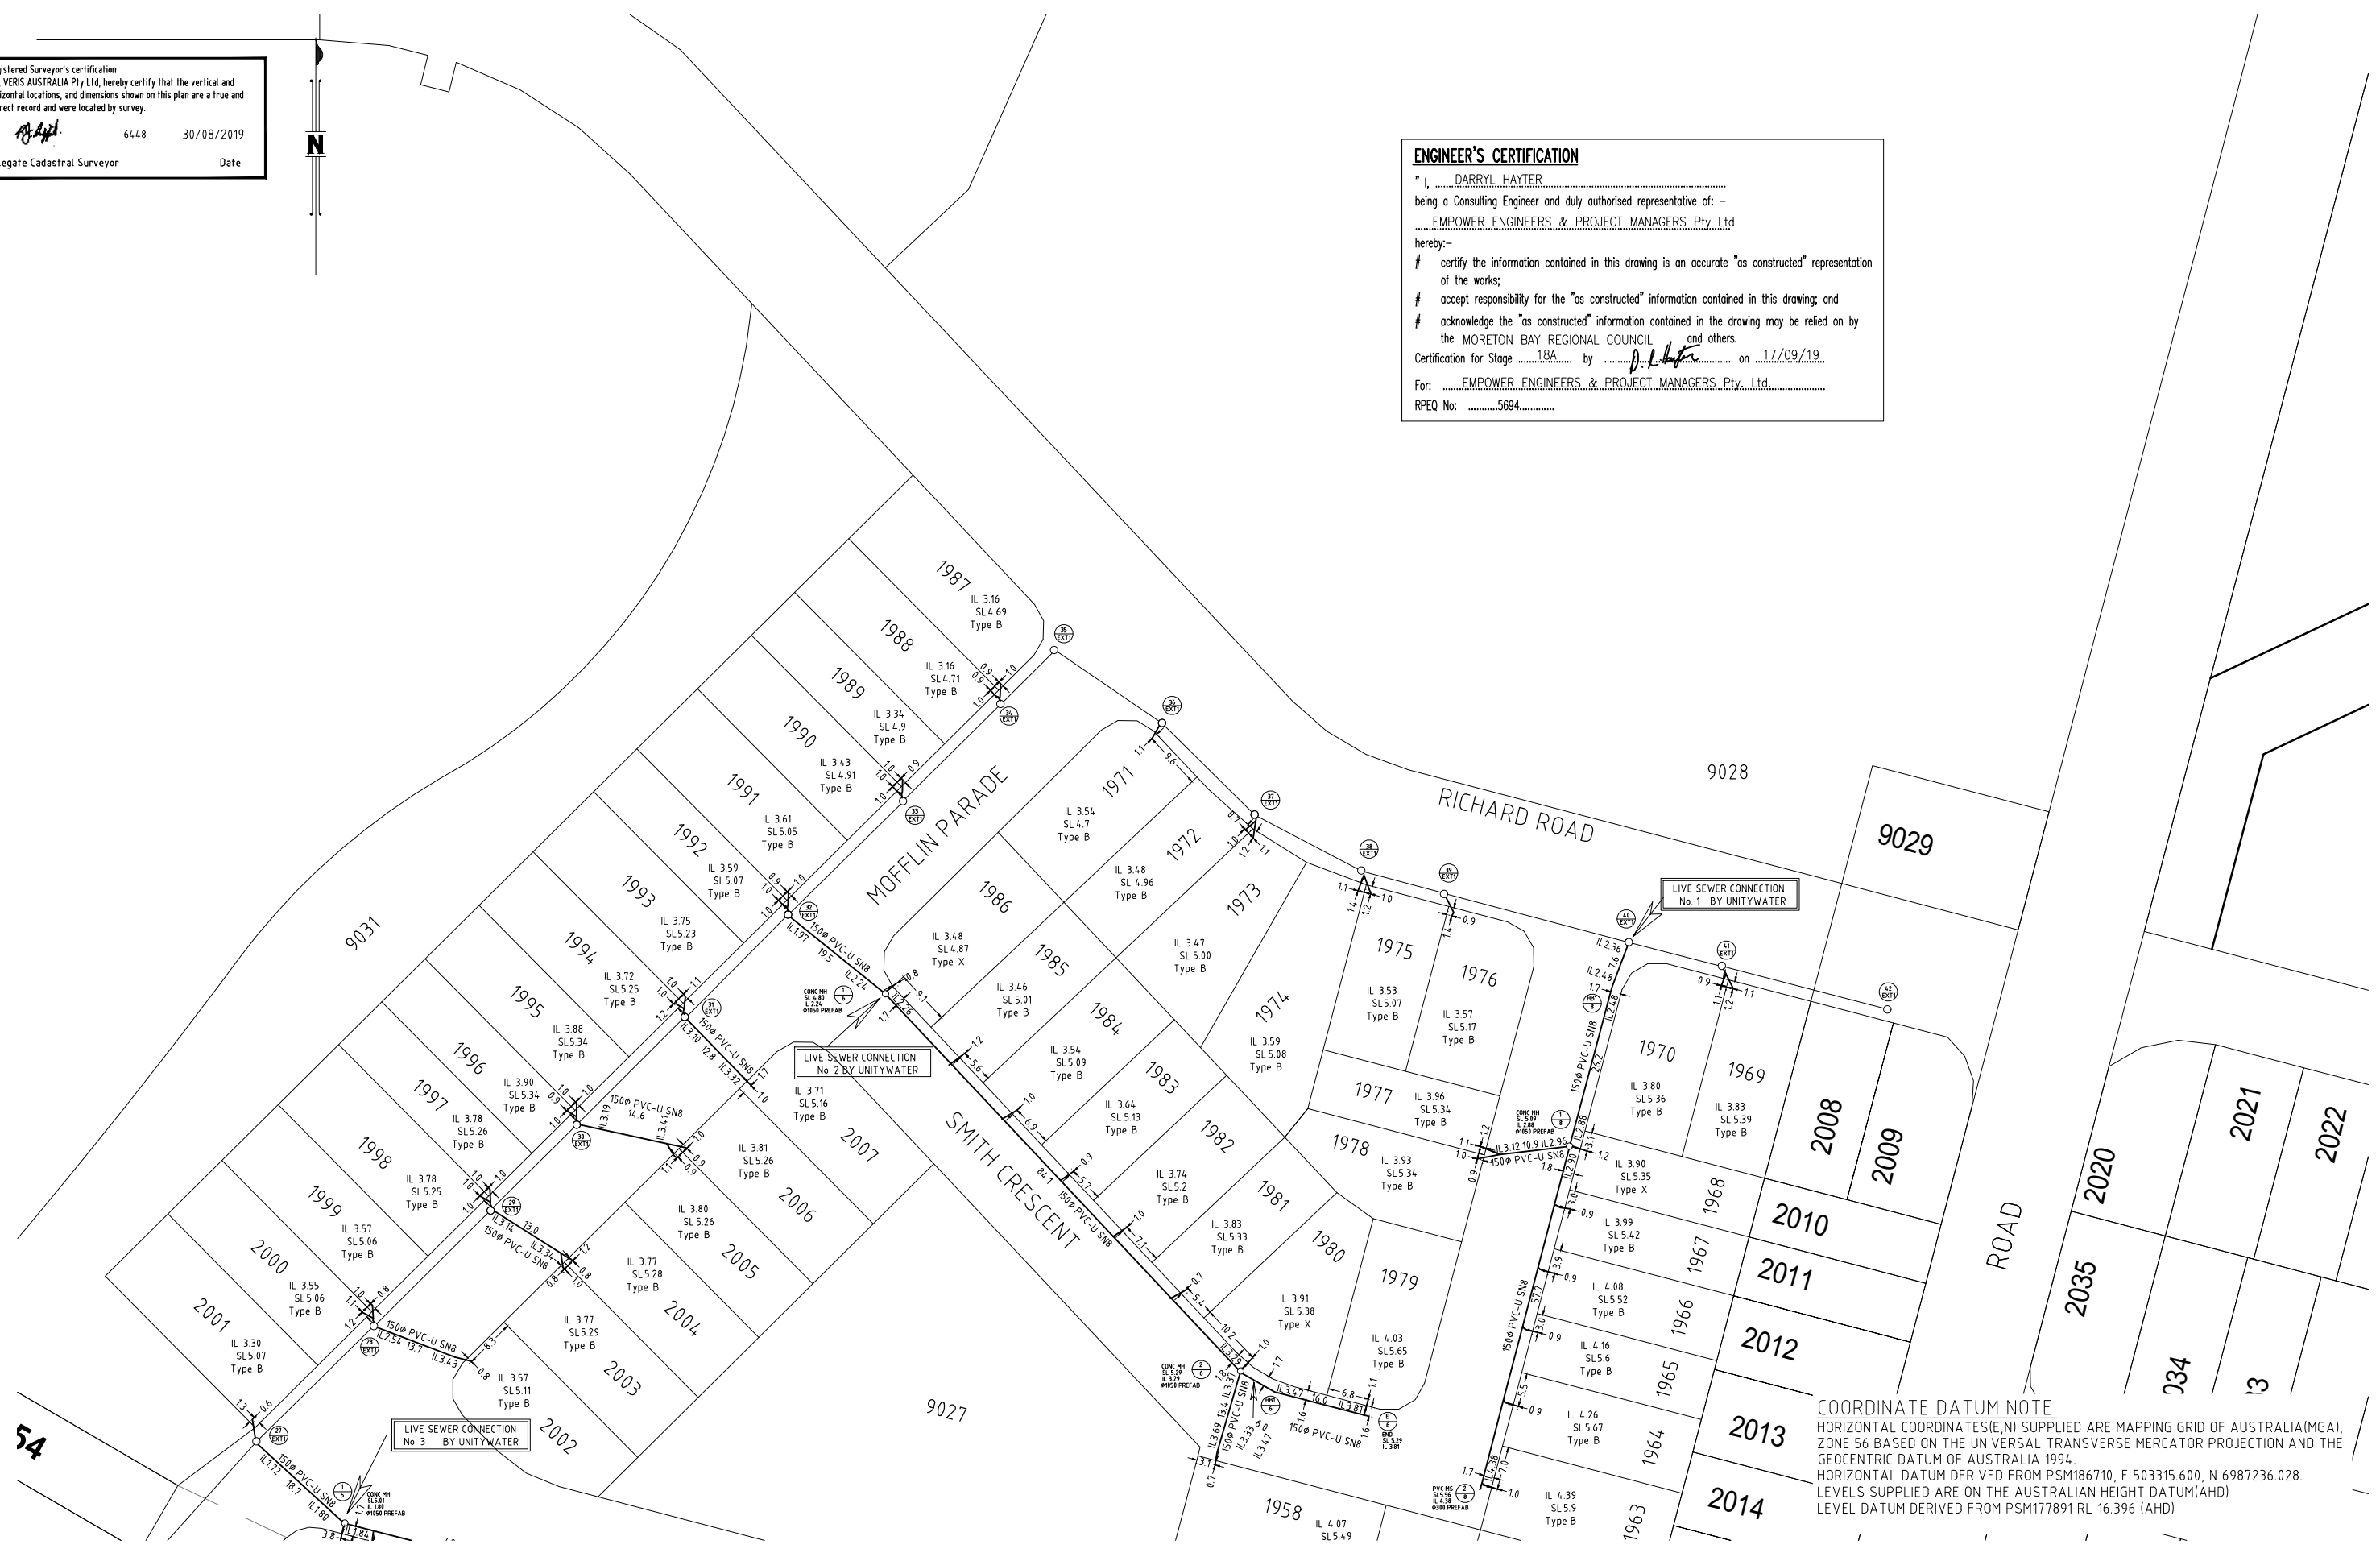

COORDINATE DATUM NOTE:
 HORIZONTAL COORDINATES(E,N) SUPPLIED ARE MAPPING GRID OF AUSTRALIA(MGA), ZONE 56 BASED ON THE UNIVERSAL TRANSVERSE MERCATOR PROJECTION AND THE GEOCENTRIC DATUM OF AUSTRALIA 1994.
 HORIZONTAL DATUM DERIVED FROM PSM186710, E 503315 600, N 6987236.028.
 LEVELS SUPPLIED ARE ON THE AUSTRALIAN HEIGHT DATUM(AHD)
 LEVEL DATUM DERIVED FROM PSM177891 RL 16.396 (AHD)

A1	INDEX	DATE	REVISIONS	DRAWN	CHECKED	PASSED	DRAWN	CHECKED	PASSED	INITIALS	DATE
	A	30/08/2019	ORIGINAL	JMc	JMc		JMc	JMc			

veris

BRISBANE WHITSUNDAYS
 (07) 3868 4300 (07) 4645 1122
 MACKAY CAIRNS
 (07) 4651 2511 (07) 4651 8722

veris.com.au
 ACN 615 755 727
 Veris Australia Pty Ltd




Unitywater

2018013580-00
 STAGE 18A CAPESTONE ESTATE
 KINSELLES ROAD EAST, MANGO HILL
 AS-CONSTRUCTED SEWER

SHEET 1 OF 2 SHEETS	SCALE 1500
REVISION DATE 30/08/2019	REVISION A
DISCIPLINE CODE C	
DRAWING NO. U-2019-1030	

Registered Surveyor's certification
 We, VERIS AUSTRALIA Pty Ltd, hereby certify that the vertical and horizontal locations, and dimensions shown on this plan are a true and correct record and were located by survey.

[Signature] 6448 30/08/2019
 Delegate Cadastral Surveyor Date

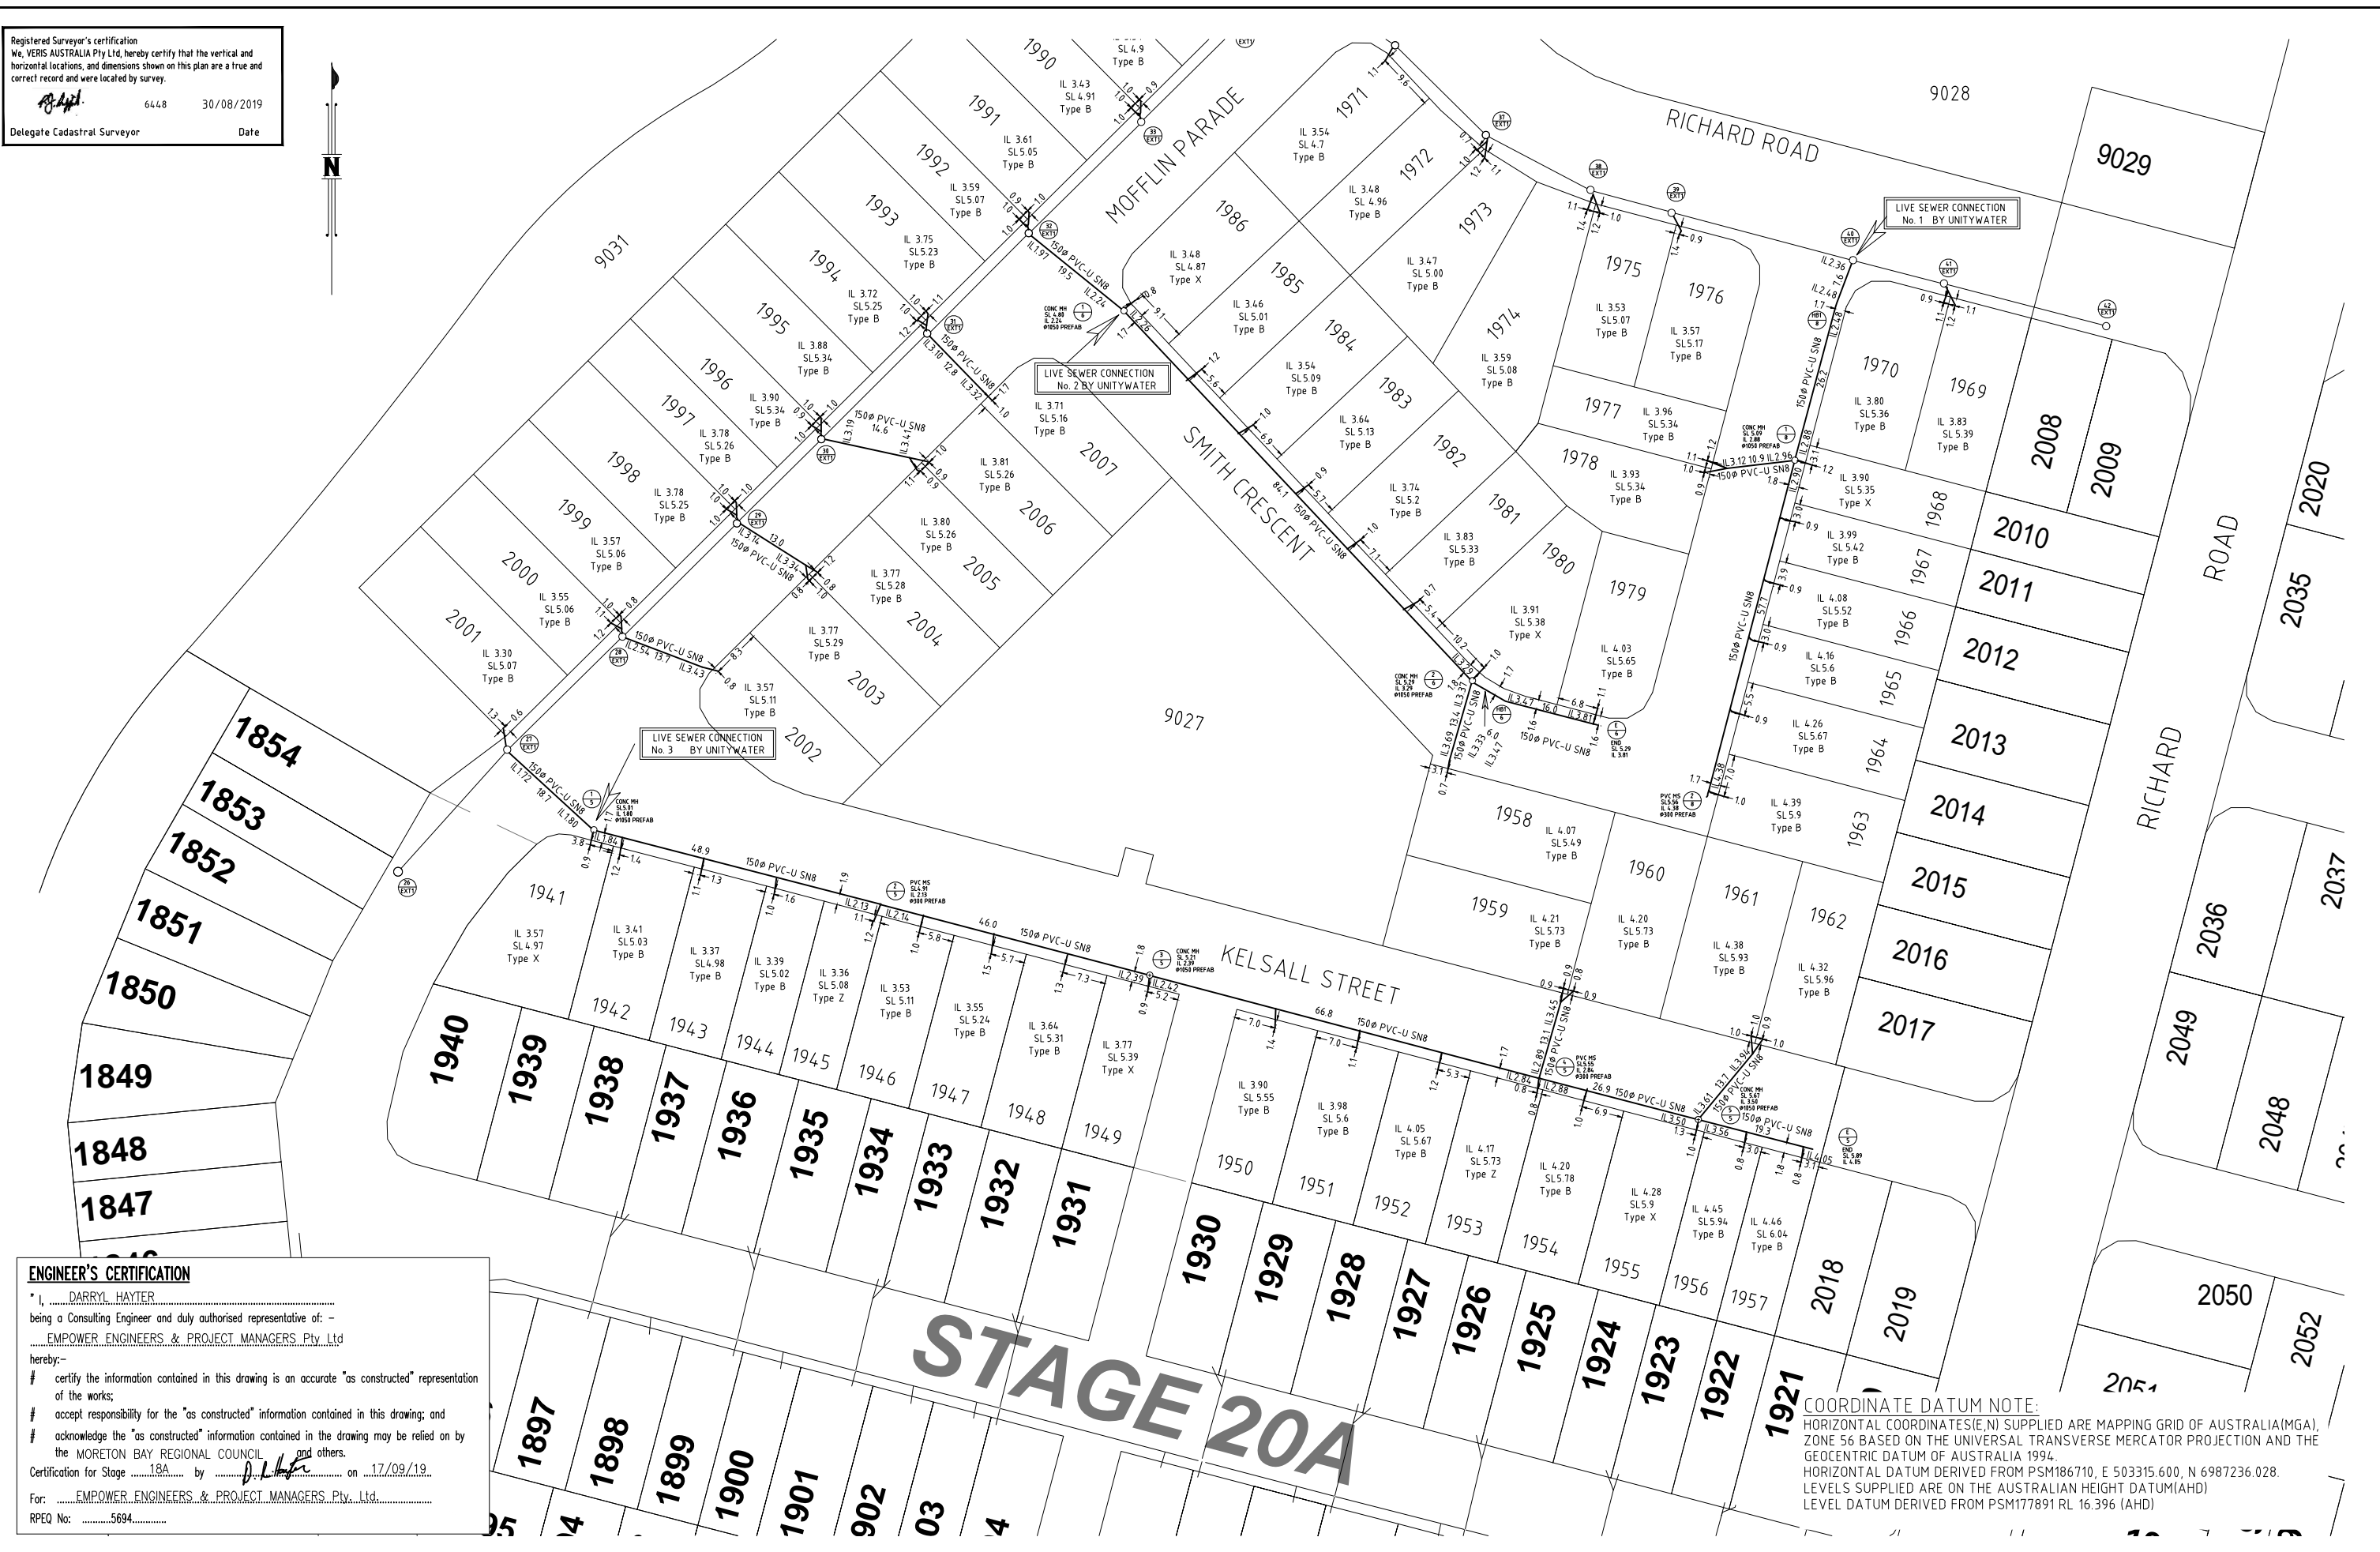

ENGINEER'S CERTIFICATION

* I, DARRYL HAYTER
 being a Consulting Engineer and duly authorised representative of: -
EMPOWER ENGINEERS & PROJECT MANAGERS Pty Ltd
 hereby:-
 # certify the information contained in this drawing is an accurate "as constructed" representation of the works;
 # accept responsibility for the "as constructed" information contained in this drawing; and
 # acknowledge the "as constructed" information contained in the drawing may be relied on by the MORETON BAY REGIONAL COUNCIL and others.
 Certification for Stage 18A by [Signature] on 17/09/19
 For: EMPOWER ENGINEERS & PROJECT MANAGERS Pty Ltd
 RPEQ No: 5694

COORDINATE DATUM NOTE:
 HORIZONTAL COORDINATES (E,N) SUPPLIED ARE MAPPING GRID OF AUSTRALIA (MGA), ZONE 56 BASED ON THE UNIVERSAL TRANSVERSE MERCATOR PROJECTION AND THE GEOCENTRIC DATUM OF AUSTRALIA 1994.
 HORIZONTAL DATUM DERIVED FROM PSM186710, E 503315.600, N 6987236.028.
 LEVELS SUPPLIED ARE ON THE AUSTRALIAN HEIGHT DATUM (AHD)
 LEVEL DATUM DERIVED FROM PSM177891 RL 16.396 (AHD)

A1

INDEX	DATE	REVISIONS	DRAWN	CHECKED	PASSED
A	30/08/2019	ORIGINAL	JMc	JMc	

DRAWN	INITIALS	DATE
JMc	JMc	30/08/2019
JMc	JMc	30/08/2019



BRISBANE 071 9084 4700
 WHITSUNDAYS 071 9084 7122
 MACKAY 071 4601 2911
 CAIRNS 071 4601 8722
 veris.com.au
 ACN 616 736 727
 Veris Australia Pty Ltd



Unitywater

2018013580-00
 STAGE 18A CAPESTONE ESTATE
 KINSELLES ROAD EAST, MANGO HILL
 AS-CONSTRUCTED SEWER

SHEET 2 OF 2 SHEETS	SCALE 1500
REVISION DATE 30/08/2019	REVISION A
DISCIPLINE CODE C	
DRAWING NO. U-2019-1030	