




**ENGINEER'S CERTIFICATION**

"I, DARRYL HAYTER  
 being a Consulting Engineer and duly authorised representative of: -  
 EMPOWER ENGINEERS & PROJECT MANAGERS Pty Ltd  
 hereby:-  
 # certify the information contained in this drawing is an accurate "as constructed" representation of the works;  
 # accept responsibility for the "as constructed" information contained in this drawing; and  
 # acknowledge the "as constructed" information contained in the drawing may be relied on by the MORETON BAY REGIONAL COUNCIL and others.  
 Certification for Stage 18A by *D. Hayter* on 17/09/19.  
 For: EMPOWER ENGINEERS & PROJECT MANAGERS Pty Ltd.  
 RPEQ No: 5694.

**LEGEND**

- New Hydrant
- New Isolation Valve
- New End Cap
- New Scour Valve
- New Taper
- New Water Service Conduit (Ø100 uPVC PN9)
- New Water Meter
- New Water House connection

Registered Surveyor's certification  
 We, VERIS AUSTRALIA Pty Ltd, hereby certify that the vertical and horizontal locations, and dimensions shown on this plan are a true and correct record and were located by survey.  
*A. J. ...* 6448 30/08/2019  
 Delegate Cadastral Surveyor Date

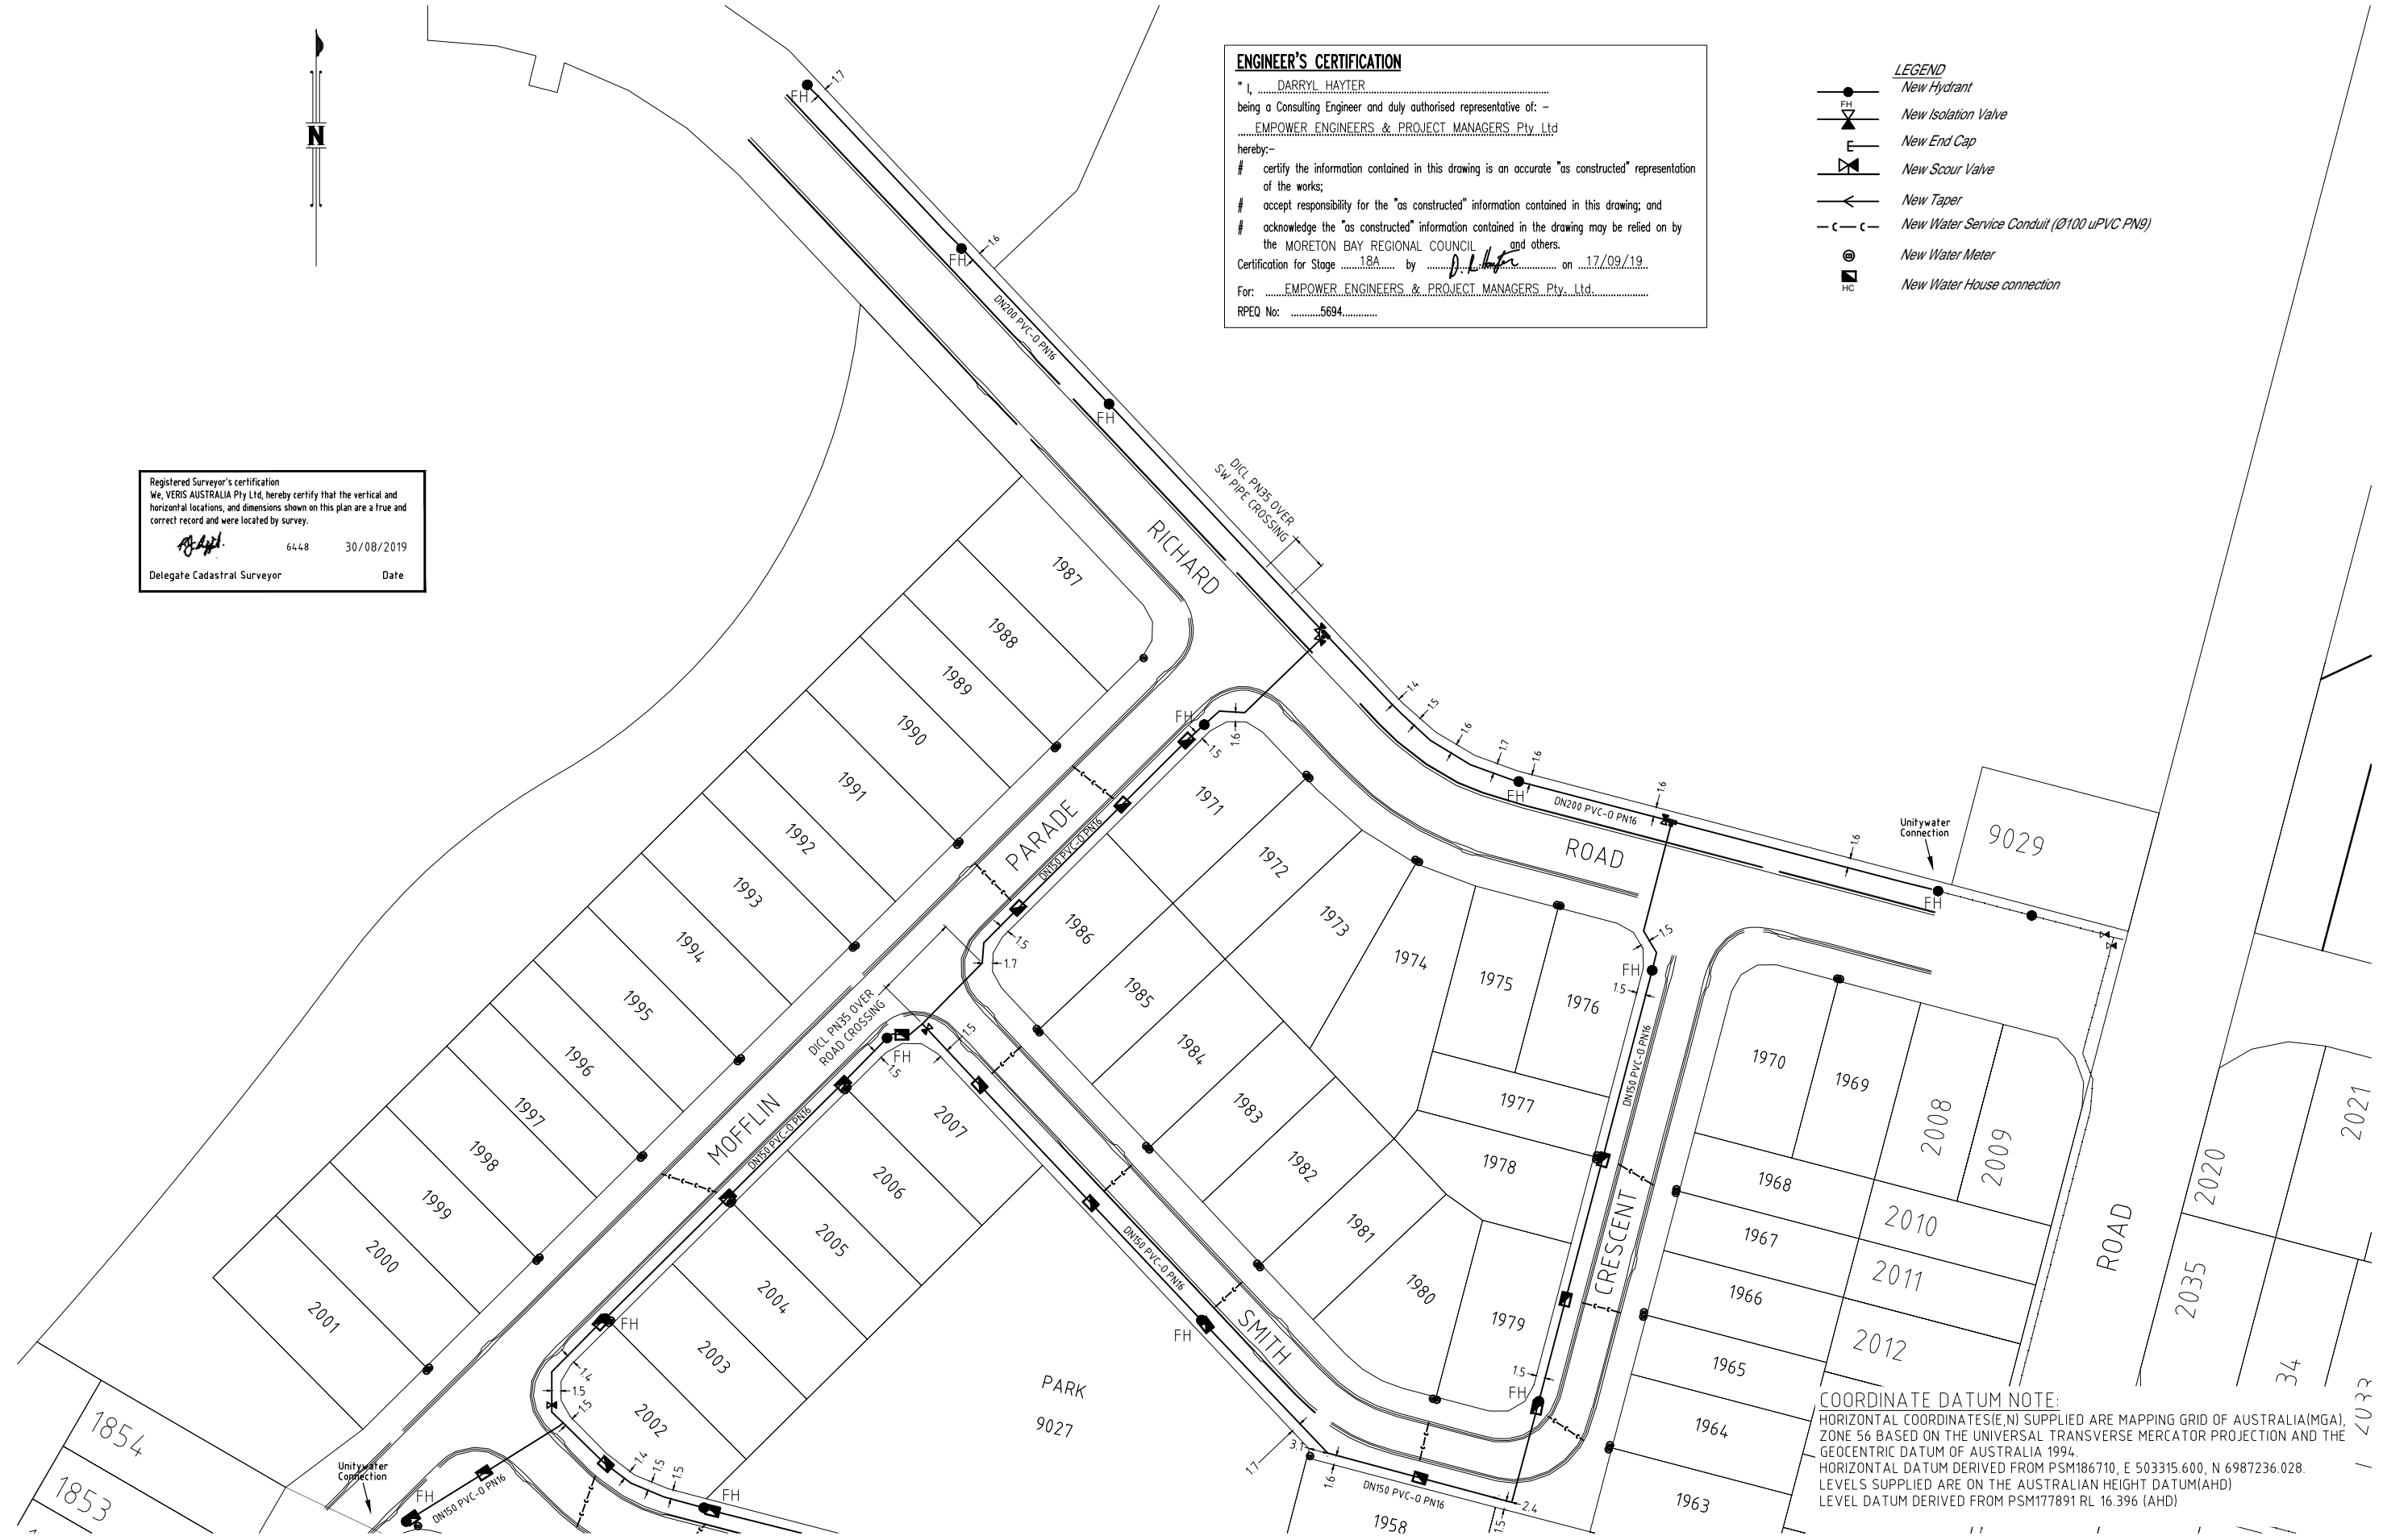

**COORDINATE DATUM NOTE:**  
 HORIZONTAL COORDINATES(E,N) SUPPLIED ARE MAPPING GRID OF AUSTRALIA(MGA), ZONE 56 BASED ON THE UNIVERSAL TRANSVERSE MERCATOR PROJECTION AND THE GEOCENTRIC DATUM OF AUSTRALIA 1994.  
 HORIZONTAL DATUM DERIVED FROM PSM186710, E 503315 600, N 6987236.028.  
 LEVELS SUPPLIED ARE ON THE AUSTRALIAN HEIGHT DATUM(AHD)  
 LEVEL DATUM DERIVED FROM PSM177891 RL 16.396 (AHD)

A1

INDEX	DATE	REVISIONS	DRAWN	CHECKED	PASSED	INITIALS	DATE
A	30/08/2019	ORIGINAL	JMc	JMc			

DRAWN	CHECKED	PASSED	INITIALS	DATE
JMc	JMc			30/08/2019



BRISBANE 071 308 4700  
 MACKAY 071 481 2011  
 WHITSUNDAYS 071 448 1722  
 CAIRNS 071 405 8722  
 veris.com.au  
 ACN 615 735 727  
 Veris Australia Pty Ltd



**Unitywater**


2018013580-00  
 STAGE 18A CAPESTONE ESTATE  
 KINSELLES ROAD EAST, MANGO HILL  
 AS-CONSTRUCTED WATER

SHEET 1 OF 2 SHEETS	SCALE 1500
REVISION DATE 30/08/2019	REVISION A
DISCIPLINE CODE C	
DRAWING NO. U-2019-1030-AW	

- LEGEND**
- New Hydrant
  - New Isolation Valve
  - New End Cap
  - New Scour Valve
  - New Taper
  - New Water Service Conduit (Ø100 uPVC PN9)
  - New Water Meter
  - New Water House connection

Registered Surveyor's certification  
 We, VERIS AUSTRALIA Pty Ltd, hereby certify that the vertical and horizontal locations, and dimensions shown on this plan are a true and correct record and were located by survey.

*Darryl Hayter* 6448 30/08/2019  
 Delegate Cadastral Surveyor Date

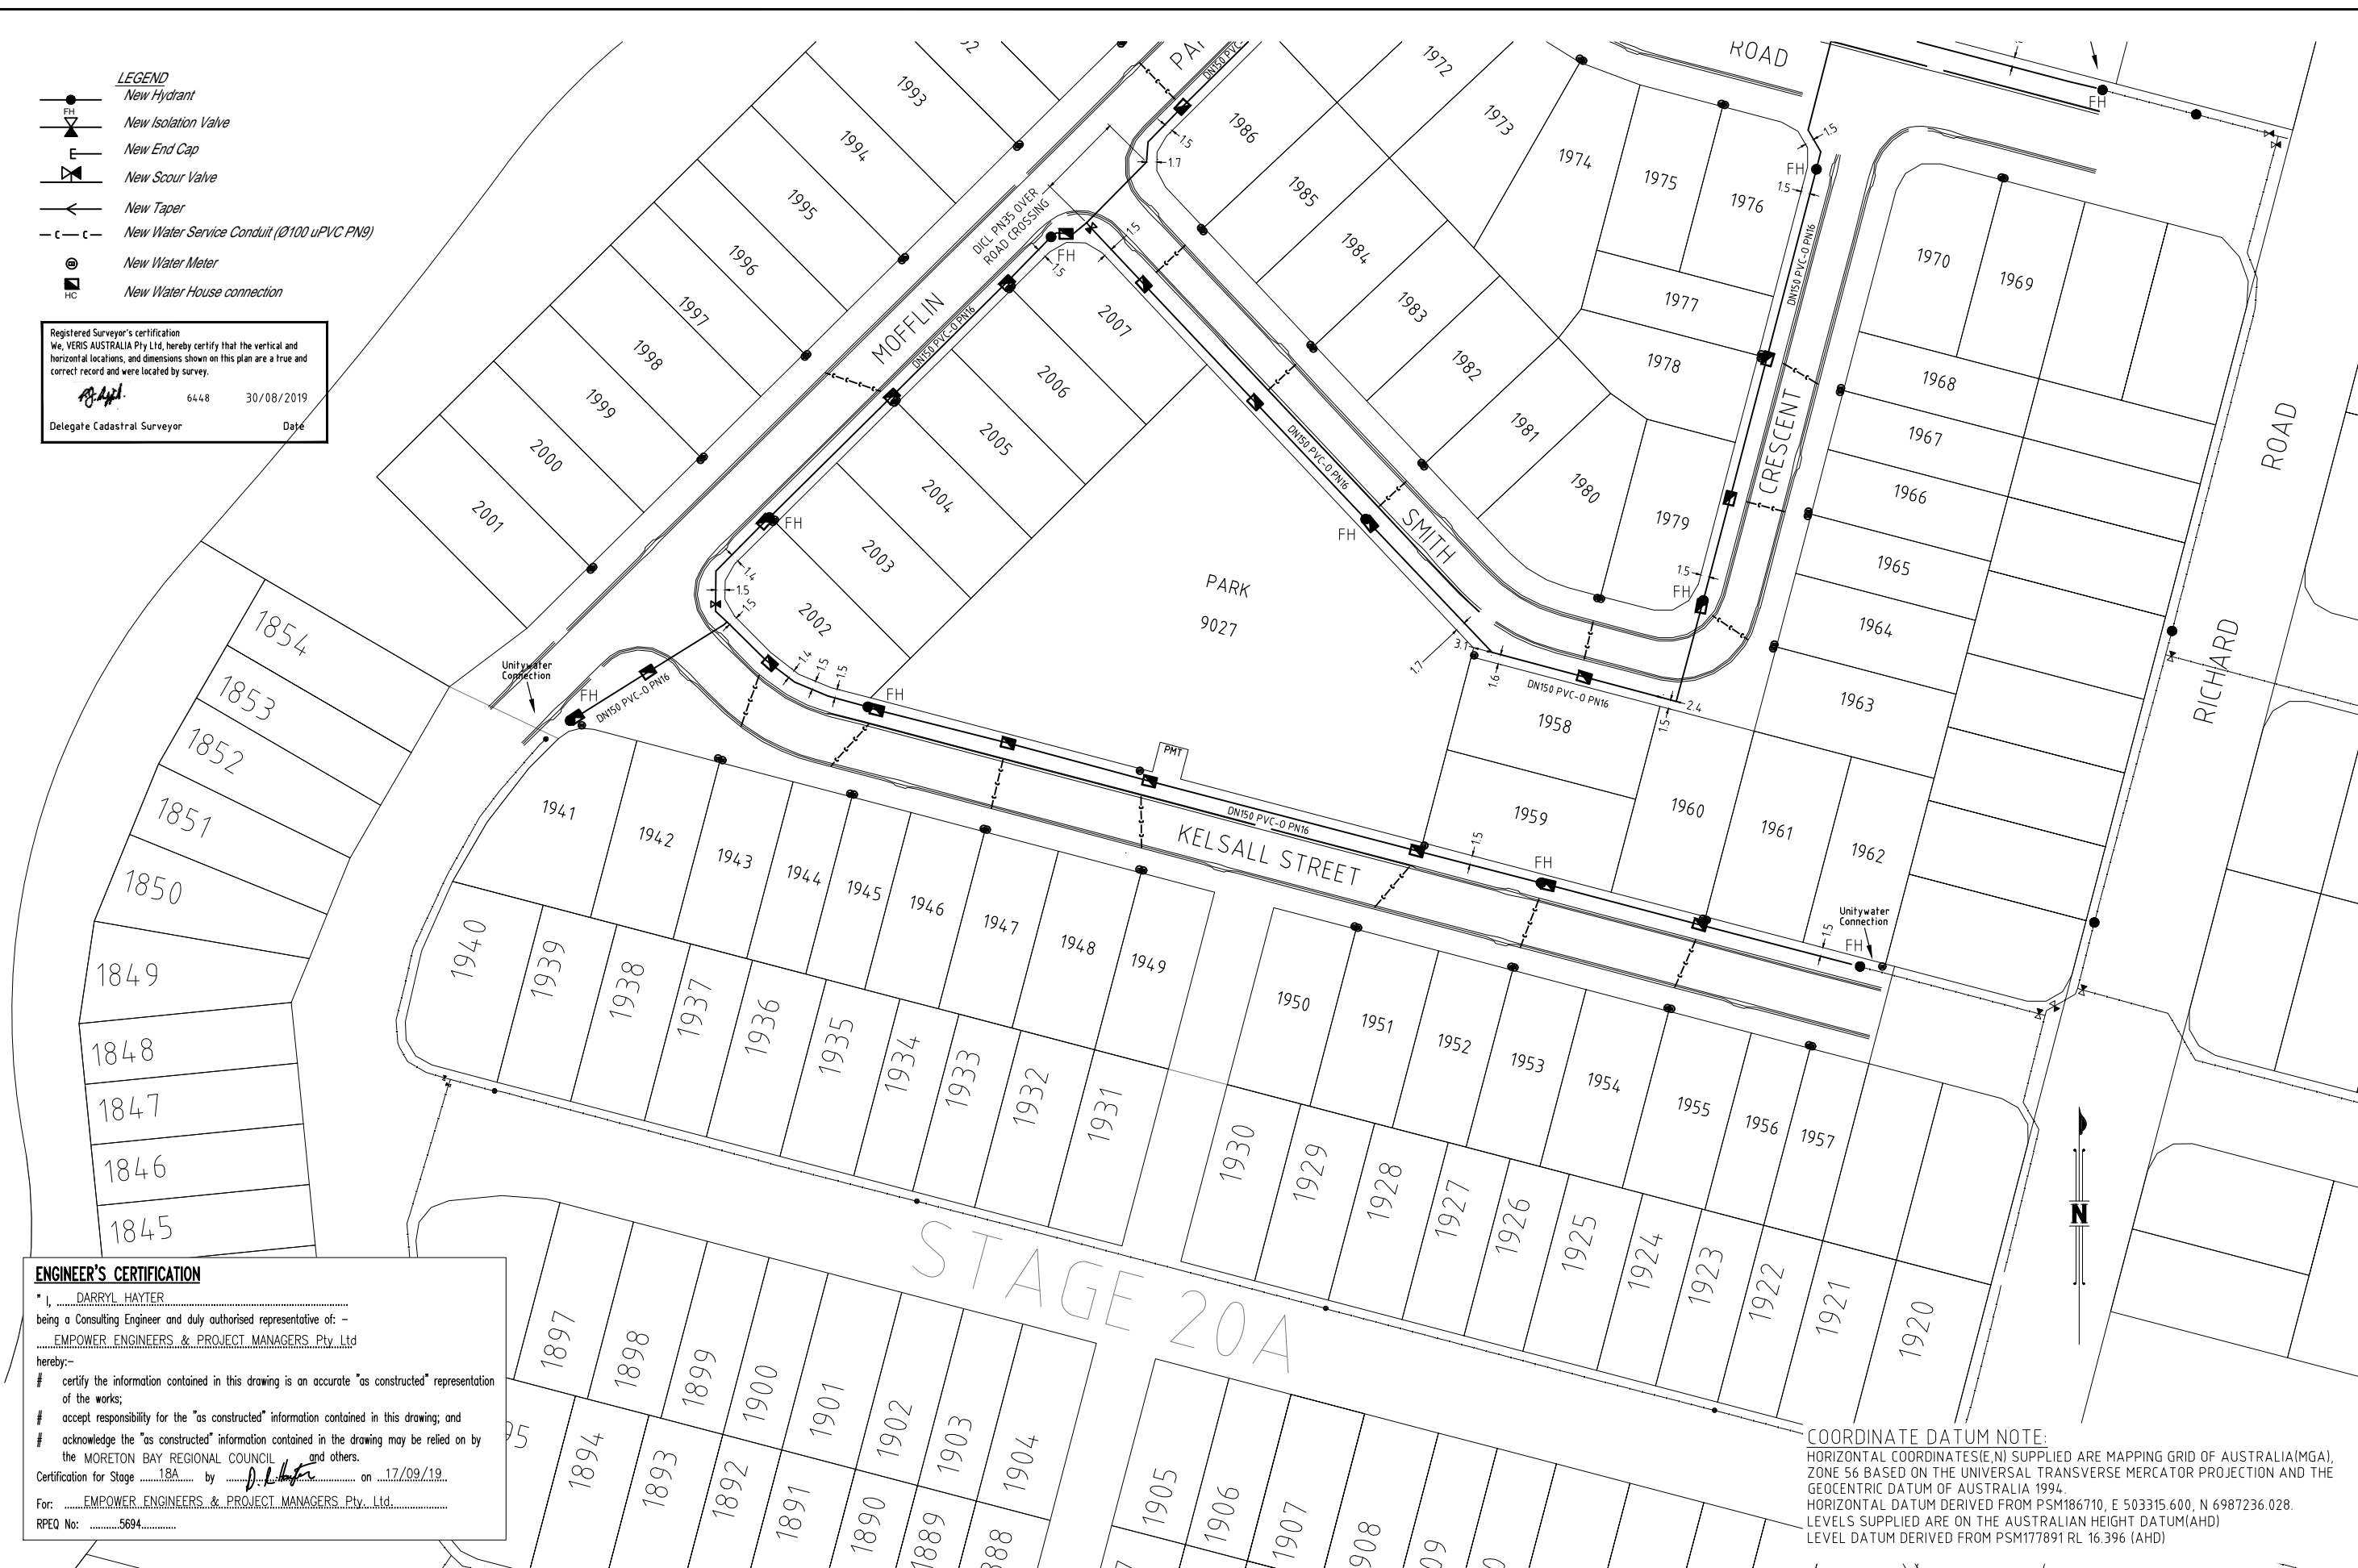

**ENGINEER'S CERTIFICATION**

\* I, DARRYL HAYTER  
 being a Consulting Engineer and duly authorised representative of: -  
EMPOWER ENGINEERS & PROJECT MANAGERS Pty Ltd  
 hereby:-  
 # certify the information contained in this drawing is an accurate "as constructed" representation of the works;  
 # accept responsibility for the "as constructed" information contained in this drawing; and  
 # acknowledge the "as constructed" information contained in the drawing may be relied on by the MORETON BAY REGIONAL COUNCIL and others.  
 Certification for Stage 18A by D. Hayter on 17/09/19  
 For: EMPOWER ENGINEERS & PROJECT MANAGERS Pty Ltd  
 RPEQ No: 5694

**COORDINATE DATUM NOTE:**  
 HORIZONTAL COORDINATES(E,N) SUPPLIED ARE MAPPING GRID OF AUSTRALIA(MGA), ZONE 56 BASED ON THE UNIVERSAL TRANSVERSE MERCATOR PROJECTION AND THE GEOCENTRIC DATUM OF AUSTRALIA 1994.  
 HORIZONTAL DATUM DERIVED FROM PSM186710, E 503315 600, N 6987236 028.  
 LEVELS SUPPLIED ARE ON THE AUSTRALIAN HEIGHT DATUM(AHD)  
 LEVEL DATUM DERIVED FROM PSM177891 RL 16.396 (AHD)

**A1**

INDEX	DATE	ORIGINAL	REVISIONS	DRAWN	CHECKED	PASSED
A	30/08/2019	ORIGINAL		JMc	JMc	

DRAWN	CHECKED	PASSED	INITIALS	DATE
JMc	JMc			30/08/2019



BRISBANE (07) 206 4300  
 MACKAY (07) 4651 2011  
 PROSERPINE (07) 4661 7122  
 CARNS (07) 4651 6722  
 veris.com.au  
 ACN 604 671 374  
 Queensland Surveying Pty Ltd a Veris Company



**Unitywater**  
 U-201813580-00  
 STAGE 18A CAPESTONE ESTATE  
 KINSELLES ROAD EAST, MANGO HILL  
 AS-CONSTRUCTED WATER

SHEET 2 OF 2 SHEETS	SCALE 1500
REVISION DATE 30/08/2019	REVISION <b>A</b>
DISCIPLINE CODE <b>C</b>	
DRAWING NO. <b>U-2019-1030-AW</b>	