



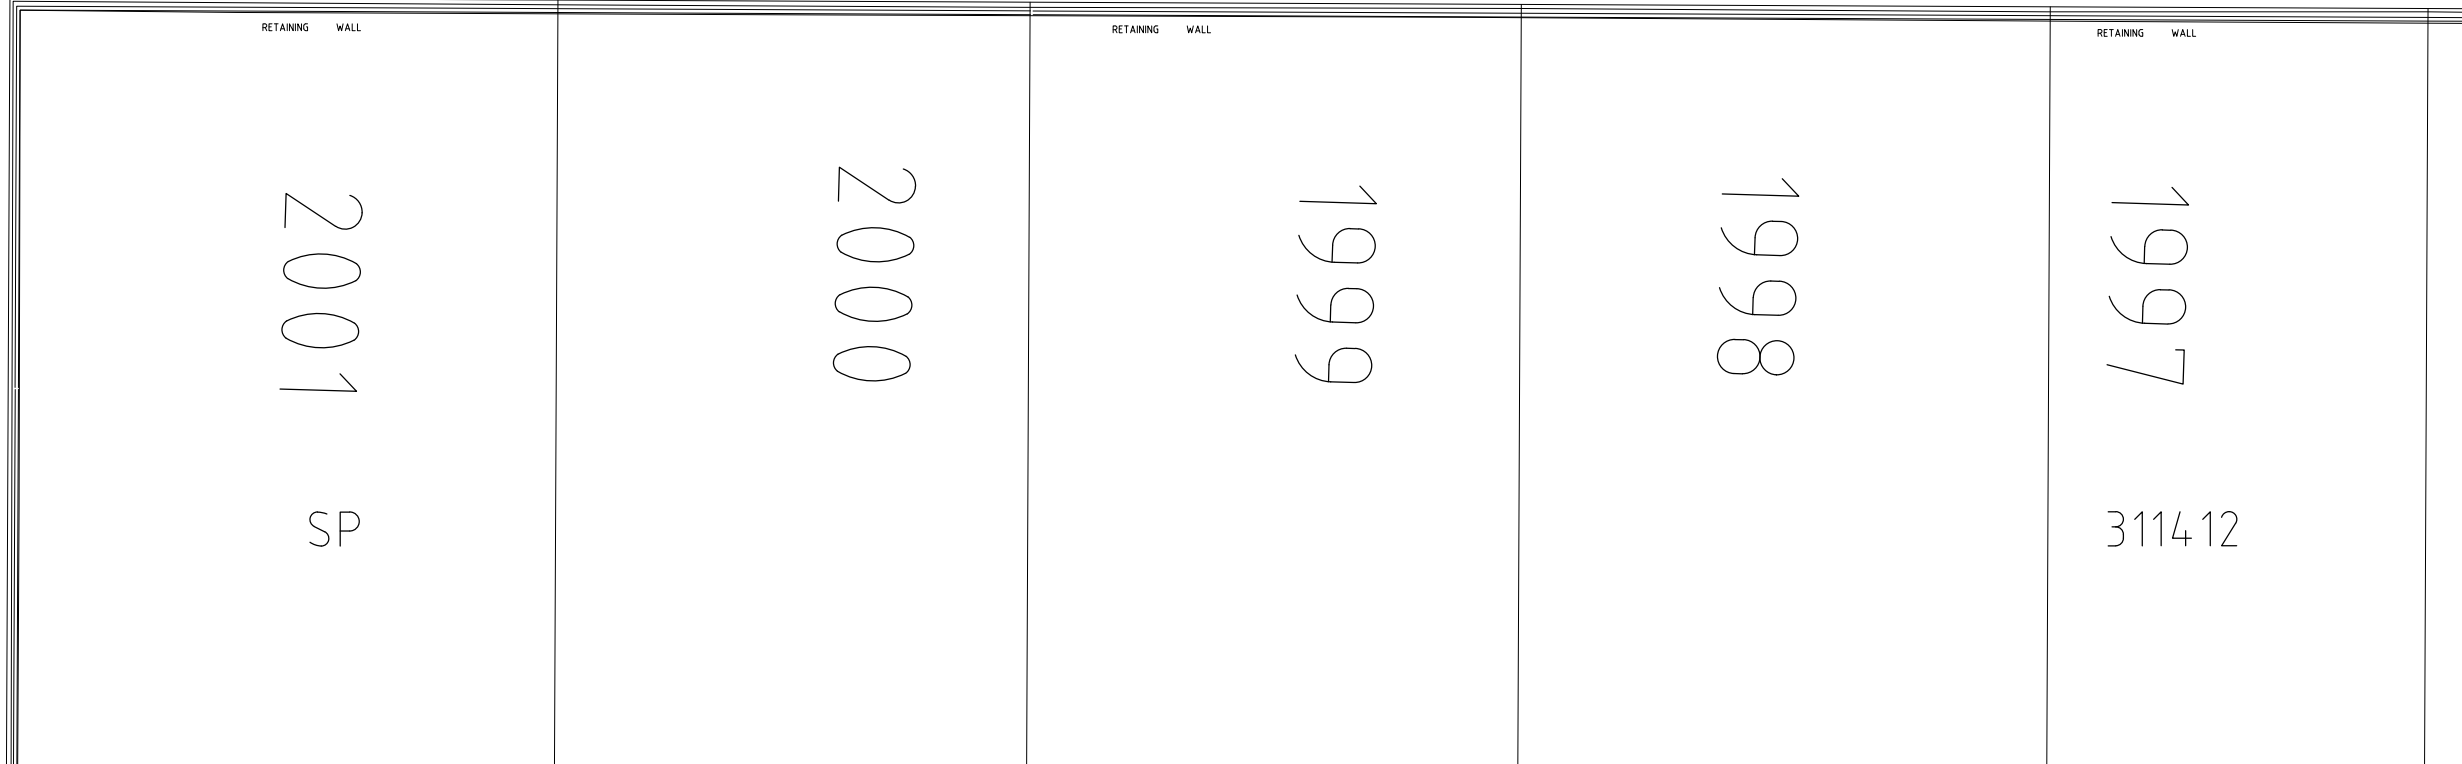

**ENGINEER'S CERTIFICATION**  
 I, DARRYL HAYTER  
 being a Consulting Engineer and duly authorised representative of: -  
EMPOWER ENGINEERS & PROJECT MANAGERS Pty Ltd  
 hereby:-  
 # certify the information contained in this drawing is an accurate "as constructed" representation of the works;  
 # accept responsibility for the "as constructed" information contained in this drawing; and  
 # acknowledge the "as constructed" information contained in the drawing may be relied on by the MORETON BAY REGIONAL COUNCIL and others.  
 Certification for Stage 18A by D. Hayter on 5/11/19  
 For: EMPOWER ENGINEERS & PROJECT MANAGERS Pty. Ltd.  
 RPEQ No: 5694

**Registered Surveyor's Certification.**  
 We, Veris Australia Pty Ltd hereby certify that the horizontal and vertical locations, and dimensions shown on this plan are a true and correct record of the As Constructed information.  
 Signed: [Signature] Cadastral Surveyor & Delegate Reg. No 6448 Dated 31/10/2018

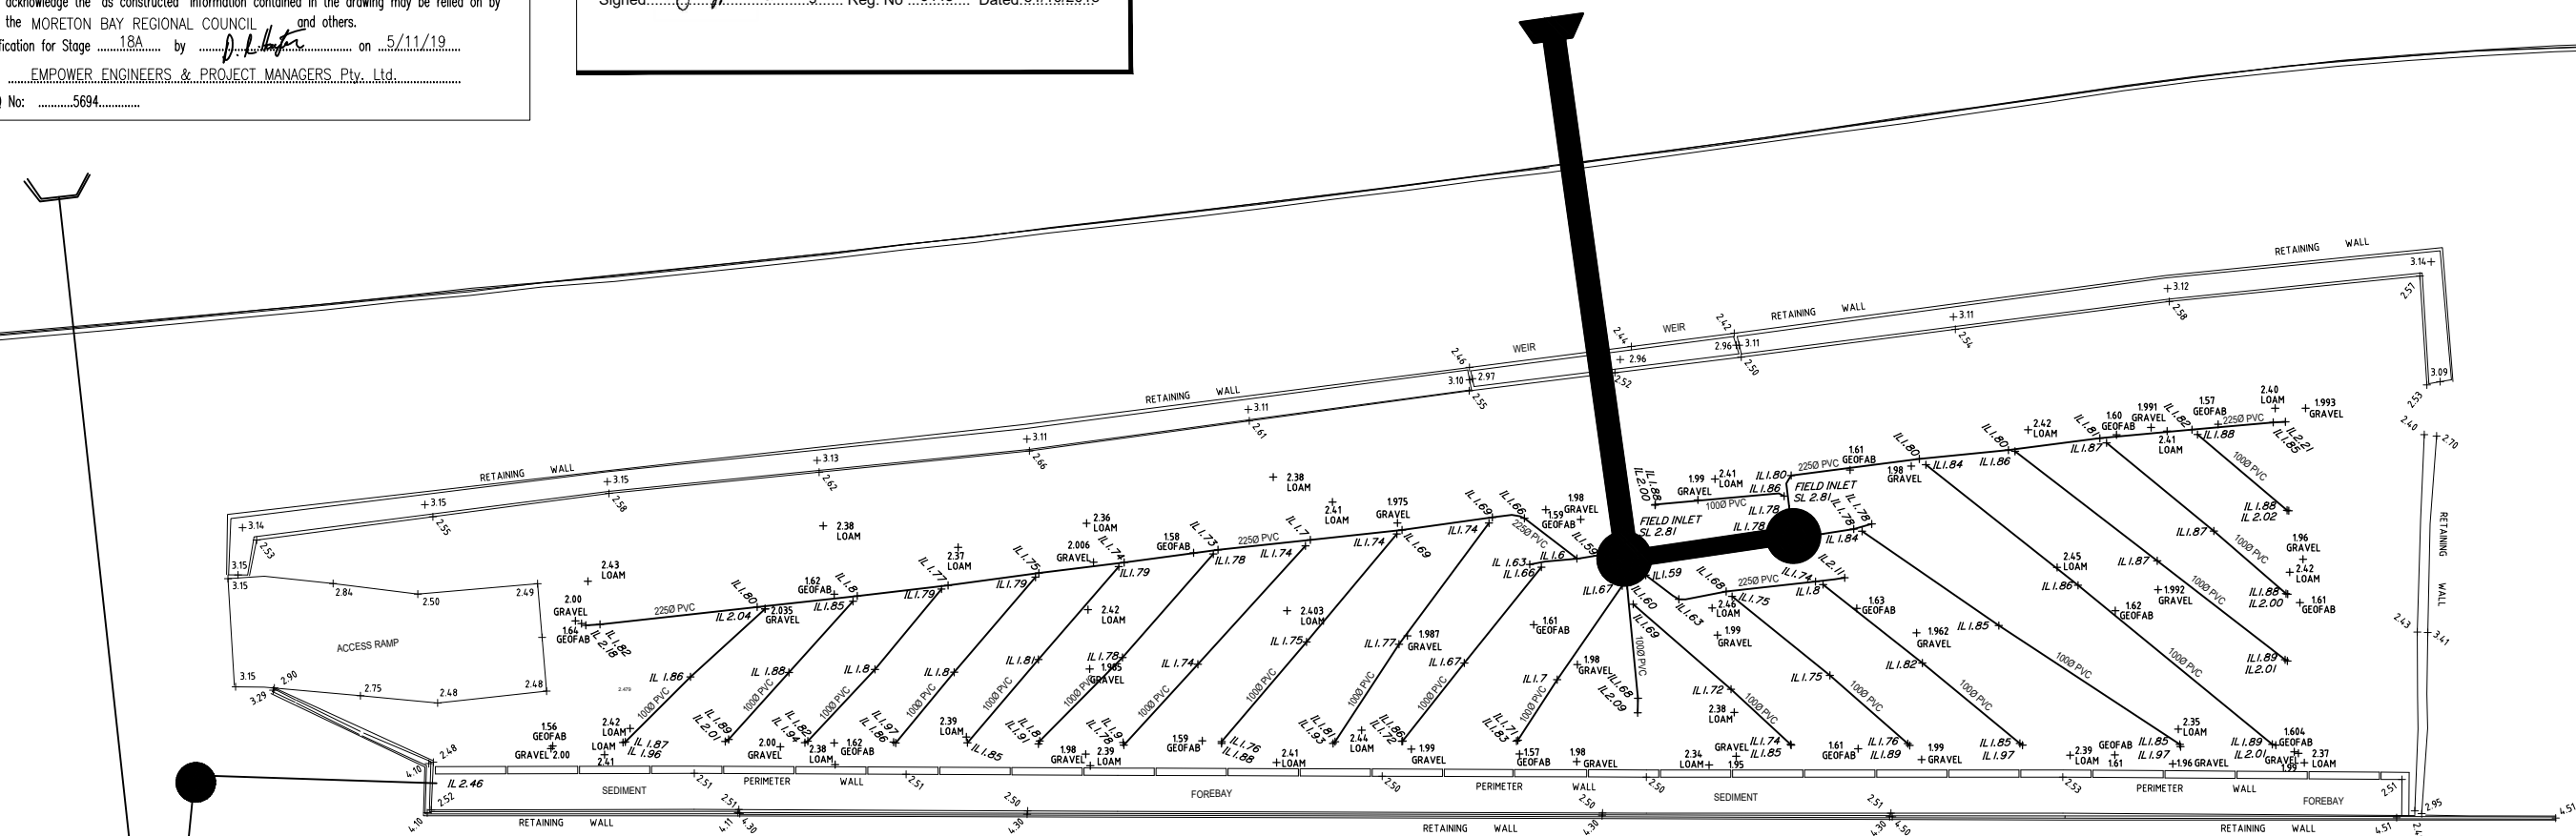

DRAWING REVISIONS		REFERENCE DRAWINGS		DESIGN FILE No.	DESIGNED	SCALE 1:100	ORIGINAL SIZE A1		<b>MORETON BAY REGIONAL COUNCIL</b> CABOOLTURE DISTRICT OFFICE 2 HASKING STREET CABOOLTURE QLD 4510 PO BOX 159 CABOOLTURE QLD 4510 Telephone: (07) 5433 0100 Fax: (07) 5433 4000	MBRC SUBDIVISION REFERENCE	
REV.	REVISION DESCRIPTION	DRG. No.	DESCRIPTION	CONSTRUCT. No.	DATE					DA/36647/2018/V23R	No. 1 OF 1 PLANS
A	Progress Plot			30105-18A100AB02	JMc					DRAWING NUMBER	REV.
				FIELD BOOK	04/09/2019					30105-18A100 AB D2	A
				LOG BOOK							
				LEVEL DATUM	AHD						
				DATUM	PM177891						