




Registered Surveyor's certification
We, VERIS AUSTRALIA Pty Ltd, hereby certify that the vertical and horizontal locations, and dimensions shown on this plan are a true and correct record and were located by survey.

Alistair Byrom 6448 26/02/2021
Delegate Cadastral Surveyor Date

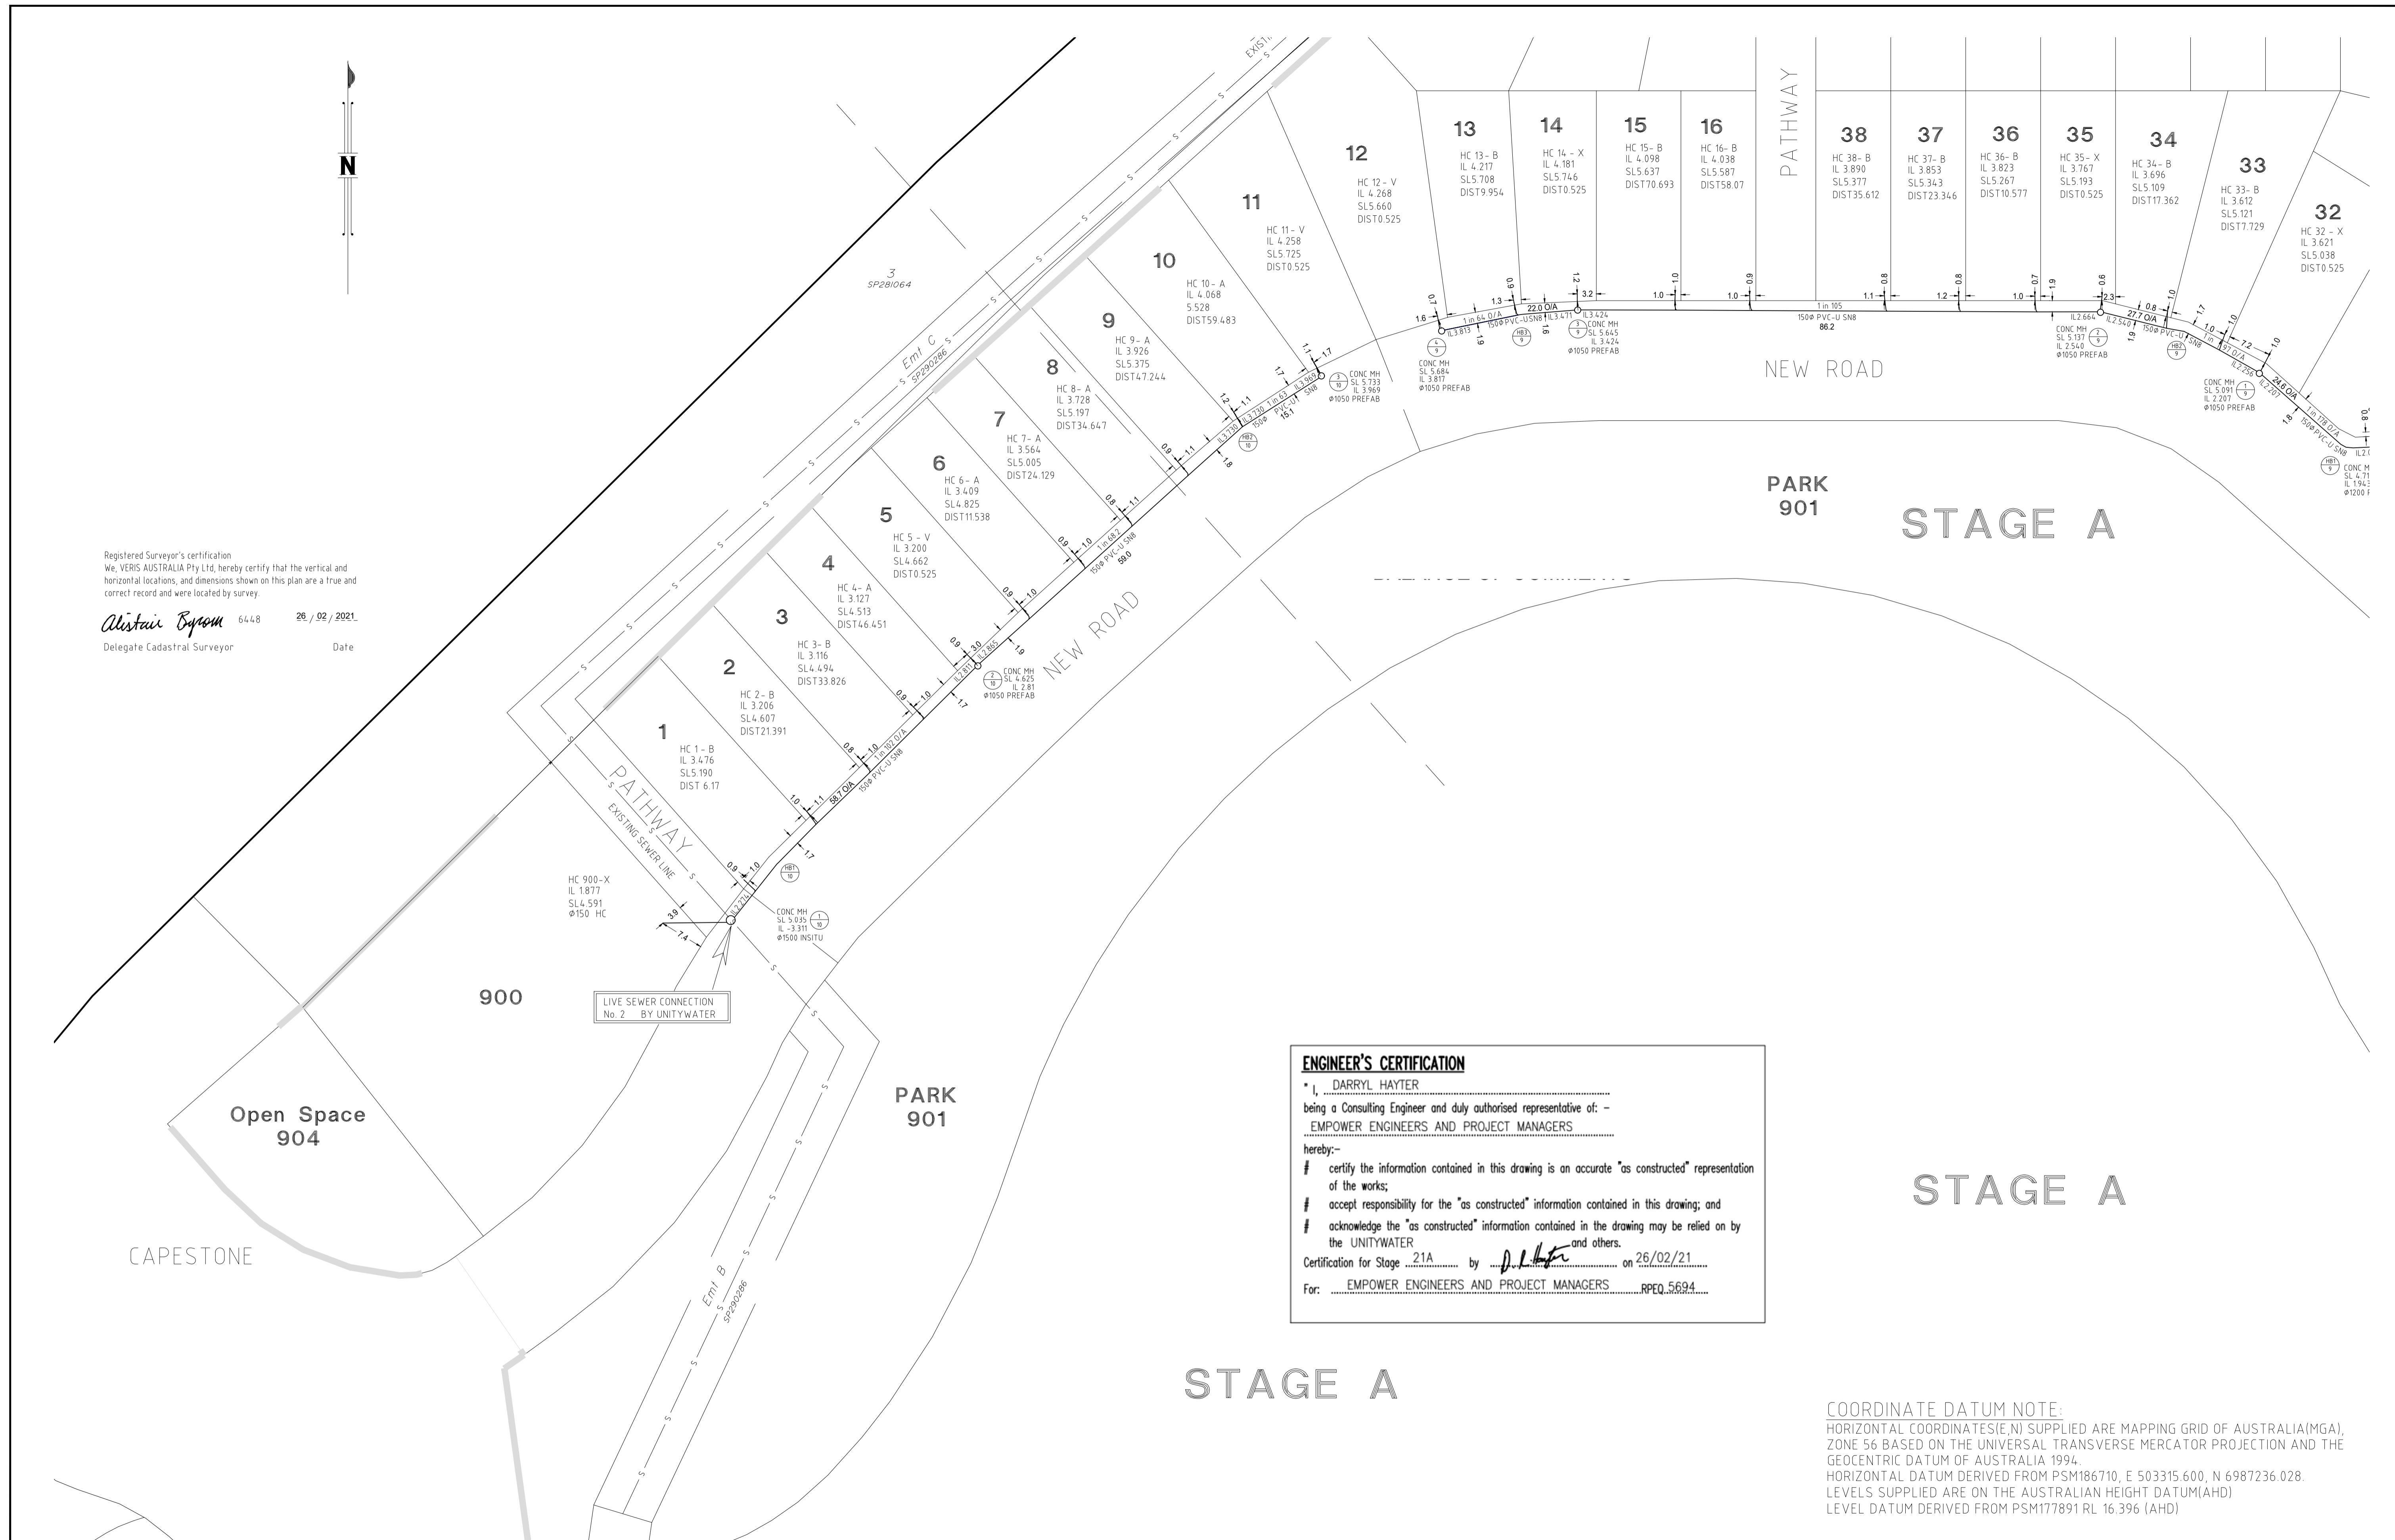

ENGINEER'S CERTIFICATION
 I, DARRYL HAYTER
 being a Consulting Engineer and duly authorised representative of: -
EMPOWER ENGINEERS AND PROJECT MANAGERS
 hereby:-
 # certify the information contained in this drawing is an accurate "as constructed" representation of the works;
 # accept responsibility for the "as constructed" information contained in this drawing; and
 # acknowledge the "as constructed" information contained in the drawing may be relied on by the UNITYWATER and others.
 Certification for Stage 21A by [Signature] on 26/02/21
 For: EMPOWER ENGINEERS AND PROJECT MANAGERS RPEQ 5694

STAGE A

COORDINATE DATUM NOTE:
 HORIZONTAL COORDINATES(E,N) SUPPLIED ARE MAPPING GRID OF AUSTRALIA(MGA), ZONE 56 BASED ON THE UNIVERSAL TRANSVERSE MERCATOR PROJECTION AND THE GEOCENTRIC DATUM OF AUSTRALIA 1994.
 HORIZONTAL DATUM DERIVED FROM PSM186710, E 503315 600, N 6987236 028.
 LEVELS SUPPLIED ARE ON THE AUSTRALIAN HEIGHT DATUM(AHD)
 LEVEL DATUM DERIVED FROM PSM177891 RL 16.396 (AHD)

A1	A	25/02/2021	ORIGINAL	JMc	JMc	PASSED	JMc	JMc	
	INDEX	DATE	REVISIONS	DRAWN	CHECKED	PASSED	INITIALS	DATE	

DRAWN	JMc	25/02/2021
CHECKED	JMc	25/02/2021
PASSED		



BRISBANE (07) 5500 5700
 WHITSUNDAYS (07) 4484 9600
 MACKAY (07) 4567 8700
 CAIRNS (07) 4522 8400
 veris.com.au
 ACH 615 735 727
 Veris Australia Pty Ltd



Unitywater
 2019015600-S1
 STAGE 21 CAPESTONE ESTATE
 CAPESTONE BOULEVARD, MANGO HILL.
 AS-CONSTRUCTED SEWER

SHEET 1 OF 2 SHEETS	SCALE 1500
REVISION DATE 25/02/2021	REVISION A
DISCIPLINE CODE C	
DRAWING NO. U-2020-3215 S	

COORDINATE DATUM NOTE:
 HORIZONTAL COORDINATES(E,N) SUPPLIED ARE MAPPING GRID OF AUSTRALIA(MGA), ZONE 56 BASED ON THE UNIVERSAL TRANSVERSE MERCATOR PROJECTION AND THE GEOCENTRIC DATUM OF AUSTRALIA 1994.
 HORIZONTAL DATUM DERIVED FROM PSM186710, E 503315.600, N 6987236.028.
 LEVELS SUPPLIED ARE ON THE AUSTRALIAN HEIGHT DATUM(AHD)
 LEVEL DATUM DERIVED FROM PSM177891 RL 16.396 (AHD)




ENGINEER'S CERTIFICATION

I, DARRYL HAYTER
 being a Consulting Engineer and duly authorised representative of: -
EMPOWER ENGINEERS AND PROJECT MANAGERS
 hereby:-
 # certify the information contained in this drawing is an accurate "as constructed" representation of the works;
 # accept responsibility for the "as constructed" information contained in this drawing; and
 # acknowledge the "as constructed" information contained in the drawing may be relied on by the UNITYWATER
 Certification for Stage 21A by D. Hayter and others on 25/02/21
 For: EMPOWER ENGINEERS AND PROJECT MANAGERS RPEQ 5694


Registered Surveyor's certification
 We, VERIS AUSTRALIA Pty Ltd, hereby certify that the vertical and horizontal locations, and dimensions shown on this plan are a true and correct record and were located by survey.

Alistair Byron 6448 28/02/2021
 Delegate Cadastral Surveyor Date

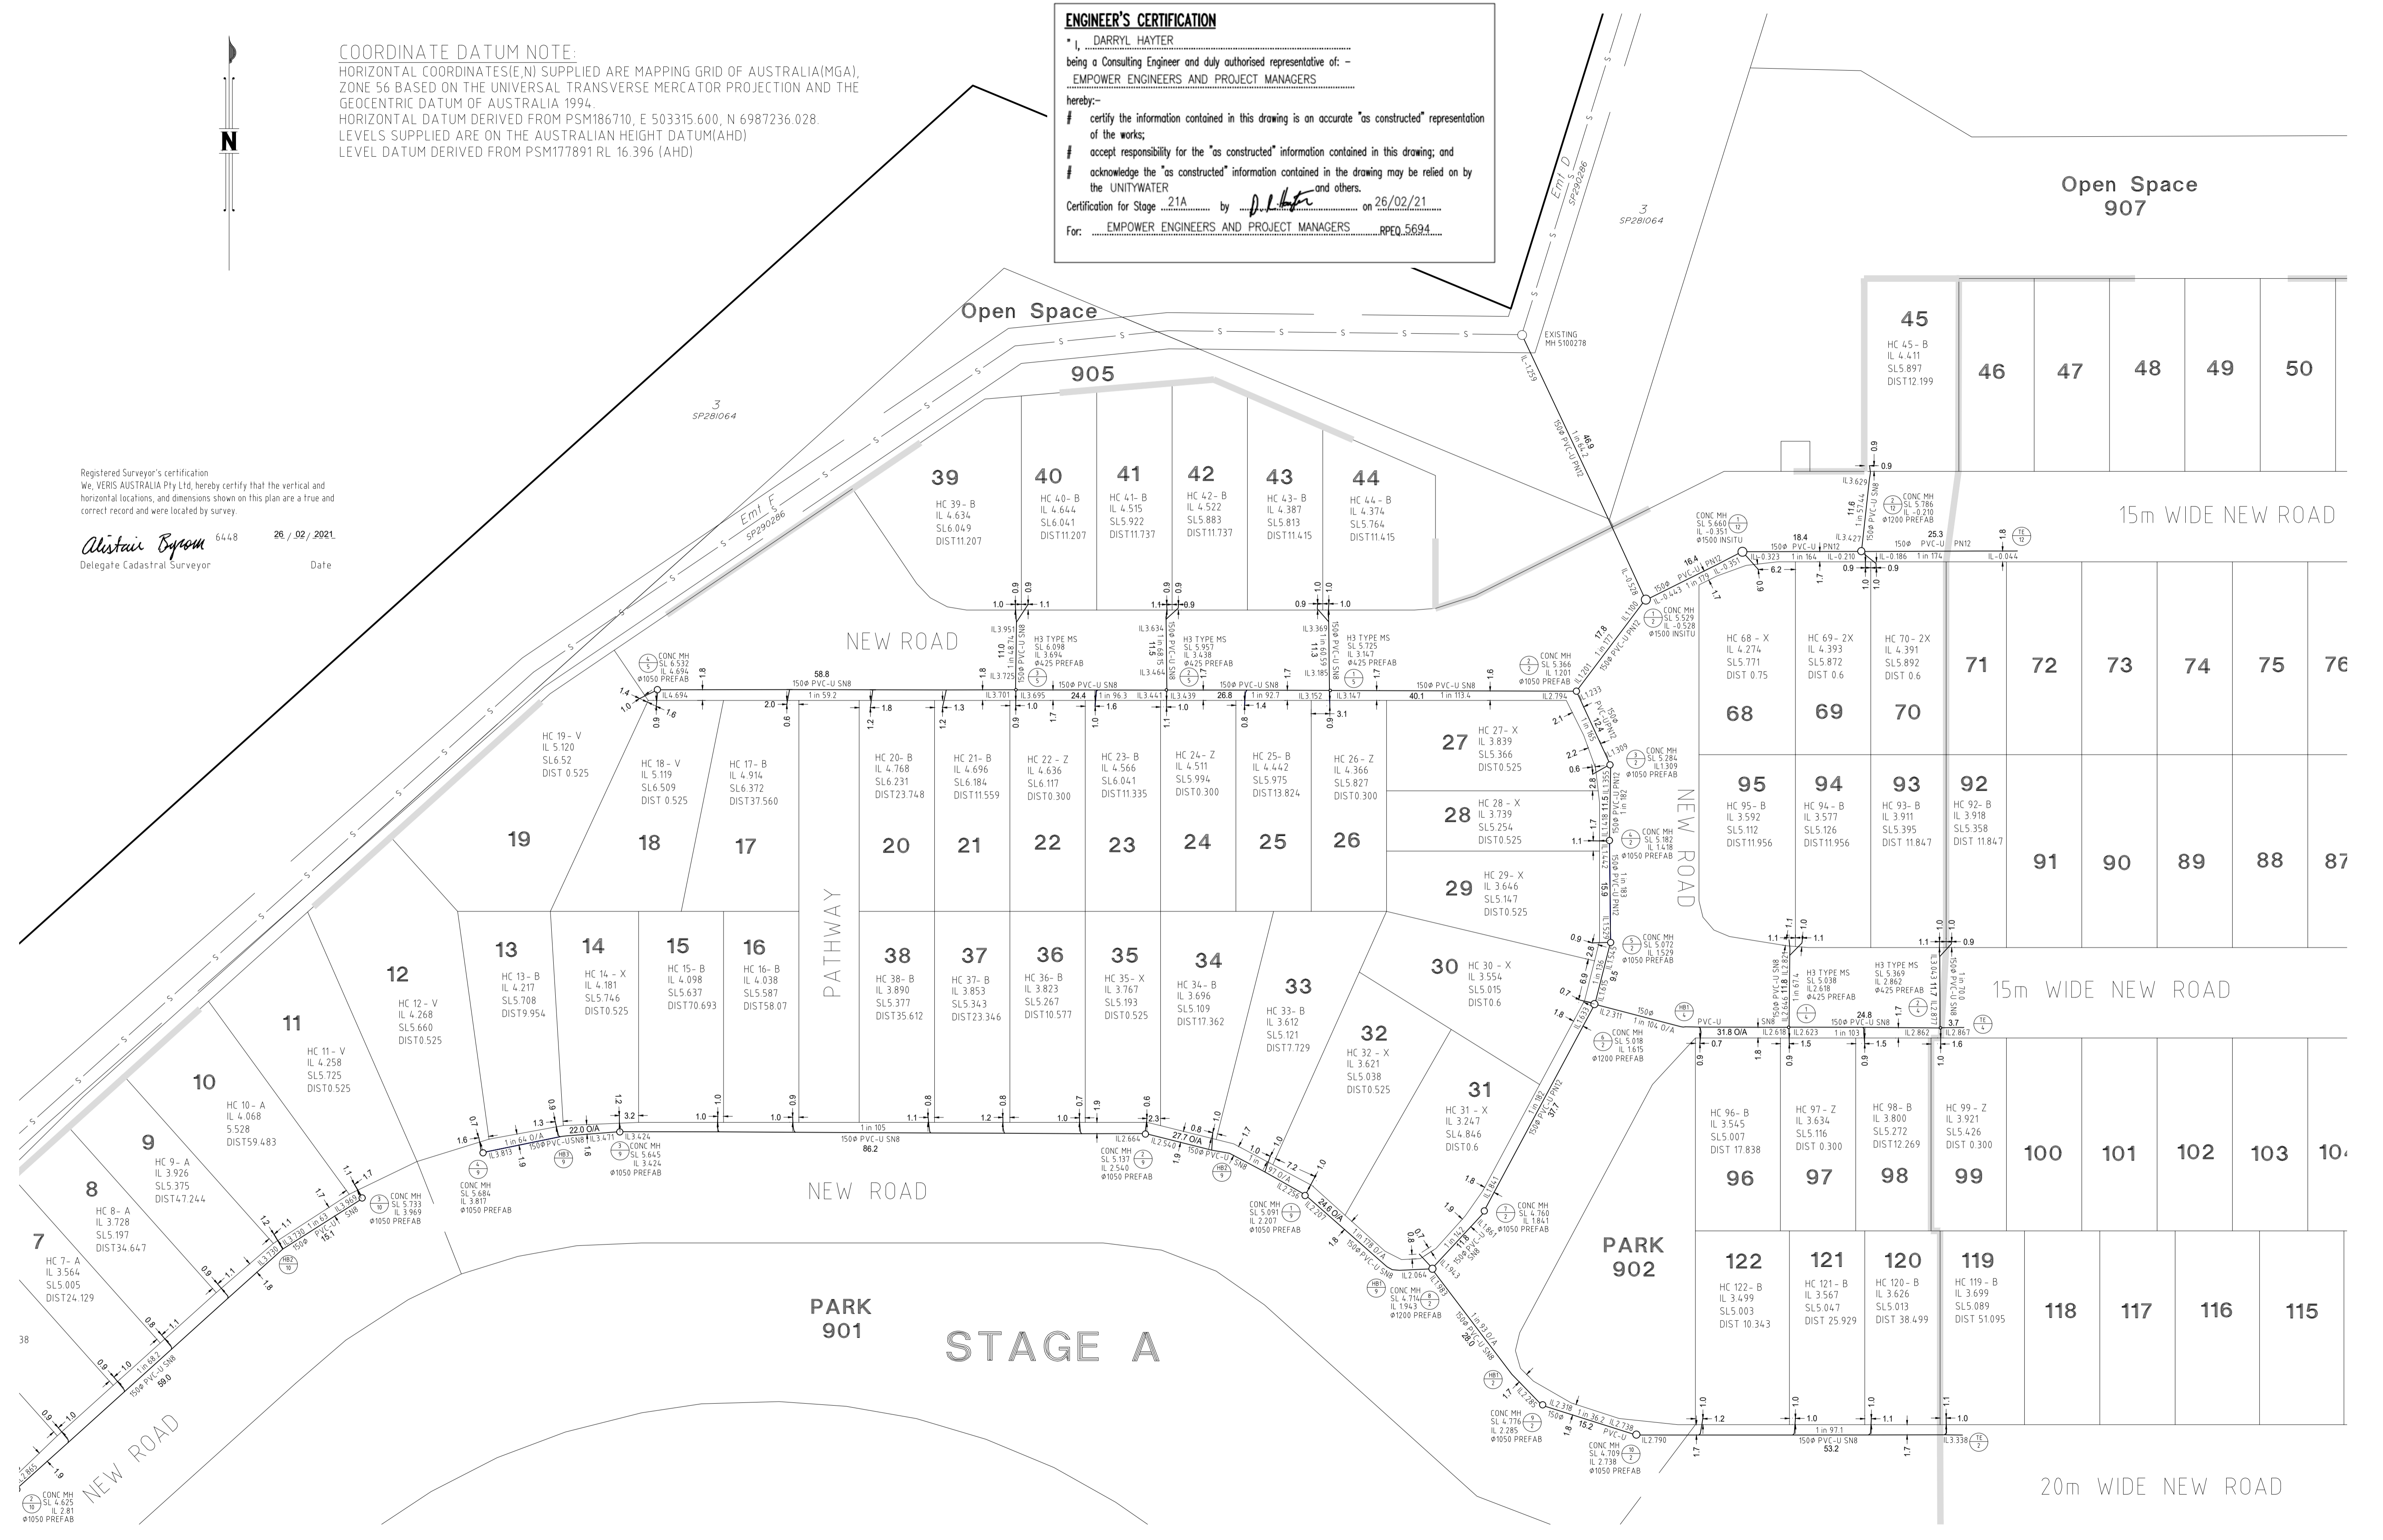

A1	INDEX	DATE	ORIGINAL	REVISIONS	DRAWN	CHECKED	PASSED	INITIALS	DATE
	A	25/02/2021	ORIGINAL		JMc	JMc			

DRAWN	JMc	25/02/2021
CHECKED	JMc	25/02/2021
PASSED		

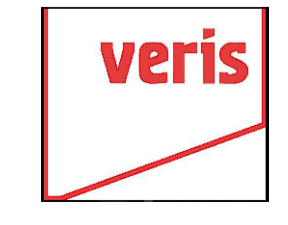

BRISBANE (07) 5500 0700
 MACKAY (07) 4067 0700
 WHITSUNDAYS (07) 4040 9000
 CAIRNS (07) 4052 9000
 veris.com.au
 ACH 615 735 727
 Veris Australia Pty Ltd



Unitywater
 2019015600-S1
 STAGE 21 CAPESTONE ESTATE
 CAPESTONE BOULEVARD, MANGO HILL.
 AS-CONSTRUCTED SEWER

SHEET 2 OF 2	SHEETS	SCALE 1:500
REVISION DATE	25/02/2021	REVISION A
DISCIPLINE CODE	C	
DRAWING NO.	U-2020-3215 S	