


ENGINEER'S CERTIFICATION

I, DARRYL HAYTER
 being a Consulting Engineer and duly authorised representative of: -
EMPOWER ENGINEERS AND PROJECT MANAGERS
 hereby:-
 # certify the information contained in this drawing is an accurate "as constructed" representation of the works;
 # accept responsibility for the "as constructed" information contained in this drawing; and
 # acknowledge the "as constructed" information contained in the drawing may be relied on by the UNITY WATER
 Certification for Stage 12B2 by D.H. on 25/02/21
 For: EMPOWER ENGINEERS AND PROJECT MANAGERS RPEQ 5694

NOTE-
 CONNECTION OF NEW WATER METERS TO
 EXISTING MAIN WAS DONE BY
 UNITYWATER.

UNITYWATER CONNECTION

MADDEN RD

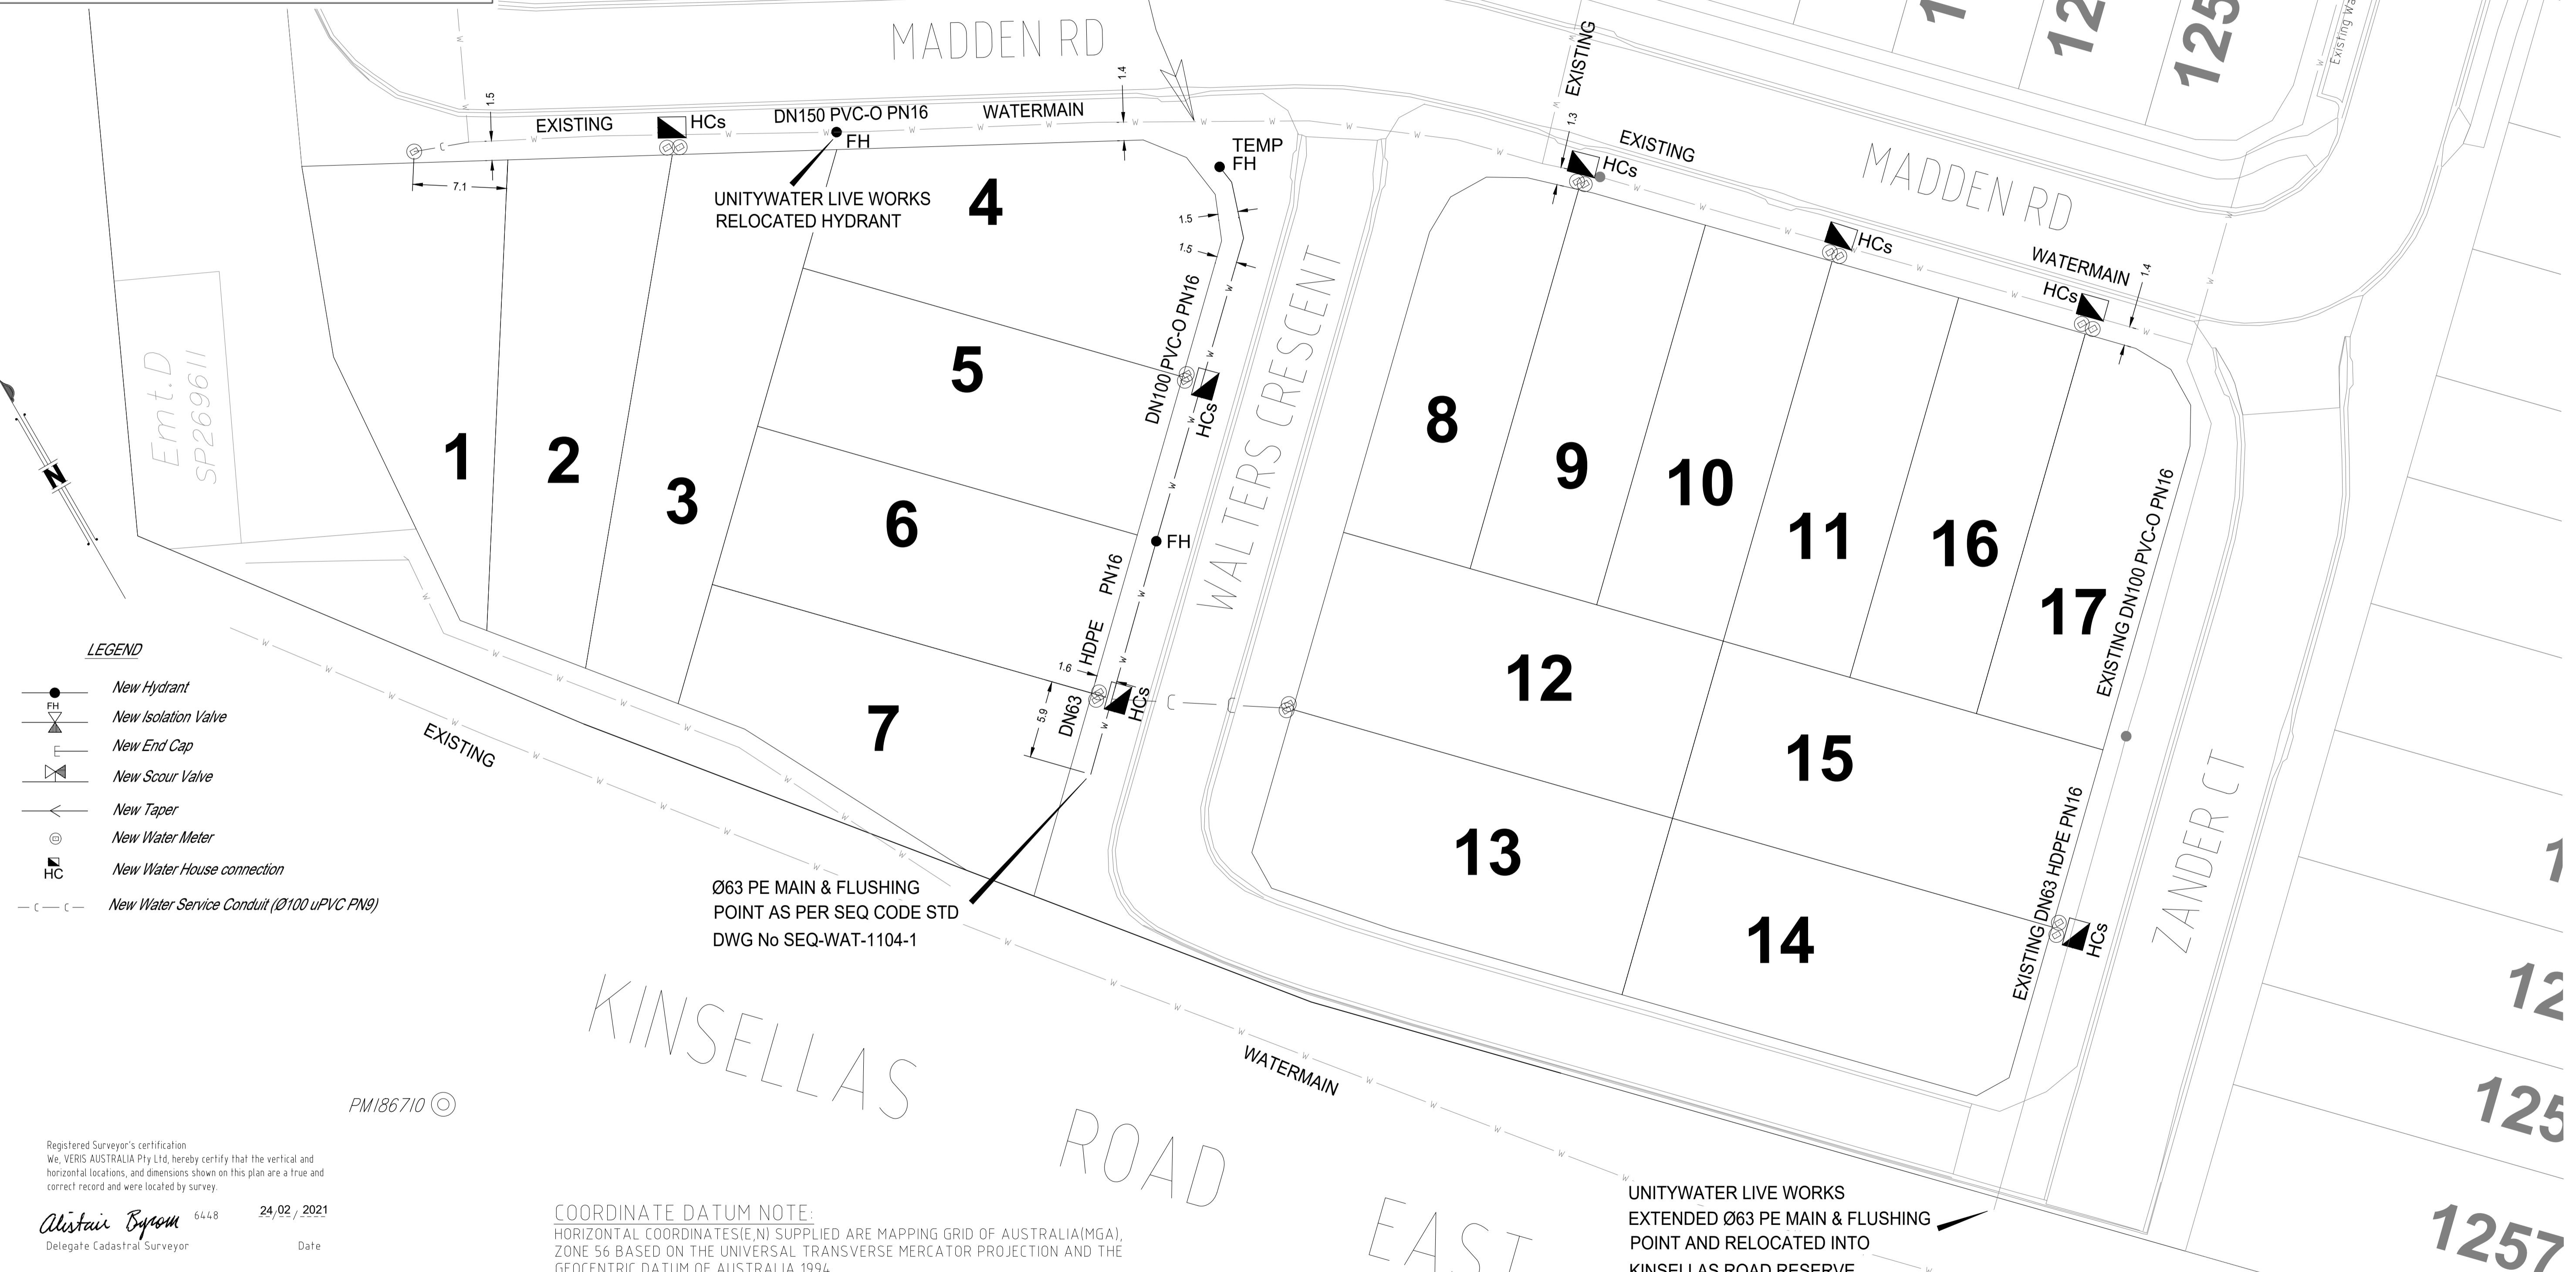

LEGEND

- New Hydrant
- New Isolation Valve
- New End Cap
- New Scour Valve
- New Taper
- New Water Meter
- New Water House connection
- New Water Service Conduit (Ø100 uPVC PN9)

Ø63 PE MAIN & FLUSHING
 POINT AS PER SEQ CODE STD
 DWG No SEQ-WAT-1104-1

UNITYWATER LIVE WORKS
 EXTENDED Ø63 PE MAIN & FLUSHING
 POINT AND RELOCATED INTO
 KINSELLAS ROAD RESERVE

COORDINATE DATUM NOTE:
 HORIZONTAL COORDINATES(E,N) SUPPLIED ARE MAPPING GRID OF AUSTRALIA(MGA),
 ZONE 56 BASED ON THE UNIVERSAL TRANSVERSE MERCATOR PROJECTION AND THE
 GEOCENTRIC DATUM OF AUSTRALIA 1994.
 HORIZONTAL DATUM DERIVED FROM PSM186710, E 503315.600, N 6987236.028.
 LEVELS SUPPLIED ARE ON THE AUSTRALIAN HEIGHT DATUM(AHD)
 LEVEL DATUM DERIVED FROM PSM177891 RL 16.396 (AHD)




AS CONSTRUCTED

Registered Surveyor's certification
 We, VERIS AUSTRALIA Pty Ltd, hereby certify that the vertical and
 horizontal locations, and dimensions shown on this plan are a true and
 correct record and were located by survey.
Alistair Byrom 6448 24/02/2021
 Delegate Cadastral Surveyor Date

A1

INDEX	DATE	REVISIONS	DRAWN	CHECKED	PASSED	INITIALS	DATE
A	15/02/2021	ORIGINAL	JMc	JMc			

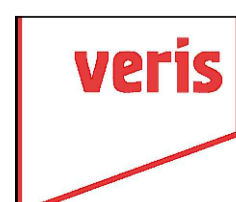

BRISBANE 071 3000 4700
 MACKAY 071 4917 8700
 WHITSUNDAYS 071 4943 8600
 CAIRNS 071 4552 8400
 veris.com.au
 ACN 604 671 374
 Queensland Surveying Pty Ltd, a Veris Company



Unitywater

UW2020016868
 STAGE 12B2 CAPESTONE ESTATE
 KINSELLAS ROAD EAST, MANGO HILL
 AS-CONSTRUCTED WATER

SHEET 1 OF 1 SHEETS	SCALE 1:250 @A1
REVISION DATE 15/02/2021	REVISION A
DISCIPLINE CODE C	
DRAWING NO. U-2020-3345 W	