



NOTES:
 • All mains Ø150 PVC-O PN16 unless noted otherwise.

REGISTERED SURVEYOR'S CERTIFICATION


We, Queensland Surveying Pty Ltd (ACN 604 671 374) Cadastral Surveyors, hereby certify that the vertical and horizontal locations and dimensions shown on this plan are a true and correct record and were located by survey.
 Delegate (signature) *[Signature]* 6152 9/3/16
 Registration ID Date

- LEGEND**
- New Hydrant
 - New Isolation Valve
 - New End Cap
 - New Scour Valve
 - New Reducer
 - New Water Conduit
 - New Water Meter
 - New Water House connection

ENGINEER'S CERTIFICATION

I, David Polden
 being a Consulting Engineer and duly authorised representative of: -
 BMD Consulting
 hereby:
 # certify the information contained in this drawing is an accurate "as constructed" representation of the works;
 # accept responsibility for the "as constructed" information contained in this drawing; and
 # acknowledge the "as constructed" information contained in the drawing may be relied on by the Moreton Bay Regional Council and others.
 Certification for Stage 8 by *[Signature]* on 10.03.16
 For: BMD CONSULTING Pty. Ltd. RPEQ 1907

FUTURE STAGE 10

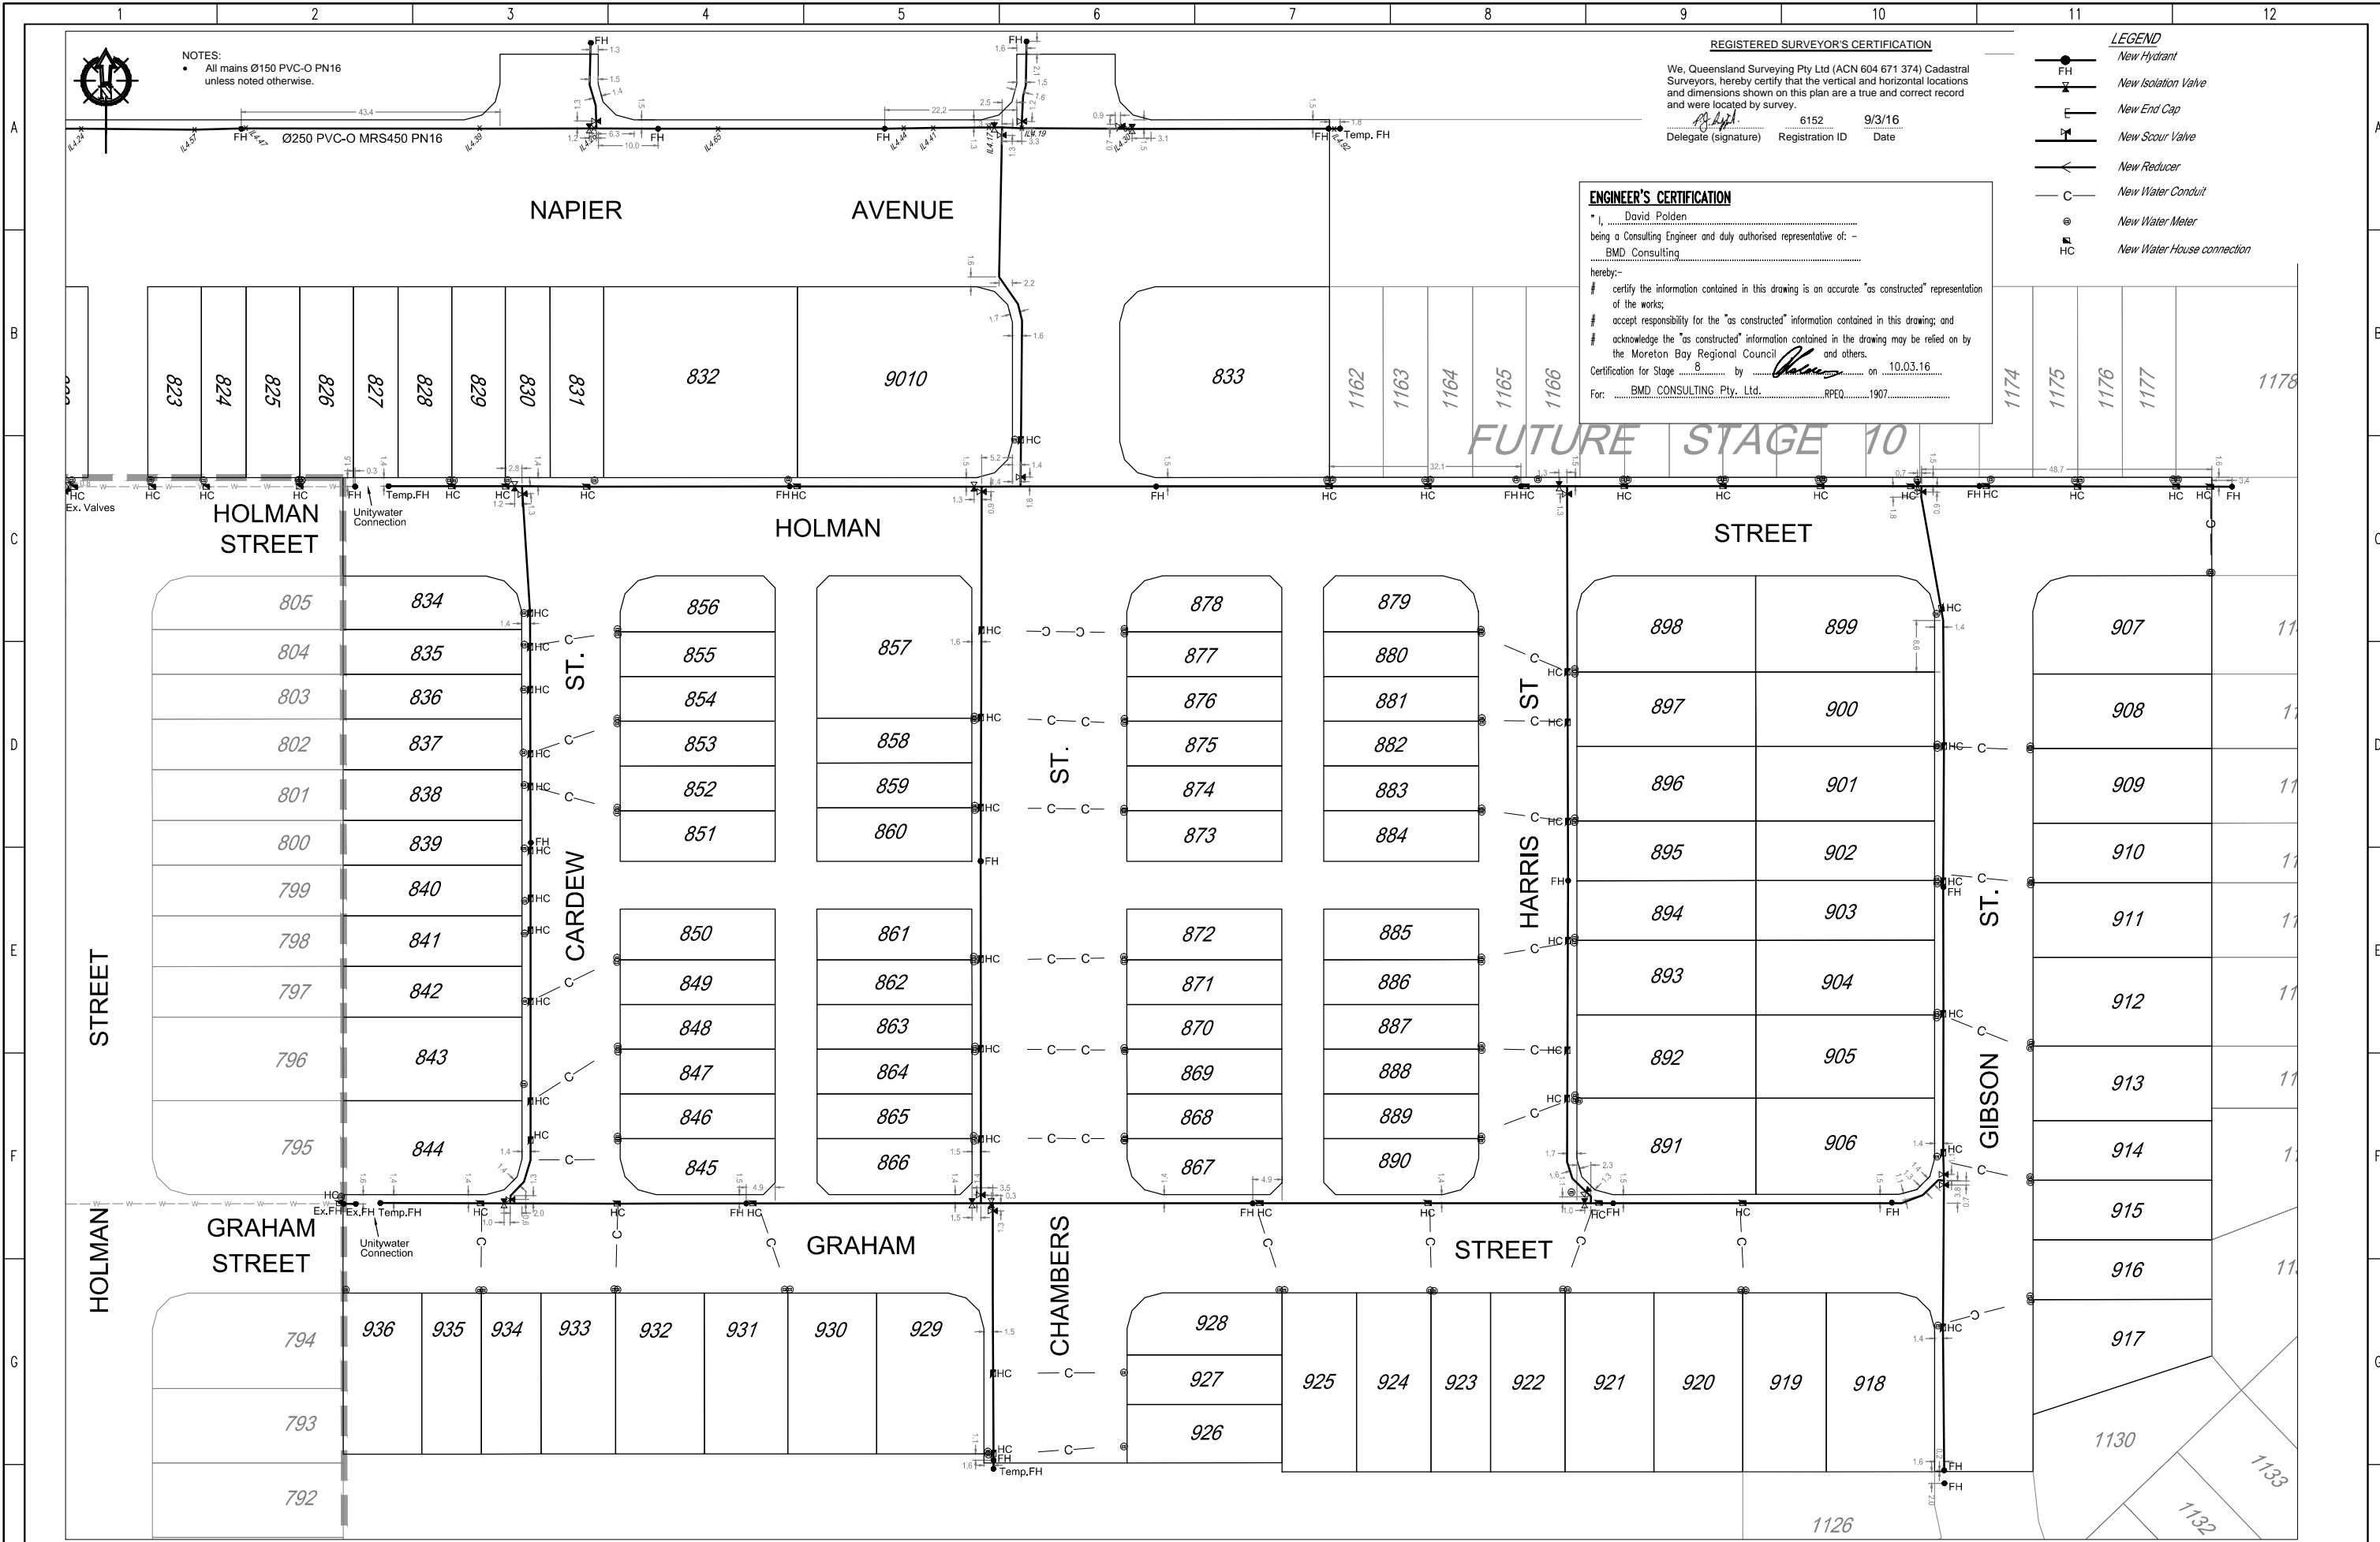

DRAWING REVISIONS		REFERENCE DRAWINGS		DESIGN FILE No.	DESIGNED
REV.	REVISION DESCRIPTION	DRG. No.	DESCRIPTION	CONSTRUCT. No.	DATE
A	Original			SURVEY FILE No. 80105-080100 AW	DRAWN EJM 9/3/16
B	Update			FIELD BOOK	CHECKED EJM 9/3/16
C	Add water meters and conduits			LOG BOOK	DATE
				LEVEL DATUM	AHD
				DATUM	PM177891

**THIS WORK WAS PREPARED BY:
 QUEENSLAND SURVEYING PTY LTD**



MORETON BAY REGIONAL COUNCIL
 CABOOLTURE DISTRICT OFFICE
 2 HASKING STREET CABOOLTURE QLD 4510
 PO BOX 159 CABOOLTURE QLD 4510
 Telephone: (07) 5433 0100
 Fax: (07) 5433 4000

**STAGE 8B, CAPESTONE
 AS CONSTRUCTED
 WATER RETICULATION**

MBRC SUBDIVISION REFERENCE	
DA/29937/2015/V23R	
No. 2 OF 2 PLANS	
ASCAN GRID NUMBER	REV.
	C

SCALE 1:500 ORIGINAL SIZE A1