

ENGINEER'S CERTIFICATION

"I,
being a Consulting Engineer and duly authorised representative of: -
URBEX Pty. Ltd.
hereby:-

certify the information contained in this drawing is an accurate "as constructed" representation of the works;

accept responsibility for the "as constructed" information contained in this drawing; and
acknowledge the "as constructed" information contained in the drawing may be relied on by the Pine Rivers Shire Council and others.

Certification for Stage 1 & 3 by on
For: BMD CONSULTING ENGINEERS Pty. Ltd.


SURVEYOR'S CERTIFICATION

"I, Brian Collins
being a Registered Surveying Associate and duly authorised representative of: -
BMD CONSTRUCTIONS PTY. LTD.
hereby:-


certify the information contained in this drawing is an accurate "as constructed" representation of the works;

accept responsibility for the "as constructed" information contained in this drawing; and
acknowledge the "as constructed" information contained in the drawing may be relied on by the Pine Rivers Shire Council and others.

Certification for Stage 1 & 3 by on May, 2012.
For: Brian Collins Eng.Surv.

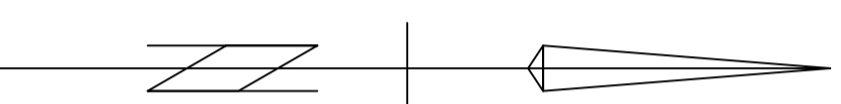

45302

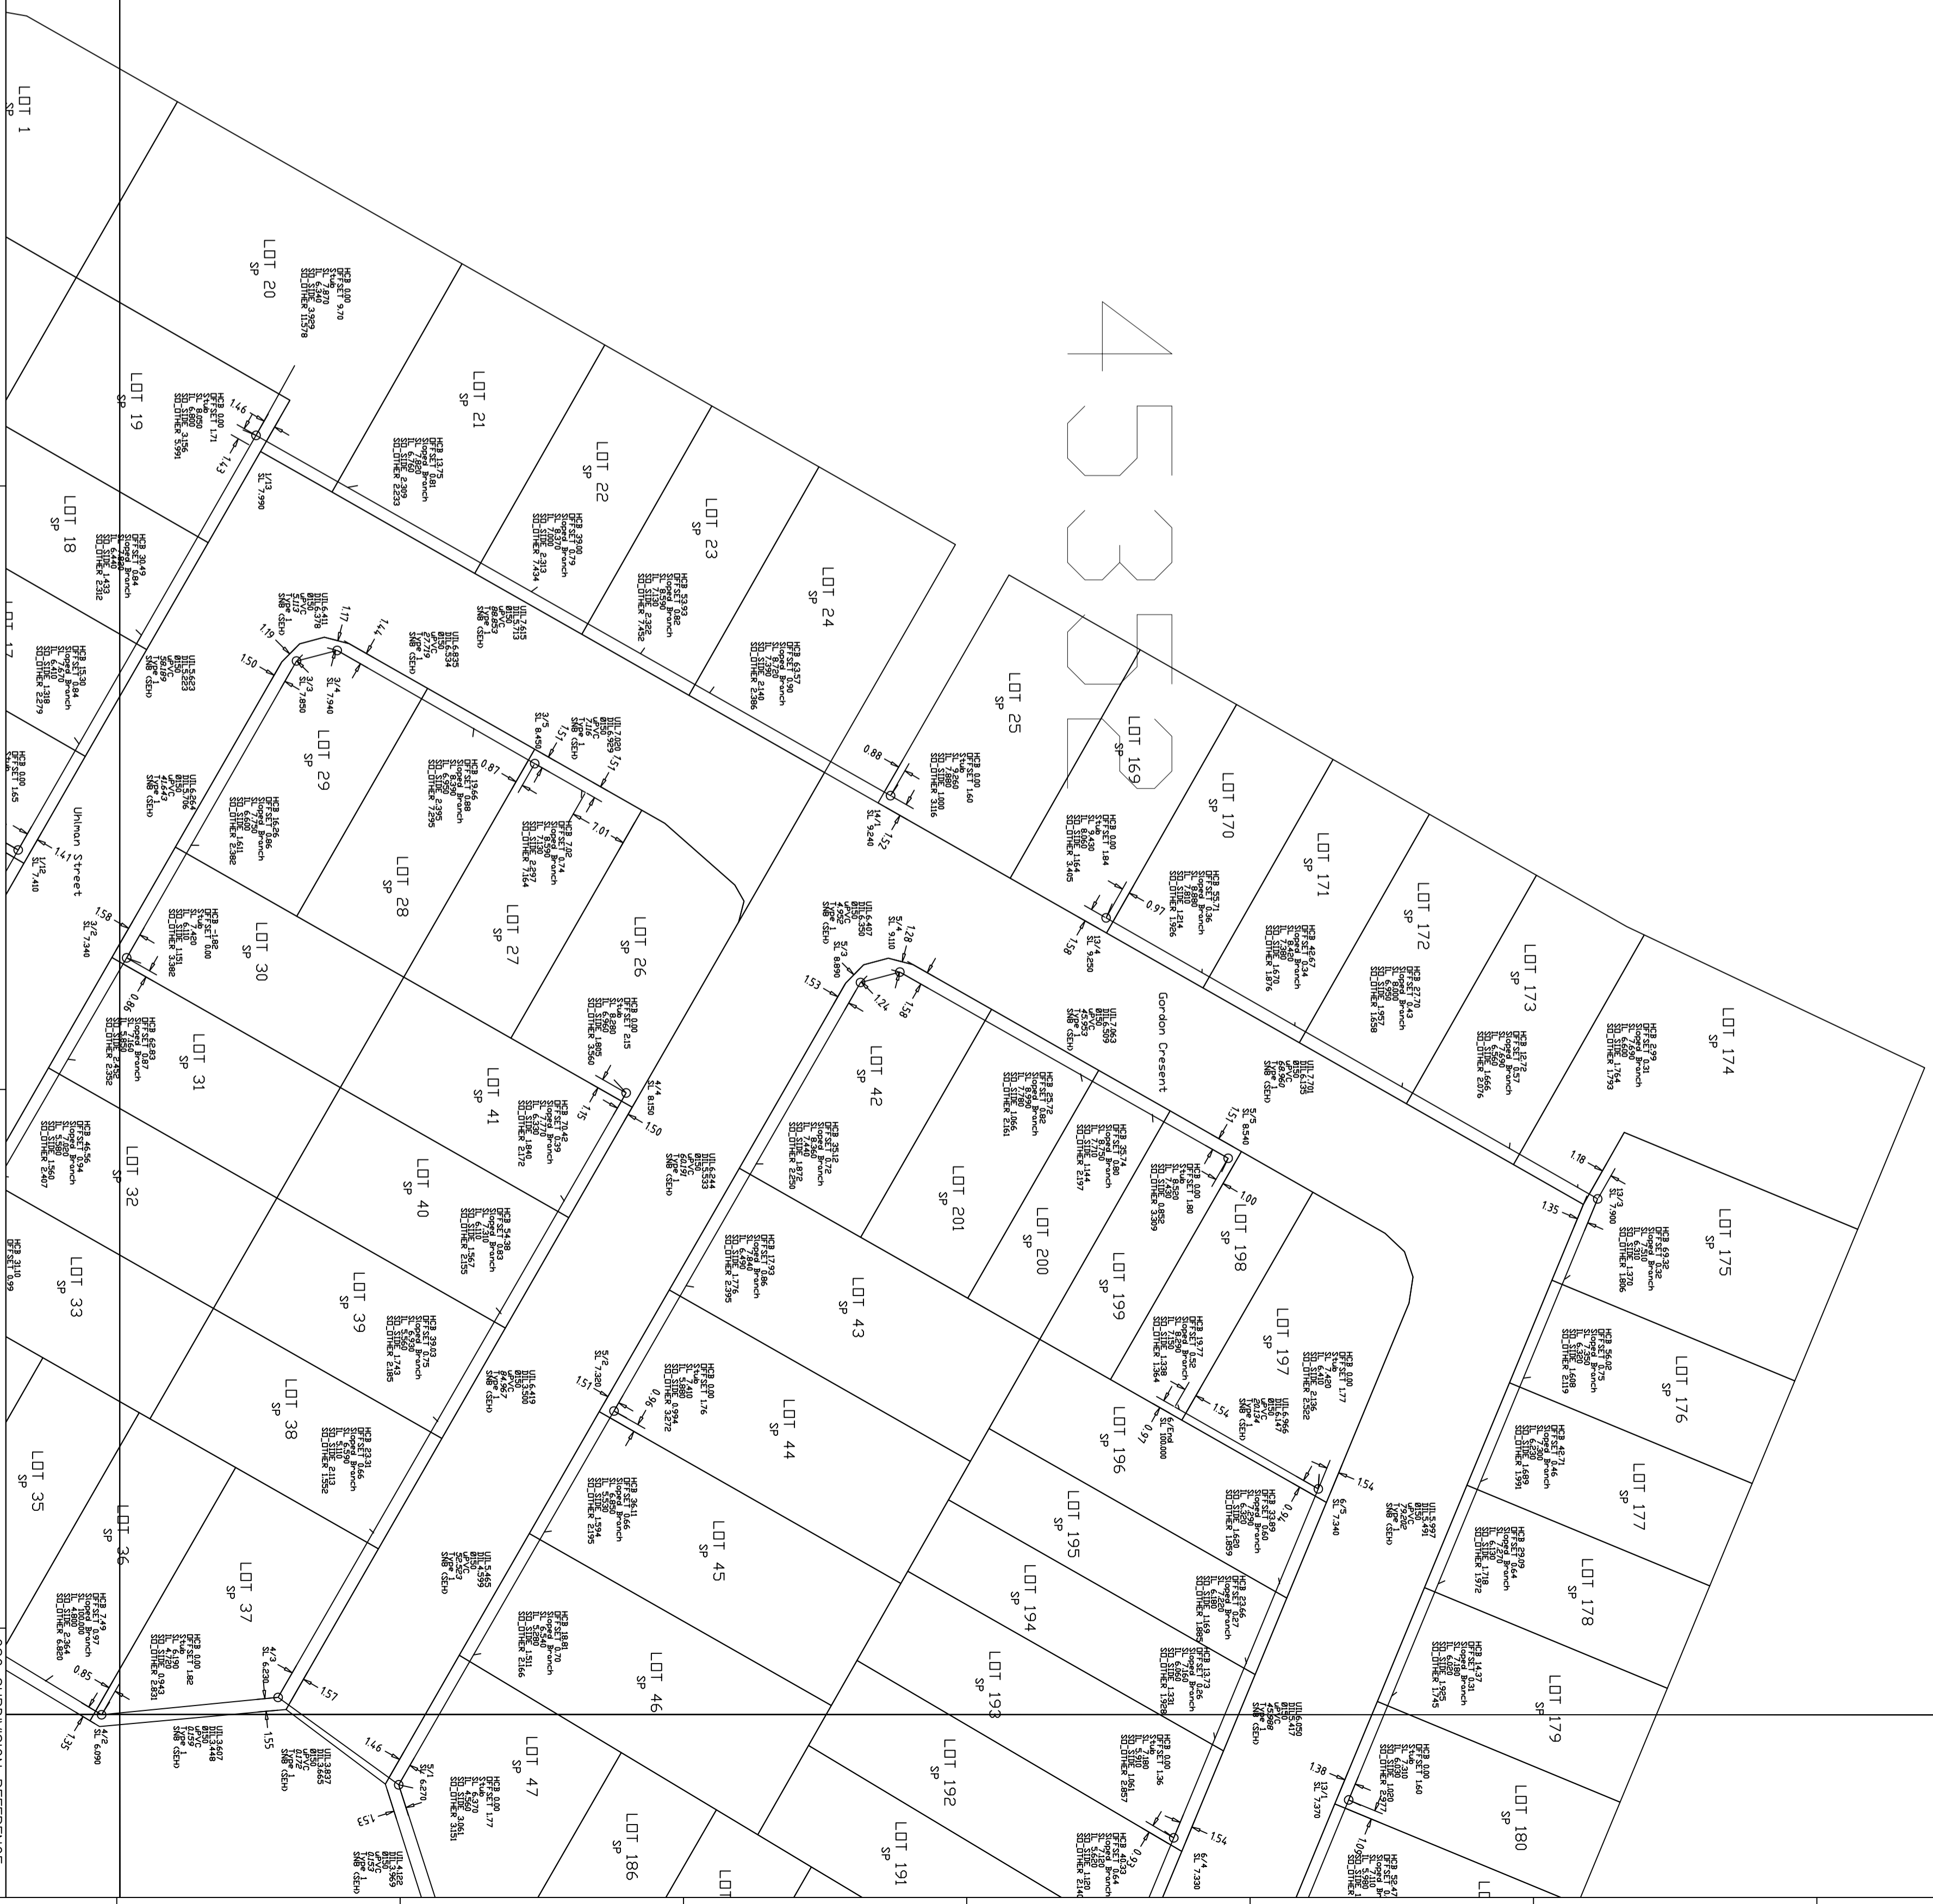

REV.	DESCRIPTION	DRG. No.	CONSTRUCT. No.	DATE
A	PRELIMINARY AS CONSTRUCTED			

DESIGNED	CHECKED	DATE

THIS WORK WAS PREPARED BY:
SUNSTATE ENGINEERING SURVEYS
UNIT 2/44 Storie St. Constat. Qld. 4019
Telephone: (07) 3289 7811
Fax: (07) 3289 7883
SCALE 1:500

AS CONSTRUCTED SEWER
CAPESTONE STAGES 1 & 3

Moreton Bay Regional Council
CABOTTHERIE DISTRICT OFFICE
2 HASKING STREET CABOTTHERIE QLD 4510
Telephone: (07) 5433 0100
Fax: (07) 5433 4000

CSC SUBDIVISION REFERENCE
DA 2055/10548
No. 1 OF 5 PLANS
ASCION GRID NUMBER
45352
REV.
A