


I, ..... Lance ..... Hayes ..... being a cadastral surveyor and duly authorised representative of THG HSG Pty Ltd hereby:

- certify the information contained in this drawing is an accurate as constructed representation of the works
- accept responsibility for the as constructed information contained in this drawing
- acknowledge the as constructed information contained in the drawing may be relied on by council and others

Certification of Stages 2A by ..... on 16/5/13  
 (Signature) (Date)  
 for THG HSG Pty Ltd

**LEGEND**

- Sewer Manhole
- Sewer Main
- - - Sewer House Connection

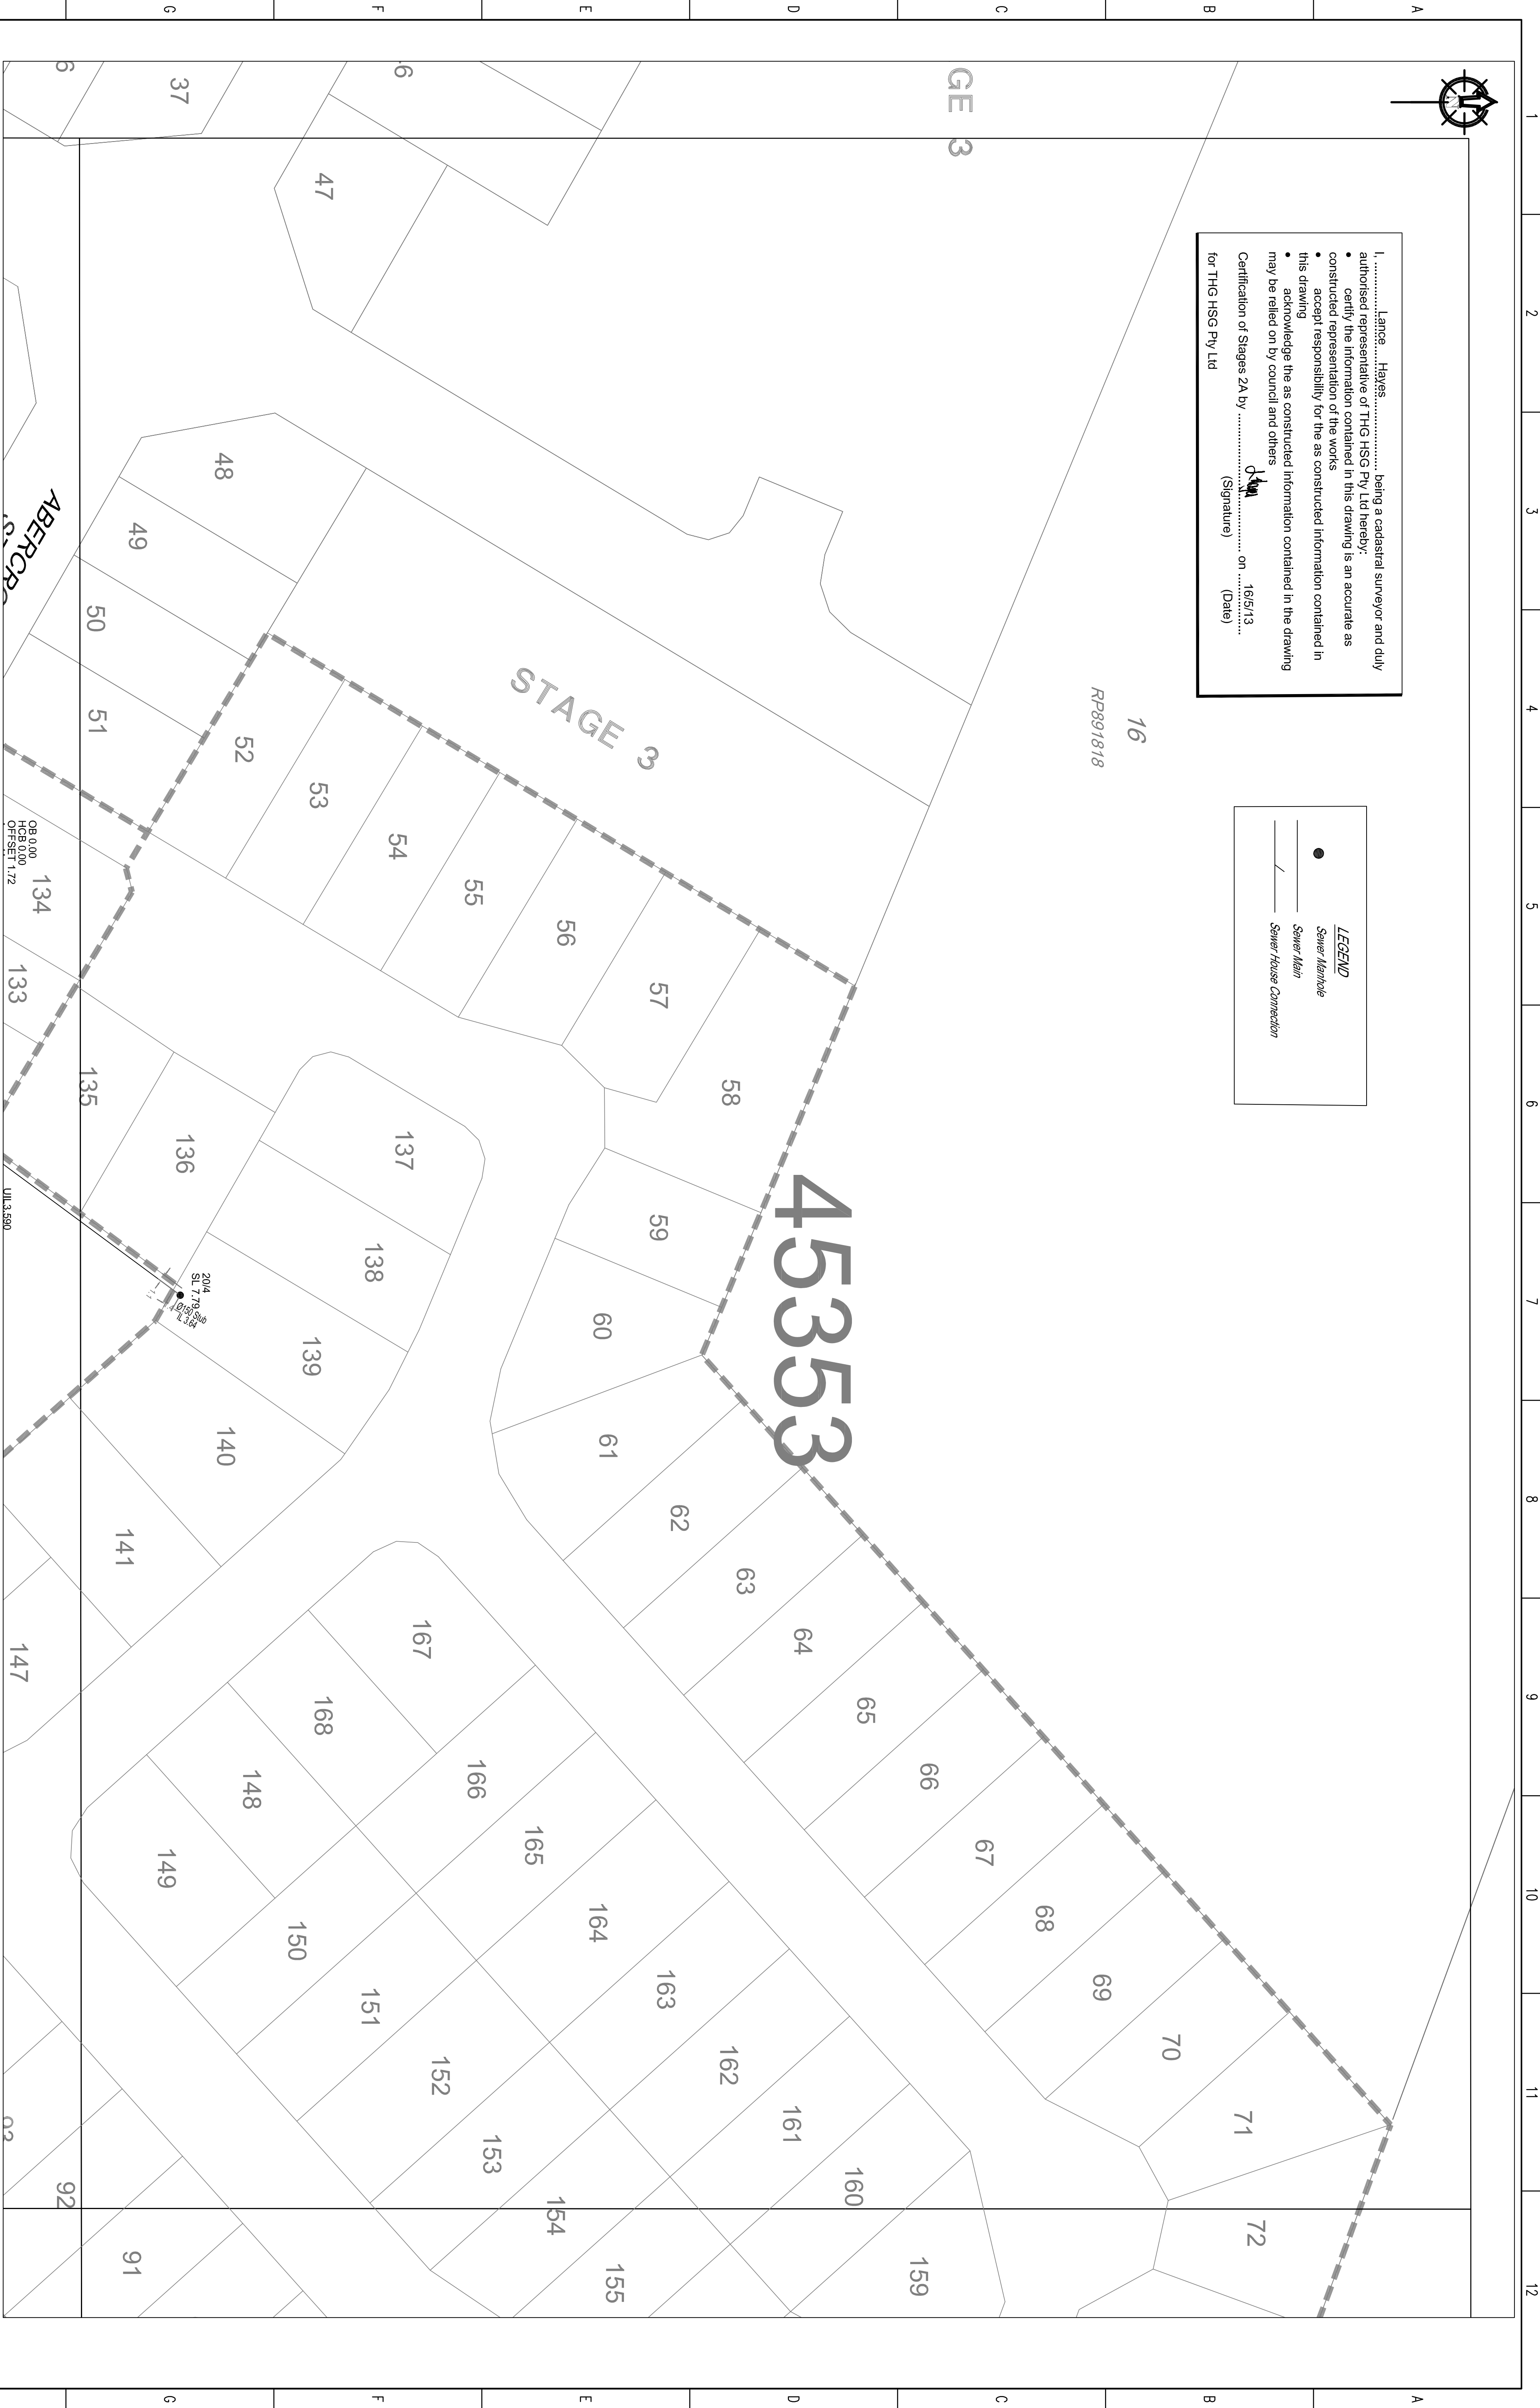

DRAWING REVISIONS		REFERENCE DRAWINGS		DESIGN FILE No.		DESIGNED	
REV.	REVISION DESCRIPTION	DRG. No.	DESCRIPTION	SURVEY FILE No.	CONSTRUCT. No.	DATE	DATE
A	Original			216602_7		16/5/13	EJM
				FIELD BOOK		16/5/13	EJM
				LOG BOOK			
				LEVEL DATUM			
				DATUM			

<b>THIS WORK WAS PREPARED BY:</b> <b>THG HSG PTY LTD</b> SCALE 1:500 ORIGINAL SIZE A1		<b>MORETON BAY REGIONAL COUNCIL</b> CABOOTSURE DISTRICT OFFICE 2 HASKING STREET CABOOTSURE QLD 4510 Telephone: (07) 5433 0100 Fax: (07) 5433 4000	
<b>STAGE 2A(1) CAPESTONE AS CONSTRUCTED SEWER RETICULATION</b>		<b>MARC SUBMISSION REFERENCE</b> 2007/11561/NECDEC/1 No. 1 OF 2 PLANS ASCON GRID NUMBER <b>45353</b>	