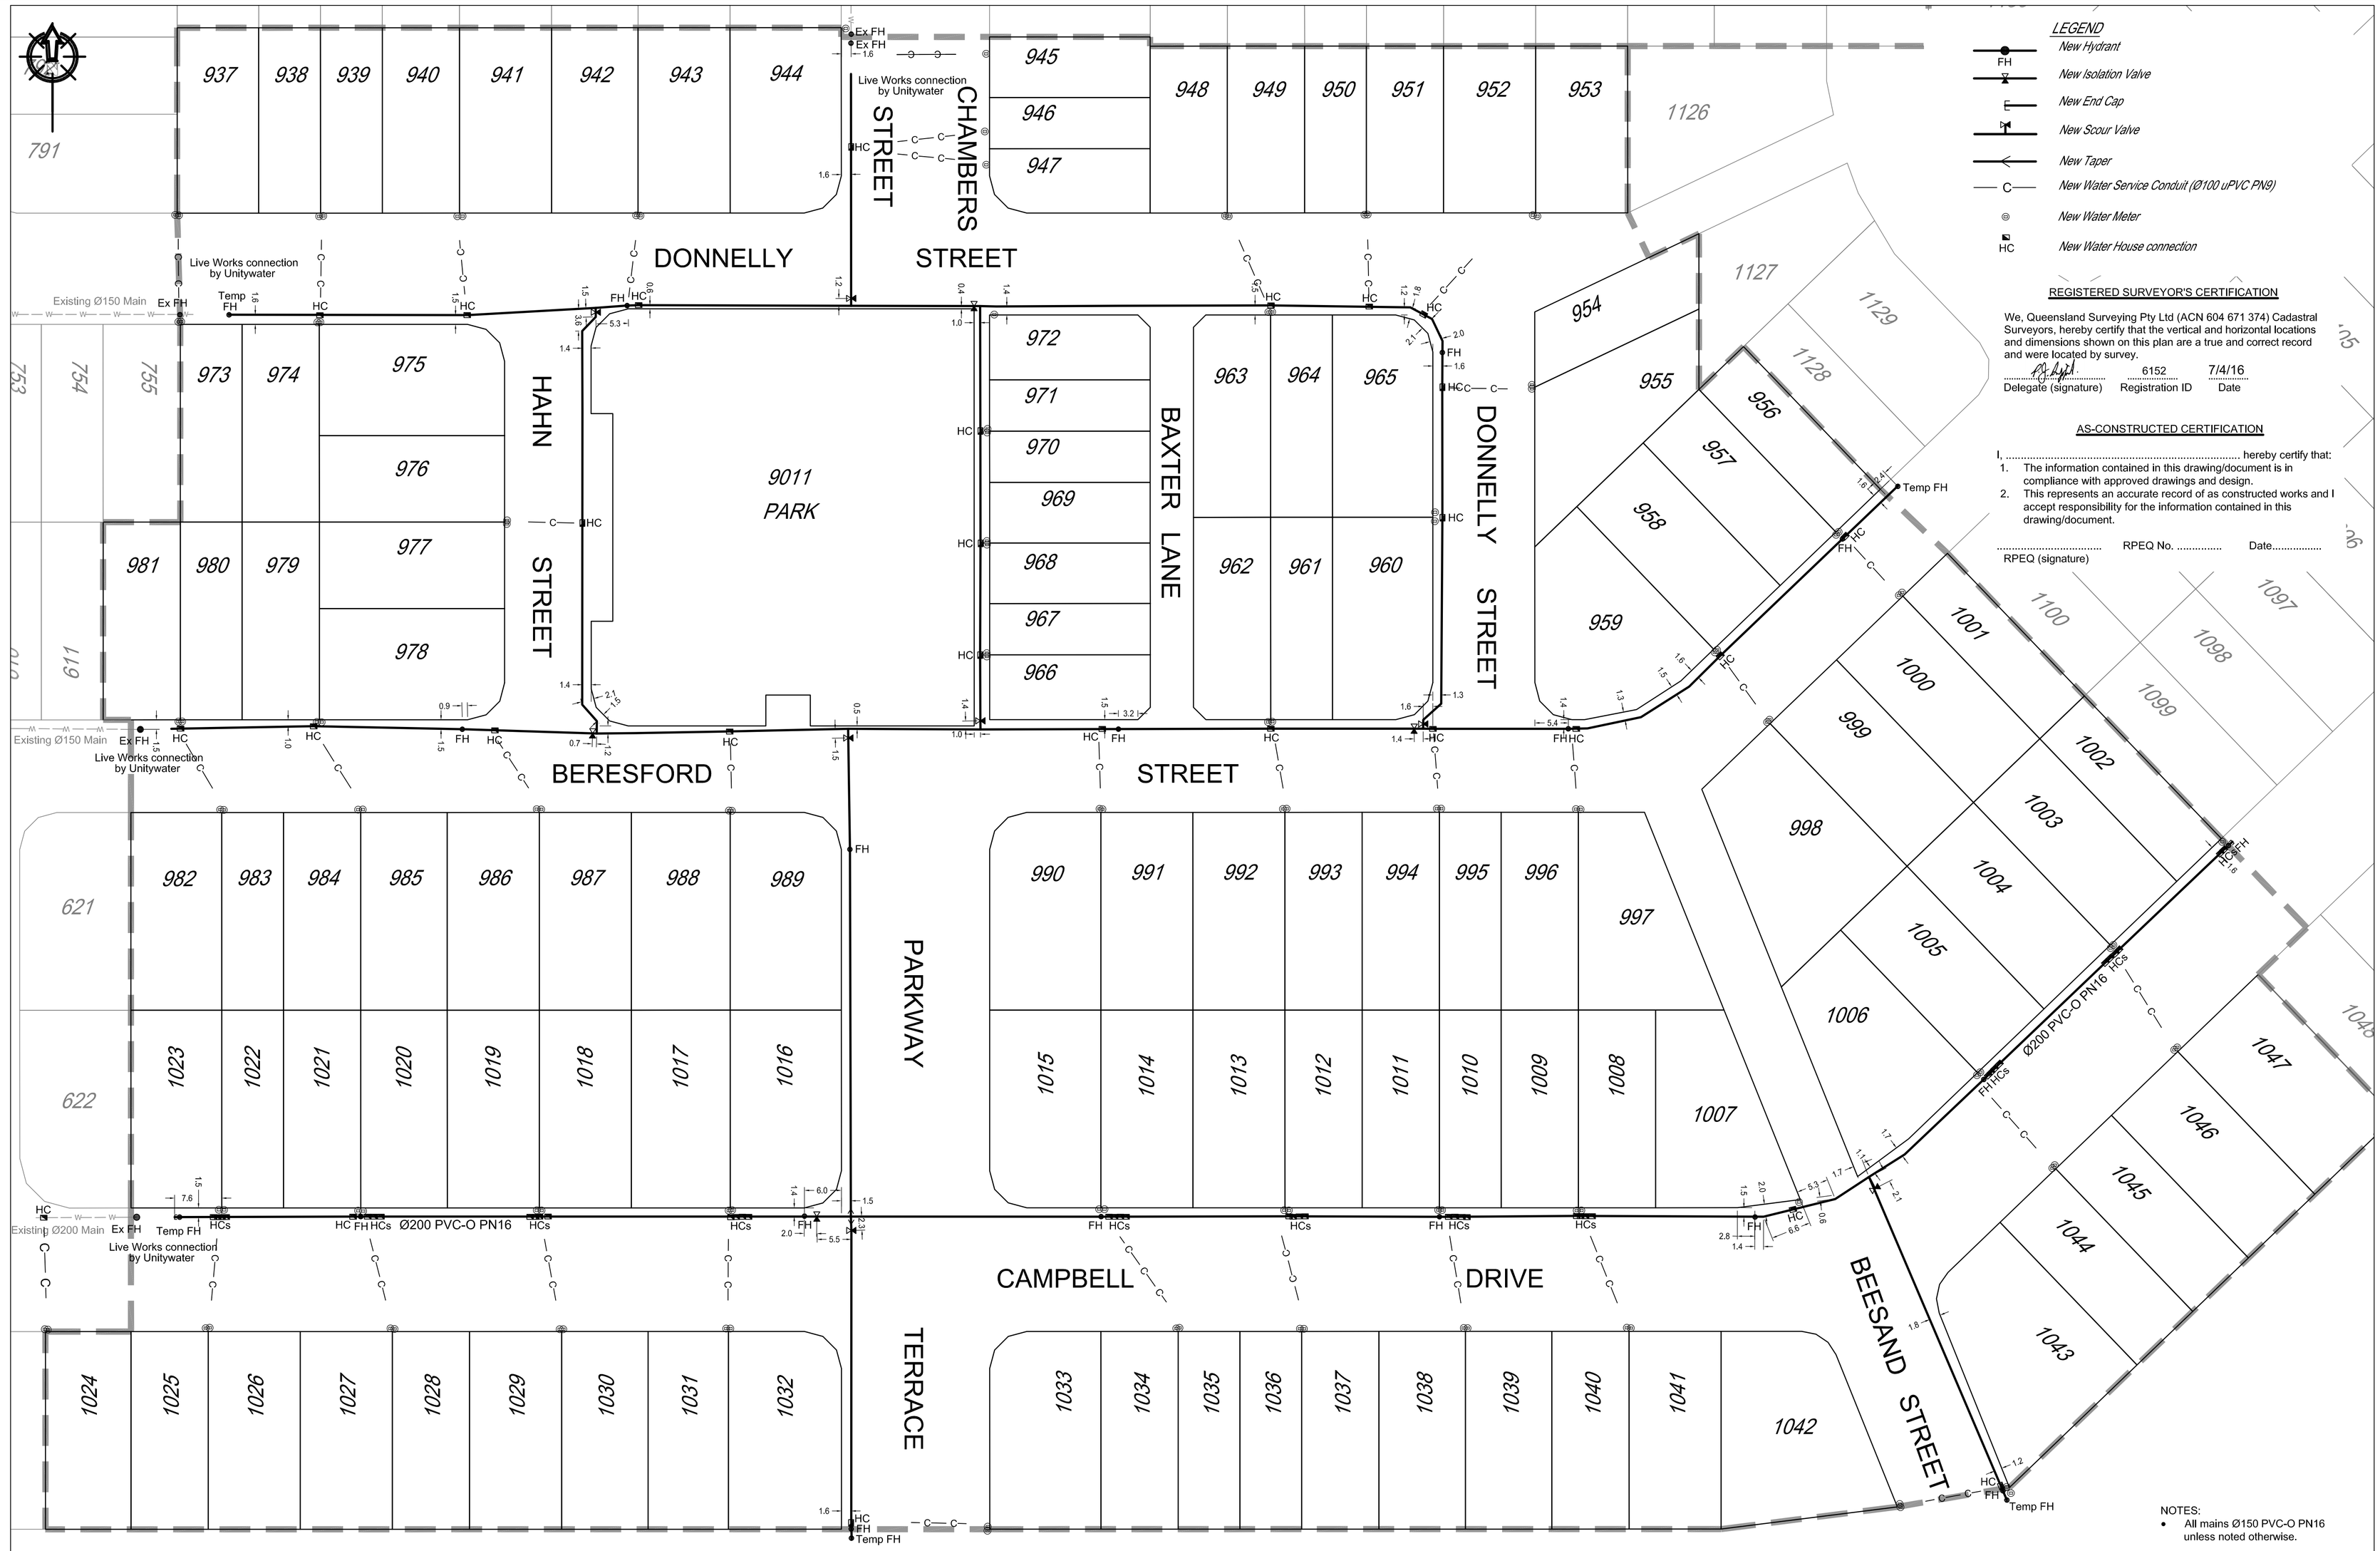

REGISTERED SURVEYOR'S CERTIFICATION

We, Queensland Surveying Pty Ltd (ACN 604 671 374) Cadastral Surveyors, hereby certify that the vertical and horizontal locations and dimensions shown on this plan are a true and correct record and were located by survey.

Delegate (signature) | 6152 Registration ID | 7/4/16 Date

AS-CONSTRUCTED CERTIFICATION

I, ... hereby certify that:

1. The information contained in this drawing/document is in compliance with approved drawings and design.
2. This represents an accurate record of as constructed works and I accept responsibility for the information contained in this drawing/document.

RPEQ (signature) ..... RPEQ No. ..... Date.....

NOTES:

- All mains Ø150 PVC-O PN16 unless noted otherwise.

DRAWING REVISIONS		REFERENCE DRAWINGS	
REV.	REVISION DESCRIPTION	DRG. No.	DESCRIPTION
A	Preliminary		
B	Update		
C	Update		
D	Update		

DESIGN FILE No.		DESIGNED	
CONSTRUCT. No.		DATE	
SURVEY FILE No.	30105-090100 AW	DRAWN	EJM
FIELD BOOK		DATE	7/4/16
LOG BOOK		CHECKED	EJM
LEVEL DATUM	AHD	DATE	7/4/16
DATUM	PM177891		

THIS WORK WAS PREPARED BY: QUEENSLAND SURVEYING PTY LTD

SCALE 1:500 | ORIGINAL SIZE A1

Moreton Bay Regional Council

MORETON BAY REGIONAL COUNCIL
CABOOLTURE DISTRICT OFFICE
2 HASKING STREET CABOOLTURE QLD 4510
PO BOX 159 CABOOLTURE QLD 4510
Telephone: (07) 5433 0100
Fax: (07) 5433 4000

STAGE 9, CAPESTONE AS CONSTRUCTED WATER RETICULATION

MBRC SUBDIVISION REFERENCE	
DA/30097/2015/V23R	
No. 1 OF 1 PLANS	
ASCON GRID NUMBER	REV.
	D