


**EARTHWORKS SUMMARY REPORT
CAPESTONE ESTATE – STAGE 2A(2)
LOT 89**

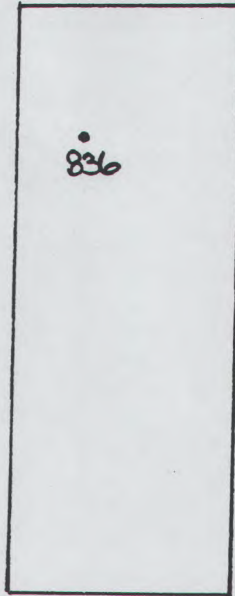


ABERCROMBIE ST

Field Density Results

| Test No. | Date Tested | Test Location | Dry Density Ratio AS1289 5.4.1 (Standard) |
|----------|-------------|---|---|
| 836 | 22.9.13 | o/s 5m Rear bdy, o/s 4m Left bdy. R.L.7.43. | 100.5 |

In our opinion fill on Lot 89 has been placed in a controlled manner to achieve a minimum dry density ratio of 95% to (AS1289.5.1.1 Standard Compaction). We confirm that filling to design final level can be termed controlled filling in accordance with Section 6.4.2. of AS2870-2011, via a "Level 1" inspection and testing commission.

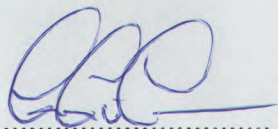


GREG McGRANN



Brisbane Soil Testing
76 Groth Road
Boondall, Q. 4034
Ph. (07) 3265 2033

NATA Reg. No. 2415

**EARTHWORKS SUMMARY REPORT
CAPESTONE ESTATE – STAGE 2A(2)
LOT 90**

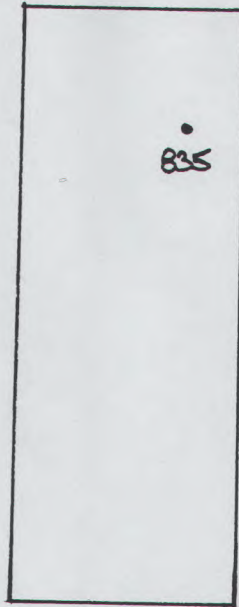


ABERCROMBIE ST

Field Density Results

Page 1 of 1

| Test No. | Date Tested | Test Location | Dry Density Ratio AS1289 5.4.1 (Standard) |
|----------|-------------|--|---|
| 835 | 22.9.13 | o/s 4m Rear bdy, o/s 3m Right bdy. R.L.7.41. | 98.0 |

In our opinion fill on Lot 90 has been placed in a controlled manner to achieve a minimum dry density ratio of 95% to (AS1289.5.1.1 Standard Compaction). We confirm that filling to design final level can be termed controlled filling in accordance with Section 6.4.2. of AS2870-2011, via a "Level 1" inspection and testing commission.

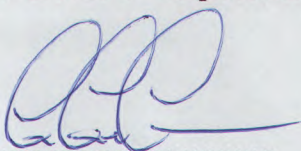


GREG McGRANN



Brisbane Soil Testing
76 Groth Road
Boondall, Q. 4034
Ph. (07) 3265 2033

NATA Reg. No. 2415

EARTHWORKS SUMMARY REPORT
CAPESTONE ESTATE – STAGE 2A(2)
LOT 91

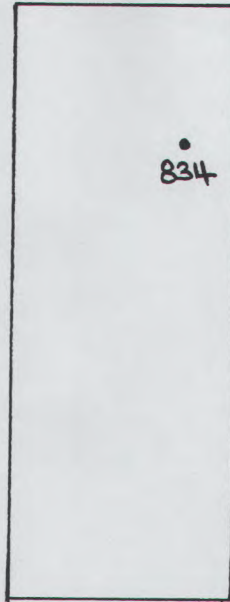


ABERCROMBIE ST

Field Density Results

Page 1 of 1

| Test No. | Date Tested | Test Location | Dry Density Ratio AS1289 5.4.1 (Standard) |
|----------|-------------|--|---|
| 834 | 22.9.13 | o/s 6m Rear bdy, o/s 3m Right bdy. R.L.7.30. | 98.0 |

In our opinion fill on Lot 91 has been placed in a controlled manner to achieve a minimum dry density ratio of 95% to (AS1289.5.1.1 Standard Compaction). We confirm that filling to design final level can be termed controlled filling in accordance with Section 6.4.2. of AS2870-2011, via a "Level 1" inspection and testing commission.

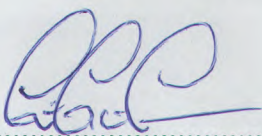

.....
GREG McGRANN



Brisbane Soil Testing
76 Groth Road
Boondall, Q. 4034
Ph. (07) 3265 2033

NATA Reg. No. 2415

**EARTHWORKS SUMMARY REPORT
CAPESTONE ESTATE – STAGE 2A(2)
LOT 92**

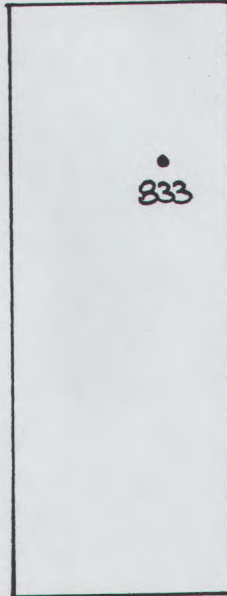

ABERCROMBIE ST

Field Density Results

Page 1 of 1

| Test No. | Date Tested | Test Location | Dry Density Ratio AS1289 5.4.1 (Standard) |
|----------|-------------|--|---|
| 833 | 22.9.13 | o/s 6m Rear bdy, o/s 4m Right bdy. R.L.7.27. | 101.5 |

In our opinion fill on Lot 92 has been placed in a controlled manner to achieve a minimum dry density ratio of 95% to (AS1289.5.1.1 Standard Compaction). We confirm that filling to design final level can be termed controlled filling in accordance with Section 6.4.2. of AS2870-2011, via a "Level 1" inspection and testing commission.


.....
GREG McGRANN



Brisbane Soil Testing
76 Groth Road
Boondall, Q. 4034
Ph. (07) 3265 2033

NATA Reg. No. 2415

**EARTHWORKS SUMMARY REPORT
CAPESTONE ESTATE – STAGE 2A(2)
LOT 93**

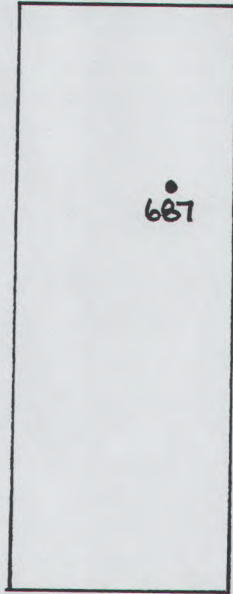


ABERCROMBIE ST

Field Density Results

| Test No. | Date Tested | Test Location | Dry Density Ratio AS1289 5.4.1 (Standard) |
|----------|-------------|---|---|
| 687 | 6.8.13 | o/s 7m Rear bdy, o/s 4m Left bdy. R.L.6.80. | 97.0 |

In our opinion fill on Lot 93 has been placed in a controlled manner to achieve a minimum dry density ratio of 95% to (AS1289.5.1.1 Standard Compaction). We confirm that filling to design final level can be termed controlled filling in accordance with Section 6.4.2. of AS2870-2011, via a "Level 1" inspection and testing commission.

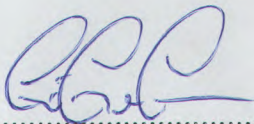

GREG McGRANN



Brisbane Soil Testing
76 Groth Road
Boondall, Q. 4034
Ph. (07) 3265 2033

NATA Reg. No. 2415