


**EARTHWORKS SUMMARY REPORT  
CAPESTONE ESTATE – STAGE 2A(2)  
LOT 89**

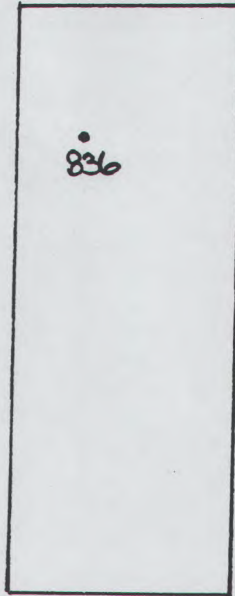

-----  
ABERCROMBIE ST

**Field Density Results**

Test No.	Date Tested	Test Location	Dry Density Ratio AS1289 5.4.1 (Standard)
836	22.9.13	o/s 5m Rear bdy, o/s 4m Left bdy. R.L.7.43.	100.5


In our opinion fill on Lot 89 has been placed in a controlled manner to achieve a minimum dry density ratio of 95% to (AS1289.5.1.1 Standard Compaction). We confirm that filling to design final level can be termed controlled filling in accordance with Section 6.4.2. of AS2870-2011, via a "Level 1" inspection and testing commission.

  
 .....  
**GREG McGRANN**



**Brisbane Soil Testing**  
 76 Groth Road  
 Boondall, Q. 4034  
 Ph. (07) 3265 2033  
  
 NATA Reg. No. 2415

**EARTHWORKS SUMMARY REPORT  
CAPESTONE ESTATE – STAGE 2A(2)  
LOT 90**

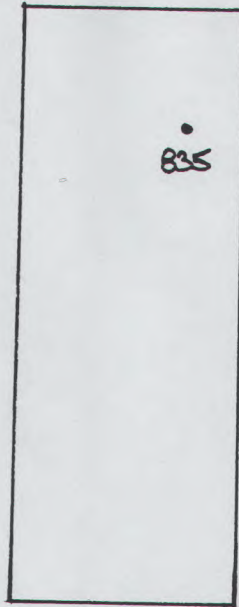

-----  
ABERCROMBIE ST

**Field Density Results**

Page 1 of 1

Test No.	Date Tested	Test Location	Dry Density Ratio AS1289 5.4.1 (Standard)
835	22.9.13	o/s 4m Rear bdy, o/s 3m Right bdy. R.L.7.41.	98.0

In our opinion fill on Lot 90 has been placed in a controlled manner to achieve a minimum dry density ratio of 95% to (AS1289.5.1.1 Standard Compaction). We confirm that filling to design final level can be termed controlled filling in accordance with Section 6.4.2. of AS2870-2011, via a "Level 1" inspection and testing commission.

.....  
**GREG McGRANN**




**Brisbane Soil Testing**  
76 Groth Road  
Boondall, Q. 4034  
Ph. (07) 3265 2033

NATA Reg. No. 2415



EARTHWORKS SUMMARY REPORT  
CAPESTONE ESTATE – STAGE 2A(2)  
LOT 91

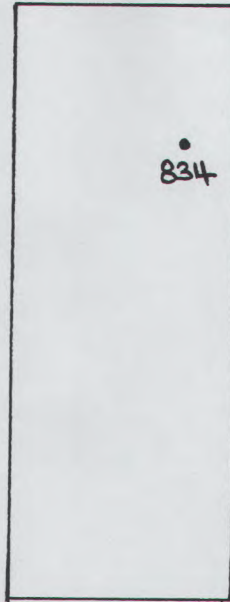


-----  
ABERCROMBIE ST

Field Density Results

Page 1 of 1

Test No.	Date Tested	Test Location	Dry Density Ratio AS1289 5.4.1 (Standard)
834	22.9.13	o/s 6m Rear bdy, o/s 3m Right bdy. R.L.7.30.	98.0

In our opinion fill on Lot 91 has been placed in a controlled manner to achieve a minimum dry density ratio of 95% to (AS1289.5.1.1 Standard Compaction). We confirm that filling to design final level can be termed controlled filling in accordance with Section 6.4.2. of AS2870-2011, via a "Level 1" inspection and testing commission.

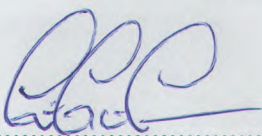
  
.....  
**GREG McGRANN**



**Brisbane Soil Testing**  
76 Groth Road  
Boondall, Q. 4034  
Ph. (07) 3265 2033

NATA Reg. No. 2415

**EARTHWORKS SUMMARY REPORT  
CAPESTONE ESTATE – STAGE 2A(2)  
LOT 92**

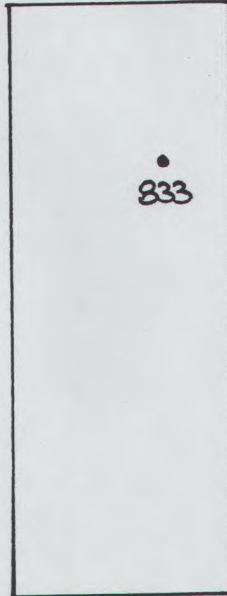

-----  
ABERCROMBIE ST

**Field Density Results**

Page 1 of 1

Test No.	Date Tested	Test Location	Dry Density Ratio AS1289 5.4.1 (Standard)
833	22.9.13	o/s 6m Rear bdy, o/s 4m Right bdy. R.L.7.27.	101.5

In our opinion fill on Lot 92 has been placed in a controlled manner to achieve a minimum dry density ratio of 95% to (AS1289.5.1.1 Standard Compaction). We confirm that filling to design final level can be termed controlled filling in accordance with Section 6.4.2. of AS2870-2011, via a "Level 1" inspection and testing commission.

.....  
**GREG McGRANN**




**Brisbane Soil Testing**  
76 Groth Road  
Boondall, Q. 4034  
Ph. (07) 3265 2033

NATA Reg. No. 2415



**EARTHWORKS SUMMARY REPORT  
CAPESTONE ESTATE – STAGE 2A(2)  
LOT 93**

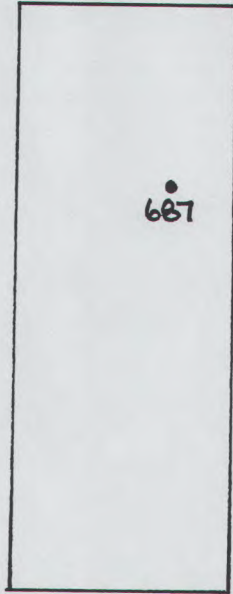


-----  
ABERCROMBIE ST

**Field Density Results**

Test No.	Date Tested	Test Location	Dry Density Ratio AS1289 5.4.1 (Standard)
687	6.8.13	o/s 7m Rear bdy, o/s 4m Left bdy. R.L.6.80.	97.0

In our opinion fill on Lot 93 has been placed in a controlled manner to achieve a minimum dry density ratio of 95% to (AS1289.5.1.1 Standard Compaction). We confirm that filling to design final level can be termed controlled filling in accordance with Section 6.4.2. of AS2870-2011, via a "Level 1" inspection and testing commission.

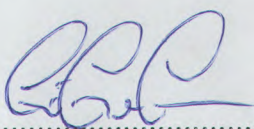  
 .....  
**GREG McGRANN**



**Brisbane Soil Testing**  
76 Groth Road  
Boondall, Q. 4034  
Ph. (07) 3265 2033

NATA Reg. No. 2415