


**EARTHWORKS SUMMARY REPORT
CAPESTONE ESTATE – STAGE 2A(2)
LOT 139**

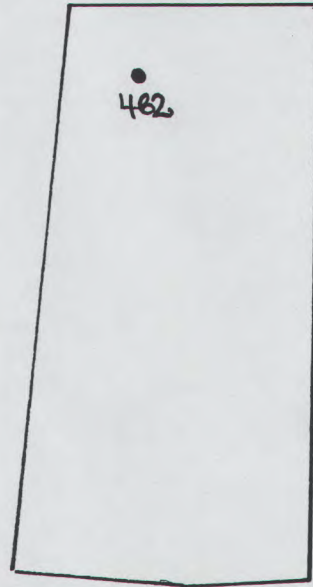

Field Density Results

Test No.	Date Tested	Test Location	Dry Density Ratio AS1289 5.4.1 (Standard)
482	6.2.13	o/s 3m Rear bdy, o/s 5m Left bdy. R.L.7.51.	99.0

In our opinion fill on Lot 139 has been placed in a controlled manner to achieve a minimum dry density ratio of 95% to (AS1289.5.1.1 Standard Compaction). We confirm that filling to design final level can be termed controlled filling in accordance with Section 6.4.2. of AS2870-2011, via a "Level 1" inspection and testing commission.


.....
GREG McGRANN



Brisbane Soil Testing
76 Groth Road
Boondall, Q. 4034
Ph. (07) 3265 2033

NATA Reg. No. 2415

**EARTHWORKS SUMMARY REPORT
CAPESTONE ESTATE – STAGE 2A(2)
LOT 140**

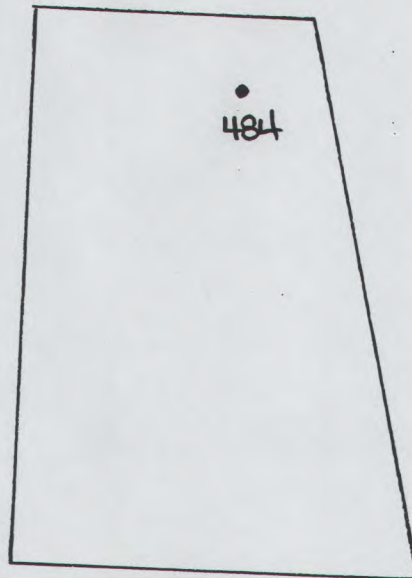

MCKEE CR

Field Density Results

Page 1 of 1

Test No.	Date Tested	Test Location	Dry Density Ratio AS1289 5.4.1 (Standard)
484	6.2.13	o/s 3m Rear bdy, o/s 5m Right bdy. R.L.7.70.	96.5

In our opinion fill on Lot 140 has been placed in a controlled manner to achieve a minimum dry density ratio of 95% to (AS1289.5.1.1 Standard Compaction). We confirm that filling to design final level can be termed controlled filling in accordance with Section 6.4.2. of AS2870-2011, via a "Level 1" inspection and testing commission.


.....
GREG McGRANN



Brisbane Soil Testing
76 Groth Road
Boondall, Q. 4034
Ph. (07) 3265 2033

NATA Reg. No. 2415

**EARTHWORKS SUMMARY REPORT
CAPESTONE ESTATE – STAGE 2A(2)
LOT 141**

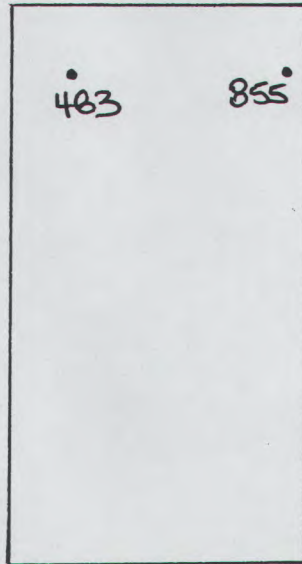


MCKEE CR

Field Density Results

Test No.	Date Tested	Test Location	Dry Density Ratio AS1289 5.4.1 (Standard)
483	6.2.13	o/s 3m Rear bdy, o/s 3m Left bdy. R.L.7.14.	97.0
855	4.10.13	o/s 3m Rear bdy, o/s 1m Right bdy. R.L.7.84.	96.5

In our opinion fill on Lot 141 has been placed in a controlled manner to achieve a minimum dry density ratio of 95% to (AS1289.5.1.1 Standard Compaction). We confirm that filling to design final level can be termed controlled filling in accordance with Section 6.4.2. of AS2870-2011, via a "Level 1" inspection and testing commission.

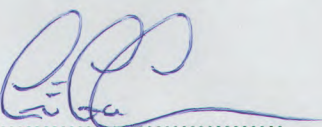


GREG McGRANN



Brisbane Soil Testing
76 Groth Road
Boondall, Q. 4034
Ph. (07) 3265 2033

NATA Reg. No. 2415

**EARTHWORKS SUMMARY REPORT
CAPESTONE ESTATE – STAGE 2A(2)
LOT 146**

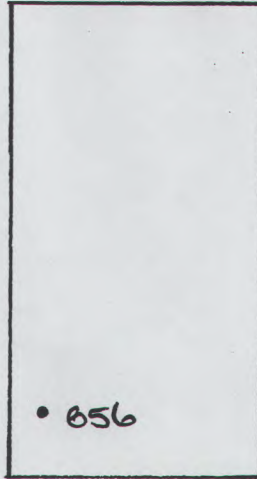

ABERCROMBIE ST

Field Density Results

Test No.	Date Tested	Test Location	Dry Density Ratio AS1289 5.4.1 (Standard)
856	4.10.13	o/s 4m Front bdy, o/s 2m Left bdy. R.L.6.90.	95.5

In our opinion fill on Lot 146 has been placed in a controlled manner to achieve a minimum dry density ratio of 95% to (AS1289.5.1.1 Standard Compaction). We confirm that filling to design final level can be termed controlled filling in accordance with Section 6.4.2. of AS2870-2011, via a "Level 1" inspection and testing commission.


.....
GREG McGRANN



Brisbane Soil Testing
76 Groth Road
Boondall, Q. 4034
Ph. (07) 3265 2033

NATA Reg. No. 2415

**EARTHWORKS SUMMARY REPORT
CAPESTONE ESTATE – STAGE 2A(2)
LOT 147**

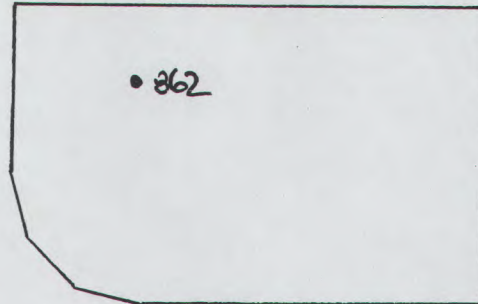

MC KEE CR

Field Density Results

Page 1 of 1

Test No.	Date Tested	Test Location	Dry Density Ratio AS1289 5.4.1 (Standard)
862	8.10.13	o/s 5m Front bdy, o/s 4m Left bdy. R.L.7.02.	98.0

In our opinion fill on Lot 147 has been placed in a controlled manner to achieve a minimum dry density ratio of 95% to (AS1289.5.1.1 Standard Compaction). We confirm that filling to design final level can be termed controlled filling in accordance with Section 6.4.2. of AS2870-2011, via a "Level 1" inspection and testing commission.

GREG McGRANN



Brisbane Soil Testing
76 Groth Road
Boondall, Q. 4034
Ph. (07) 3265 2033

NATA Reg. No. 2415