


**EARTHWORKS SUMMARY REPORT
CAPESTONE ESTATE – STAGE 2A(2)
LOT 139**

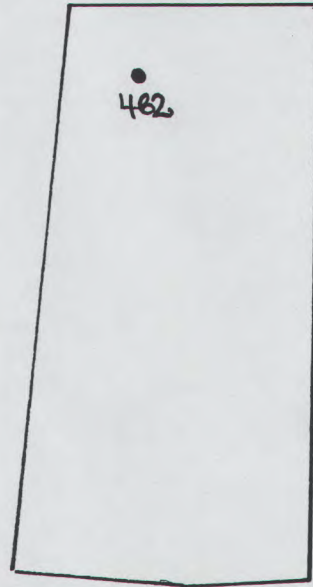

Field Density Results

| Test No. | Date Tested | Test Location | Dry Density Ratio AS1289 5.4.1 (Standard) |
|----------|-------------|---|---|
| 482 | 6.2.13 | o/s 3m Rear bdy, o/s 5m Left bdy. R.L.7.51. | 99.0 |

In our opinion fill on Lot 139 has been placed in a controlled manner to achieve a minimum dry density ratio of 95% to (AS1289.5.1.1 Standard Compaction). We confirm that filling to design final level can be termed controlled filling in accordance with Section 6.4.2. of AS2870-2011, via a "Level 1" inspection and testing commission.


.....
GREG McGRANN



Brisbane Soil Testing
76 Groth Road
Boondall, Q. 4034
Ph. (07) 3265 2033

NATA Reg. No. 2415

**EARTHWORKS SUMMARY REPORT
CAPESTONE ESTATE – STAGE 2A(2)
LOT 140**

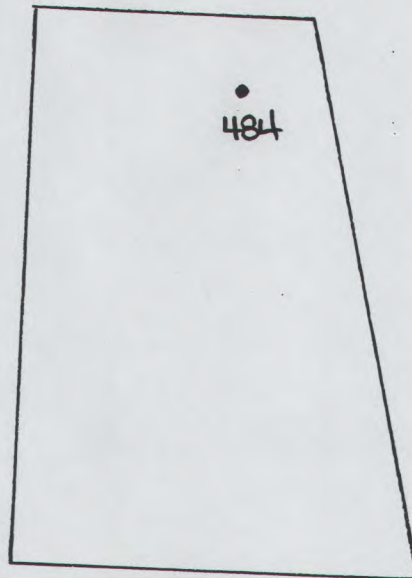

MCKEE CR

Field Density Results

| Test No. | Date Tested | Test Location | Dry Density Ratio AS1289 5.4.1 (Standard) |
|----------|-------------|--|---|
| 484 | 6.2.13 | o/s 3m Rear bdy, o/s 5m Right bdy. R.L.7.70. | 96.5 |

In our opinion fill on Lot 140 has been placed in a controlled manner to achieve a minimum dry density ratio of 95% to (AS1289.5.1.1 Standard Compaction). We confirm that filling to design final level can be termed controlled filling in accordance with Section 6.4.2. of AS2870-2011, via a "Level 1" inspection and testing commission.


.....
GREG McGRANN



Brisbane Soil Testing
76 Groth Road
Boondall, Q. 4034
Ph. (07) 3265 2033

NATA Reg. No. 2415


**EARTHWORKS SUMMARY REPORT
CAPESTONE ESTATE – STAGE 2A(2)
LOT 141**

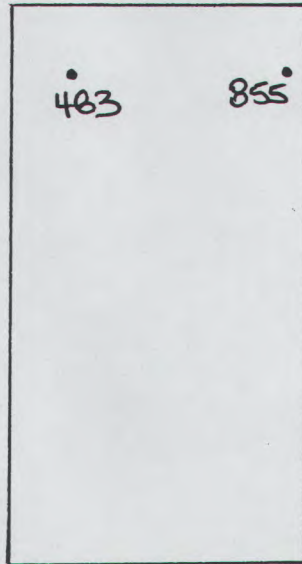

Field Density Results

| Test No. | Date Tested | Test Location | Dry Density Ratio AS1289 5.4.1 (Standard) |
|----------|-------------|--|---|
| 483 | 6.2.13 | o/s 3m Rear bdy, o/s 3m Left bdy. R.L.7.14. | 97.0 |
| 855 | 4.10.13 | o/s 3m Rear bdy, o/s 1m Right bdy. R.L.7.84. | 96.5 |

In our opinion fill on Lot 141 has been placed in a controlled manner to achieve a minimum dry density ratio of 95% to (AS1289.5.1.1 Standard Compaction). We confirm that filling to design final level can be termed controlled filling in accordance with Section 6.4.2. of AS2870-2011, via a "Level 1" inspection and testing commission.

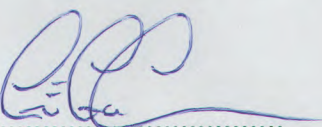


GREG McGRANN



Brisbane Soil Testing
 76 Groth Road
 Boondall, Q. 4034
 Ph. (07) 3265 2033

NATA Reg. No. 2415

**EARTHWORKS SUMMARY REPORT
CAPESTONE ESTATE – STAGE 2A(2)
LOT 146**

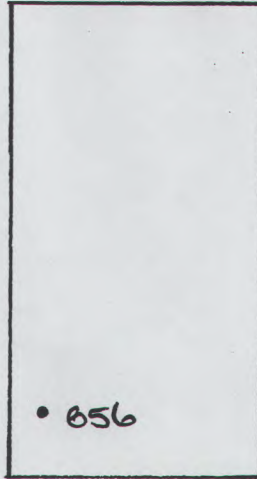

ABERCROMBIE ST

Field Density Results

| Test No. | Date Tested | Test Location | Dry Density Ratio AS1289 5.4.1 (Standard) |
|----------|-------------|--|---|
| 856 | 4.10.13 | o/s 4m Front bdy, o/s 2m Left bdy. R.L.6.90. | 95.5 |

In our opinion fill on Lot 146 has been placed in a controlled manner to achieve a minimum dry density ratio of 95% to (AS1289.5.1.1 Standard Compaction). We confirm that filling to design final level can be termed controlled filling in accordance with Section 6.4.2. of AS2870-2011, via a "Level 1" inspection and testing commission.


.....
GREG McGRANN



Brisbane Soil Testing
76 Groth Road
Boondall, Q. 4034
Ph. (07) 3265 2033

NATA Reg. No. 2415

**EARTHWORKS SUMMARY REPORT
CAPESTONE ESTATE – STAGE 2A(2)
LOT 147**

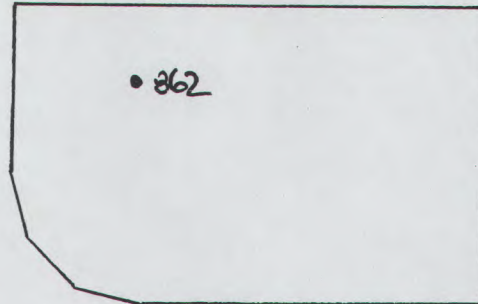


MC KEE CR

Field Density Results

| Test No. | Date Tested | Test Location | Dry Density Ratio AS1289 5.4.1 (Standard) |
|----------|-------------|--|---|
| 862 | 8.10.13 | o/s 5m Front bdy, o/s 4m Left bdy. R.L.7.02. | 98.0 |

In our opinion fill on Lot 147 has been placed in a controlled manner to achieve a minimum dry density ratio of 95% to (AS1289.5.1.1 Standard Compaction). We confirm that filling to design final level can be termed controlled filling in accordance with Section 6.4.2. of AS2870-2011, via a "Level 1" inspection and testing commission.

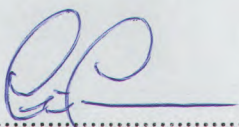

GREG McGRANN



Brisbane Soil Testing
76 Groth Road
Boondall, Q. 4034
Ph. (07) 3265 2033

NATA Reg. No. 2415