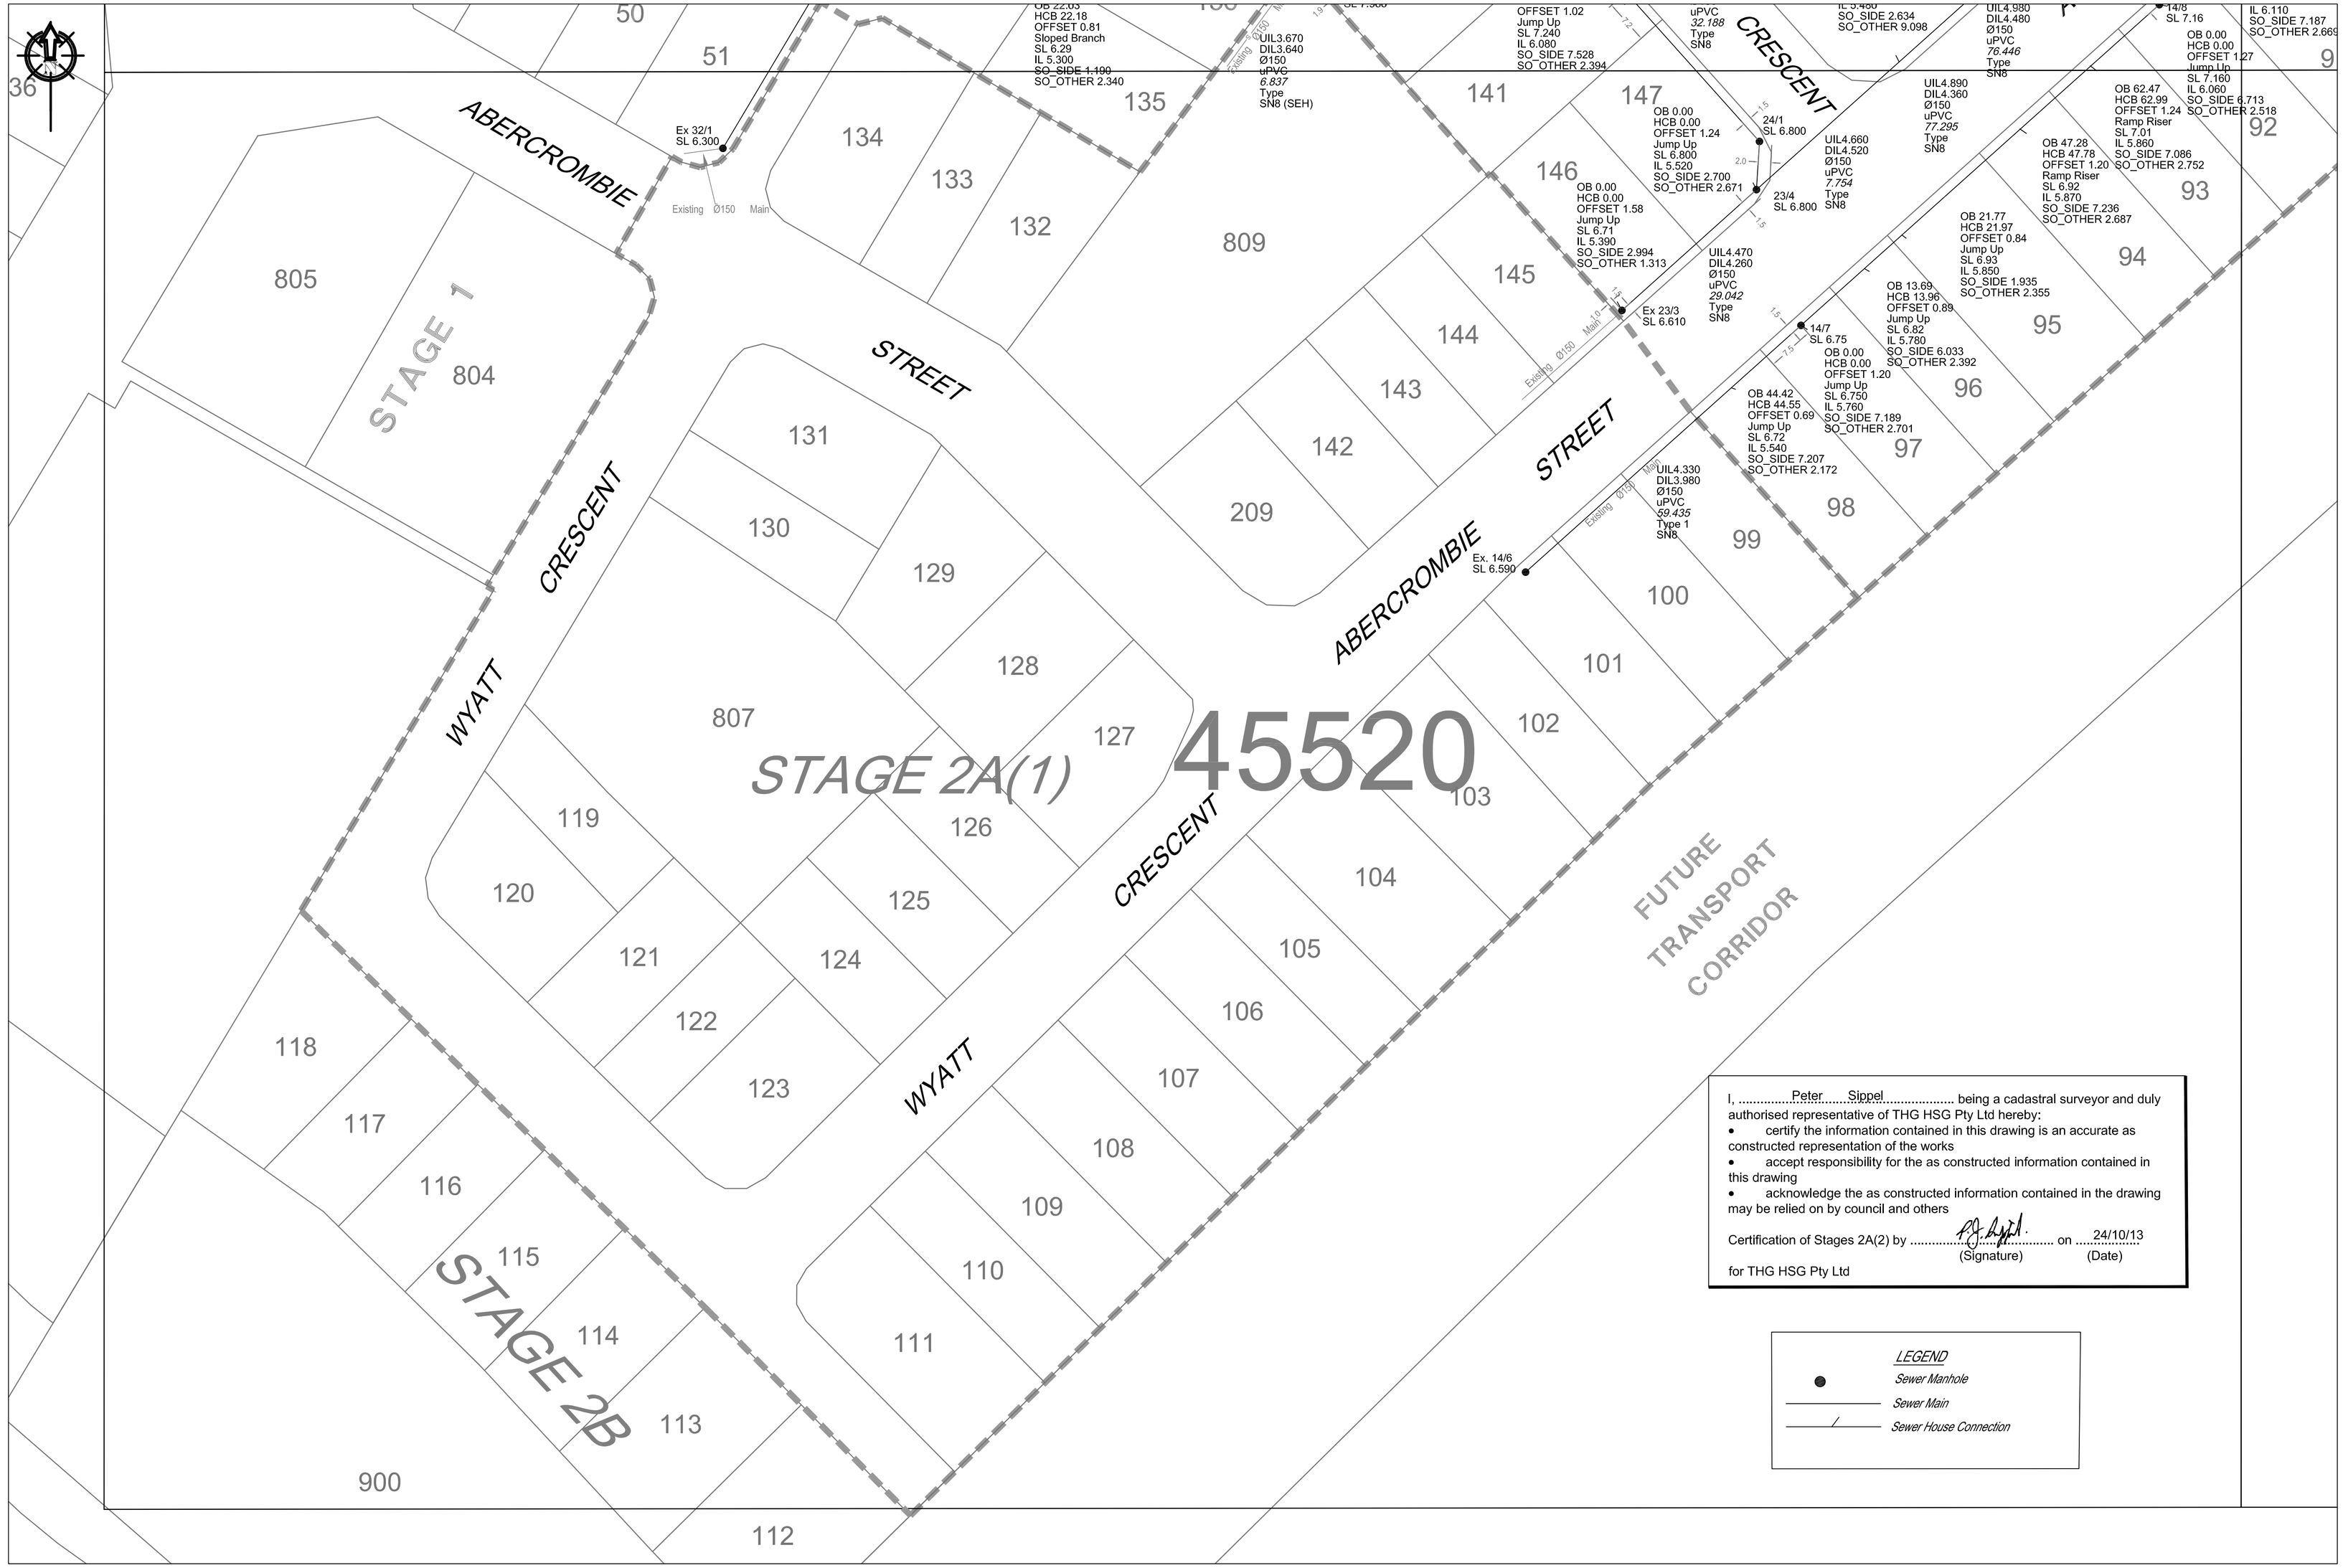

I, Peter Sippel being a cadastral surveyor and duly authorised representative of THG HSG Pty Ltd hereby:

- certify the information contained in this drawing is an accurate as constructed representation of the works
- accept responsibility for the as constructed information contained in this drawing
- acknowledge the as constructed information contained in the drawing may be relied on by council and others

Certification of Stages 2A(2) by ..... (Signature) on 24/10/13 (Date)

for THG HSG Pty Ltd

LEGEND

- *Sewer Manhole*
- *Sewer Main*
- *Sewer House Connection*

DRAWING REVISIONS		REFERENCE DRAWINGS		DESIGN FILE No.		DESIGNED	
REV.	REVISION DESCRIPTION	DRG. No.	DESCRIPTION	CONSTRUCT. No.		DATE	
A	Original			SURVEY FILE No.	216602_15	DRAWN	EJM
B	Add HC Lot 56, pipe 29/4 to 29/3,			FIELD BOOK		DATE	24/10/13
	pipe 29/3 to 29/2.			LOG BOOK		CHECKED	EJM
C	Add surface levels			LEVEL DATUM	AHD	DATE	24/10/13
				DATUM	PM38847		

THIS WORK WAS PREPARED BY:
THG HSG PTY LTD

SCALE 1:500 | ORIGINAL SIZE A1

MORETON BAY REGIONAL COUNCIL
CABOOLTURE DISTRICT OFFICE
2 HASKING STREET CABOOLTURE QLD 4510
PO BOX 159 CABOOLTURE QLD 4510
Telephone: (07) 5433 0100
Fax: (07) 5433 4000

STAGE 2A(2) CAPESTONE AS CONSTRUCTED SEWER RETICULATION

MBRC SUBDIVISION REFERENCE	
2007/11361/NEGDEC/1	
No. 3 OF 3 PLANS	
ASCON GRID NUMBER	REV.
45220	C