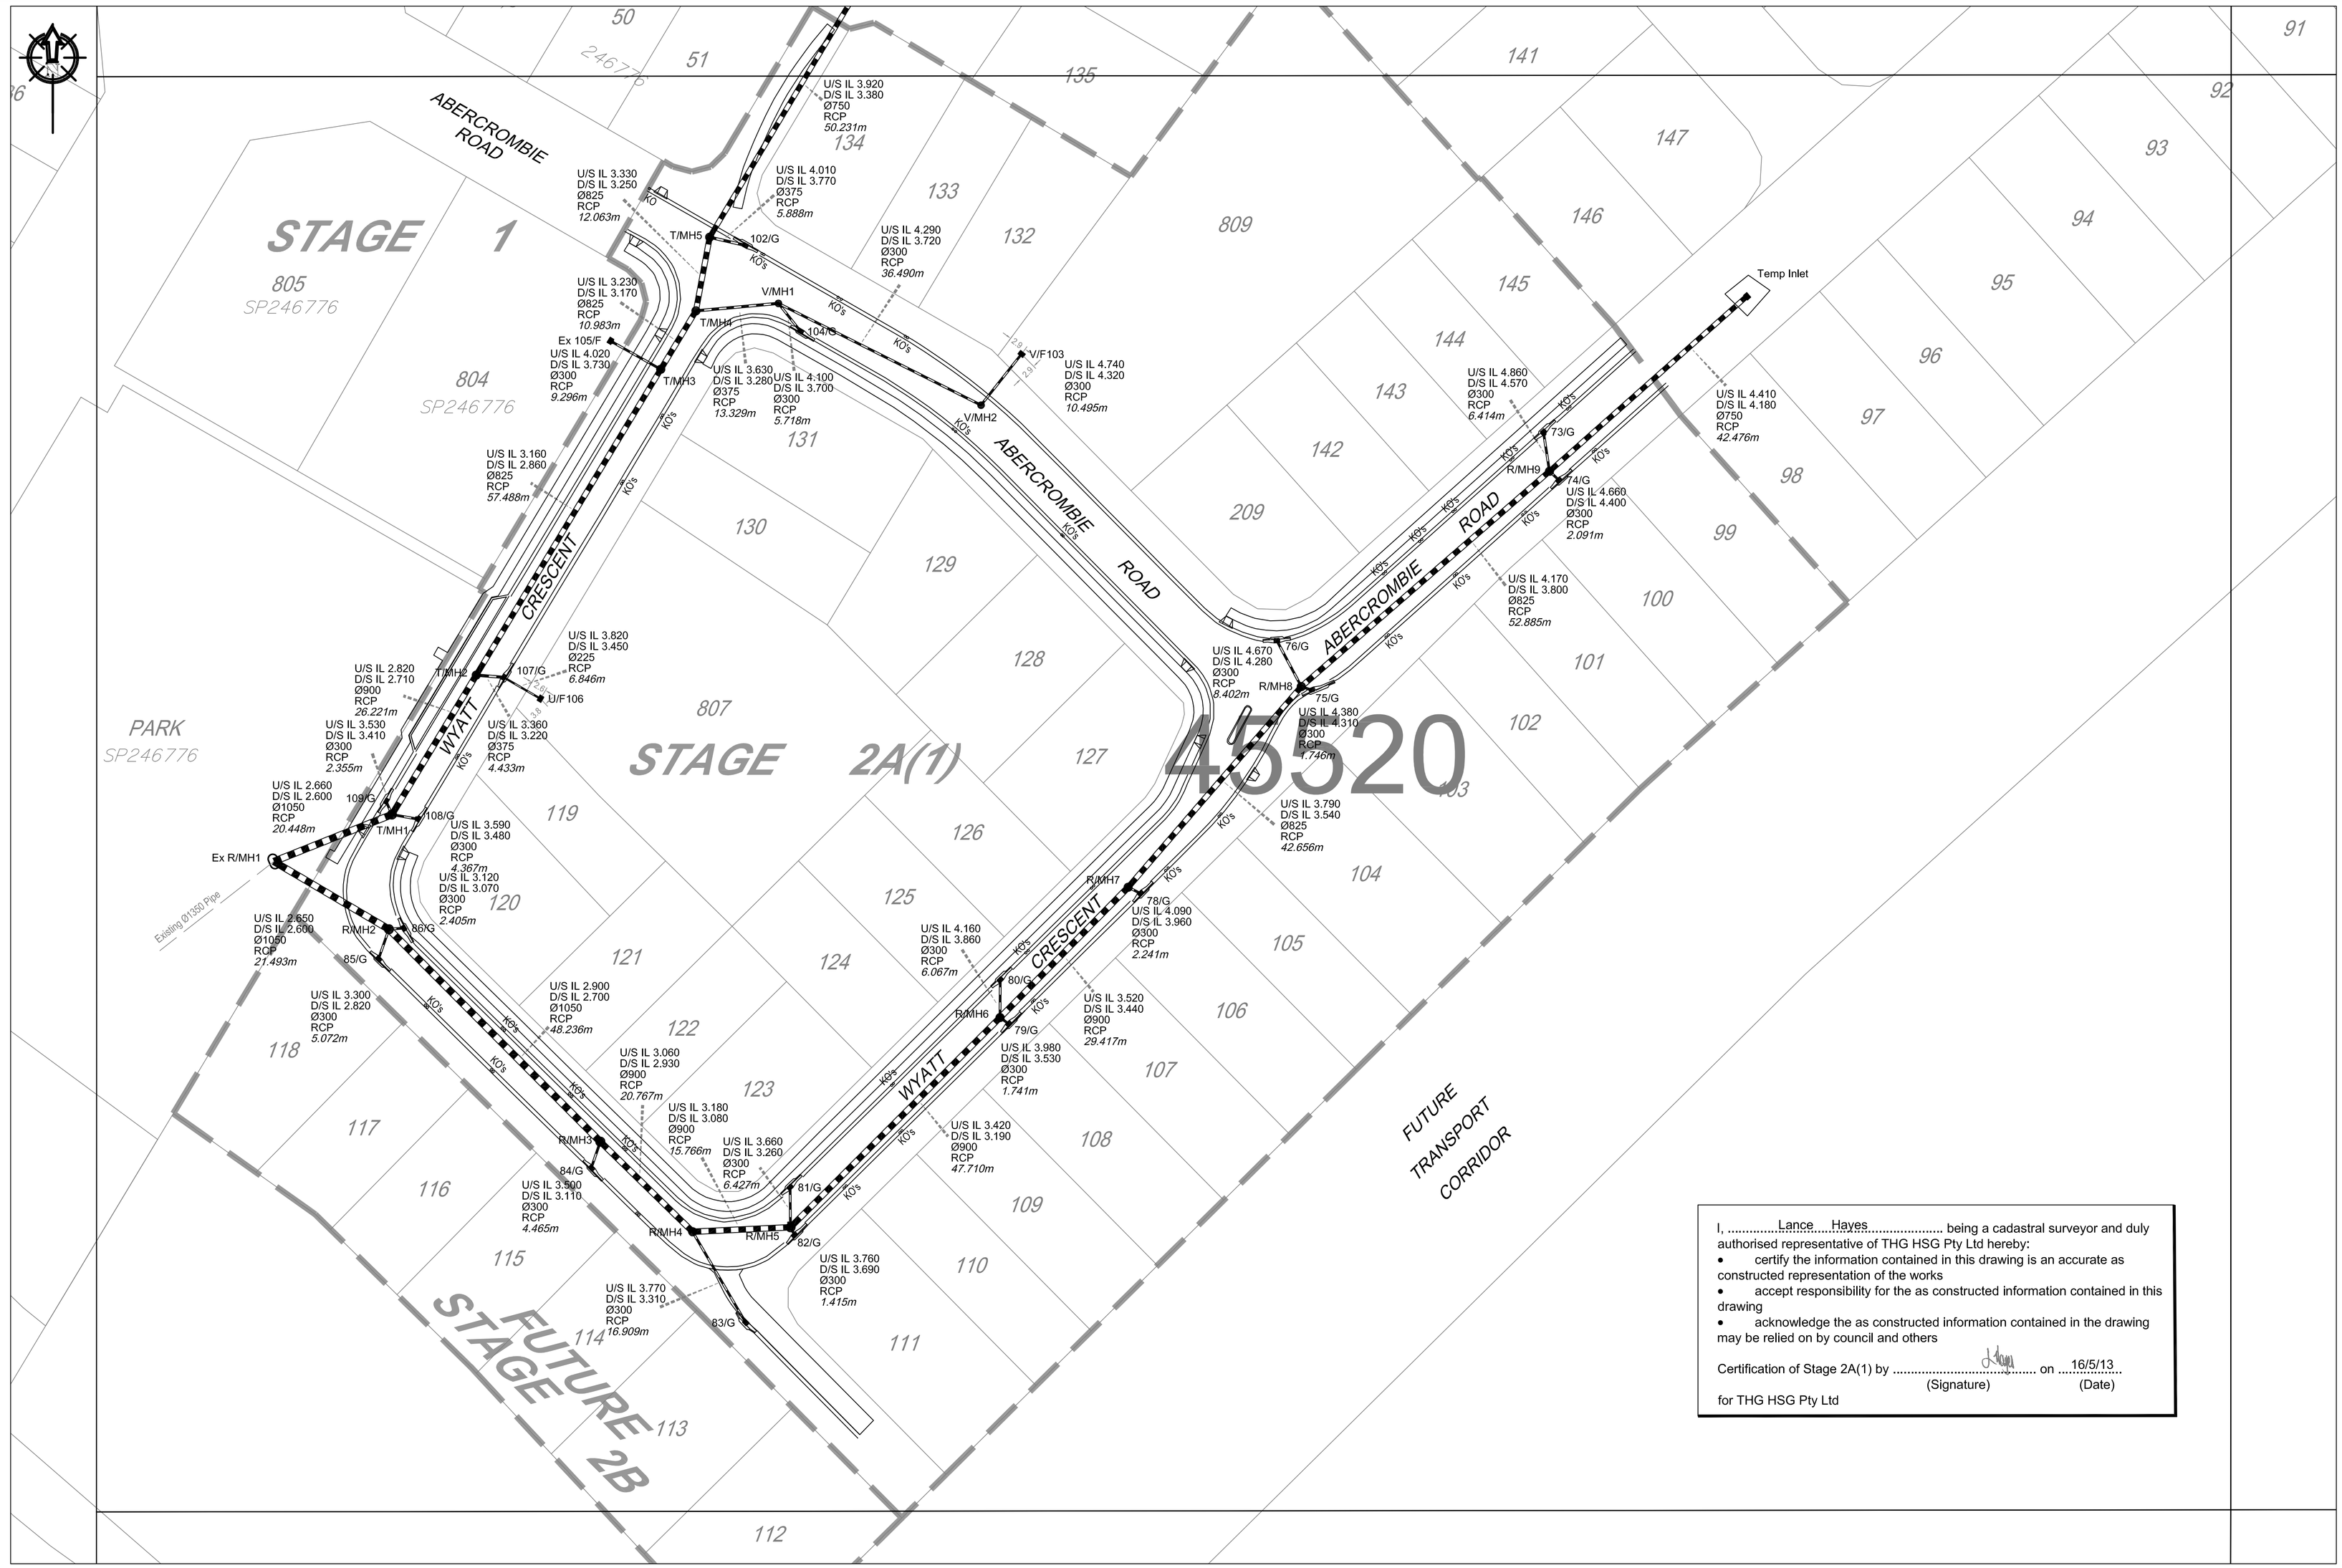

I, ... Lance Hayes ..... being a cadastral surveyor and duly authorised representative of THG HSG Pty Ltd hereby:

- certify the information contained in this drawing is an accurate as constructed representation of the works
- accept responsibility for the as constructed information contained in this drawing
- acknowledge the as constructed information contained in the drawing may be relied on by council and others

Certification of Stage 2A(1) by ..... on 16/5/13
(Signature) (Date)
for THG HSG Pty Ltd

DRAWING REVISIONS		REFERENCE DRAWINGS	
REV.	REVISION DESCRIPTION	DRG. No.	DESCRIPTION
A	Original		

DESIGN FILE No.		DESIGNED	
CONSTRUCT. No.		DATE	
SURVEY FILE No.	216602_7	DRAWN	EJM
FIELD BOOK		DATE	16/5/13
LOG BOOK		CHECKED	EJM
LEVEL DATUM	AHD	DATE	16/5/13
DATUM	PM38847		

THIS WORK WAS PREPARED BY:
THG HSG PTY LTD

SCALE 1:500 | ORIGINAL SIZE A1

Moreton Bay Regional Council

MORETON BAY REGIONAL COUNCIL
CABOOLTURE DISTRICT OFFICE
2 HASKING STREET CABOOLTURE QLD 4510
PO BOX 159 CABOOLTURE QLD 4510
Telephone: (07) 5433 0100
Fax: (07) 5433 4000

STAGE 2A(1) CAPESTONE AS CONSTRUCTED ROADS AND DRAINAGE

MBRC SUBDIVISION REFERENCE	
2007/11361/NEGDEC/1	
No. 2 OF 2 PLANS	
ASCON GRID NUMBER	REV.
45520	A