LEGEND

- FINISHED SURFACE CONTOURS (0.25m INTERVALS)
- EXISTING SEWERAGE RETICULATION
- SMH ID 5242742 — EXISTING SEWER STRUCTURE NUMBER
- EXISTING MAINTENANCE HOLE
- EXISTING MAINTENANCE SHAFT
- EXISTING LAYBACK KERB & CHANNEL
- EXISTING UPRIGHT KERB & CHANNEL
- EXISTING BARRIER KERB ONLY
- EXISTING EDGE (FLUSH) KERB
- EXISTING SPOON DRAIN
- EXISTING CONCRETE PATHWAY
- INDICATIVE DRIVEWAY LOCATIONS
- EXISTING RETAINING WALL
- EXISTING STORMWATER DRAINAGE
- EXISTING WATER RETICULATION
- EXISTING WATER CONDUITS
- EXISTING ELECTRICAL RETICULATION
- EXISTING ELECTRICAL PILLAR TO BE RELOCATED/REMOVED
- RELOCATED ELECTRICAL PILLAR

NOTE:-
ALL WORKS ON EXISTING SEWER MAINS TO BE CARRIED OUT BY UNITYWATER AT THE DEVELOPER'S EXPENSE.

NOTE:-
ALL WORKS AROUND EXISTING WATER AND SEWER INFRASTRUCTURE SHALL COMPLY WITH THE REQUIREMENTS OF THE QUEENSLAND WORKPLACE HEALTH AND SAFETY ACT 1995.
CONTACT THE DIVISION OF WORKPLACE HEALTH AND SAFETY FOR INFORMATION.
TELEPHONE - 1300 369915

NOTES:-
FOR THE REMOVAL & RELOCATION OF ELECTRICAL PILLARS, REFER TO JPR DRAWINGS FOR DETAIL.

Private Works No: PWS 20-094

As Constructed ☑

Name: M. SHEARER

Date Constructed: 28·11·19

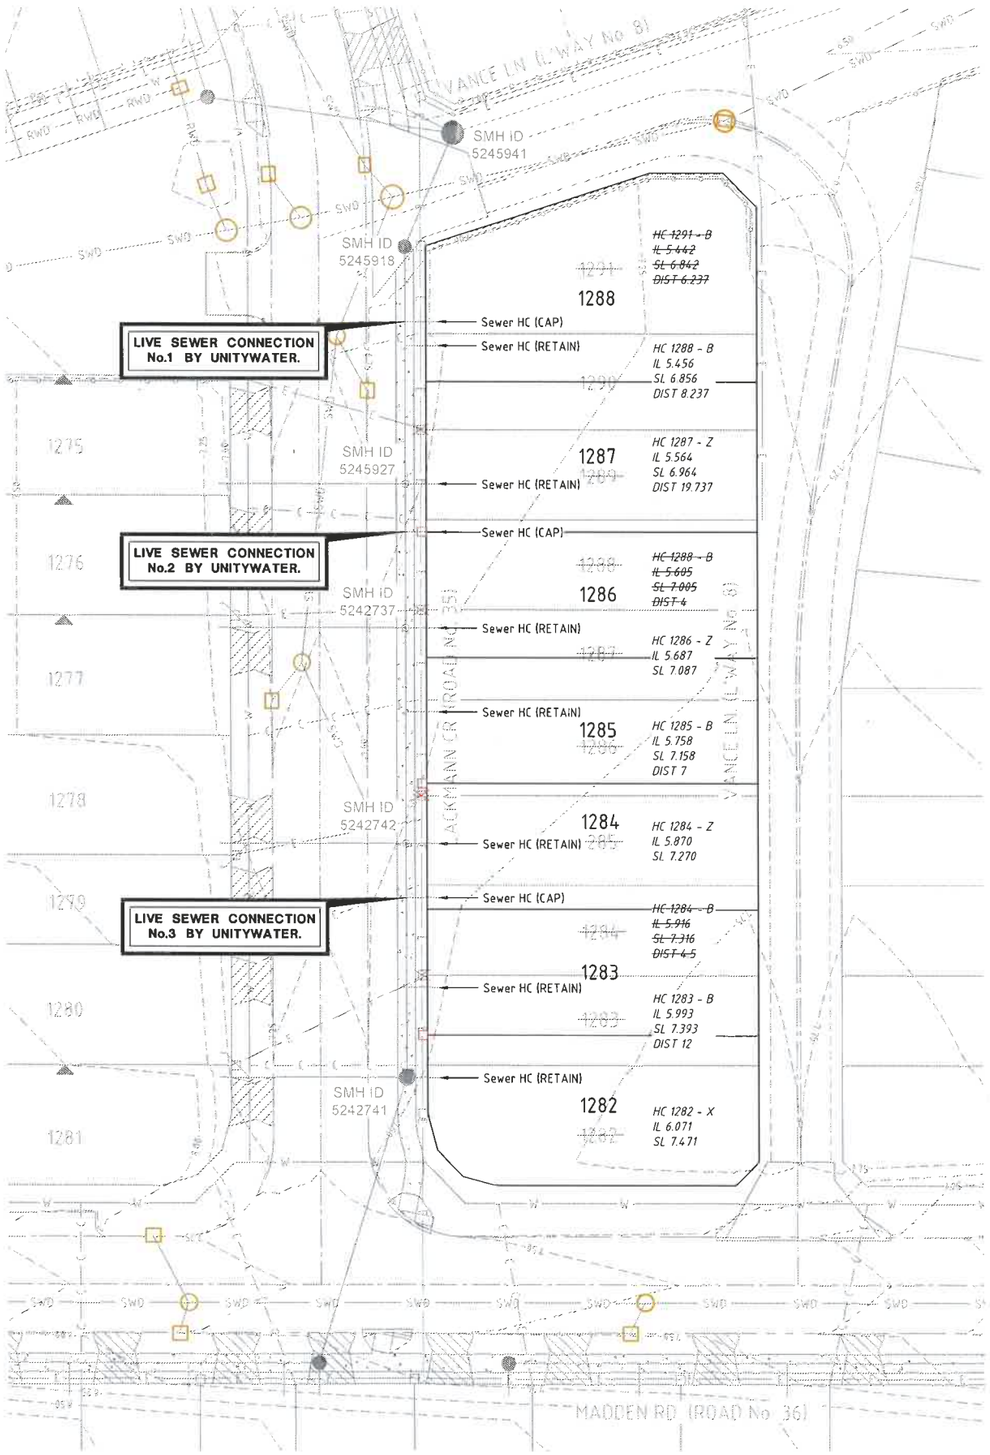

DIAL BEFORE YOU DIG www.1100.com.au

NOTE: LOCATION & LEVELS OF ALL EXISTING SERVICES AND PROPOSED STORMWATER OUTLETS TO BE CONFIRMED ON SITE BY CONTRACTOR PRIOR TO THE COMMENCEMENT OF CONSTRUCTION. IT IS THE CONTRACTOR'S RESPONSIBILITY TO PERFORM A DIAL BEFORE YOU DIG SEARCH PRIOR TO COMMENCEMENT OF WORKS. ANY POTENTIAL CONFLICT OF EXISTING SERVICES OR STORMWATER OUTLETS SHALL BE REPORTED TO THE SUPERINTENDENT.

Unitywater
APPROVED WITH CONDITIONS
App No: 2019014441S1
Development: 1-9 Vance Lane MANGO HILL
Approval Type: Connection Approval
Approval Date: 14/11/2019
Signed

SCALE 1:500 (A1) 1:1000 (A3)
DO NOT SCALE USE ONLY THE DIMENSIONS PROVIDED

No.	Amendments	Drawn	Design	Design Chk	Appd	Date
B	AMENDED ACCORDING TO RFI	NP	NP	DH	DH	11.11.19
A	ORIGINAL ISSUE	NP	NP	DH	DH	31.10.19

Registered Engineer 11/11/2019 5694
Date Register
ENGINEERING CERTIFICATION

urbex

Empower ENGINEERS & PROJECT MANAGERS ABN 23 010 743 692

Client: URBEX PTY LTD
Project: CAPESTONE STAGE 12 - LOTS 1282-1288
Title: SEWER RETICULATION PLAN

Datum: AHD PSM 38847 RL 10.649 (MGA) COORD
Project No. B0023

This drawing cannot be copied or reproduced in any form or used for any purpose other than that originally intended without the written permission of Empower Engineers and Project Managers ©COPYRIGHT 2019

Plot Date: 11/11/2019 4:02:41 PM User: NICHOLAS PRINS File Name: C:\Synergy\data\125synergy\B0023B_SSW_CIVIL_DRGS\v2 CURRENT\DPw1b_INTG-718002BE-SEW

DocuSign Envelope ID: 40659D39-3ABE-4DDE-9A3D-DA5