ENGINEER'S CERTIFICATION

" I, ...

being a Consulting Engineer and duly authorised representative of: –

.....

hereby:–

- # certify the information contained in this drawing is an accurate "as constructed" representation of the works;
- # accept responsibility for the "as constructed" information contained in this drawing; and
- # acknowledge the "as constructed" information contained in the drawing may be relied on by the Pine Rivers Shire Council and others.

Certification for Stage 1 & 3 by ..... on .....

For: BMD CONSULTING ENGINEERS Pty. Ltd.

SURVEYOR'S CERTIFICATION

" I, Brian Collins

being a Registered Surveying Associate and duly authorised representative of: –

BMD CONSTRUCTIONS PTY. LTD.

hereby:–

- # certify the information contained in this drawing is an accurate "as constructed" representation of the works;
- # accept responsibility for the "as constructed" information contained in this drawing; and
- # acknowledge the "as constructed" information contained in the drawing may be relied on by the Pine Rivers Shire Council and others.

Certification for Stage 1 & 3 by ..... on May 2012

For: Brian Collins Eng.Surv.

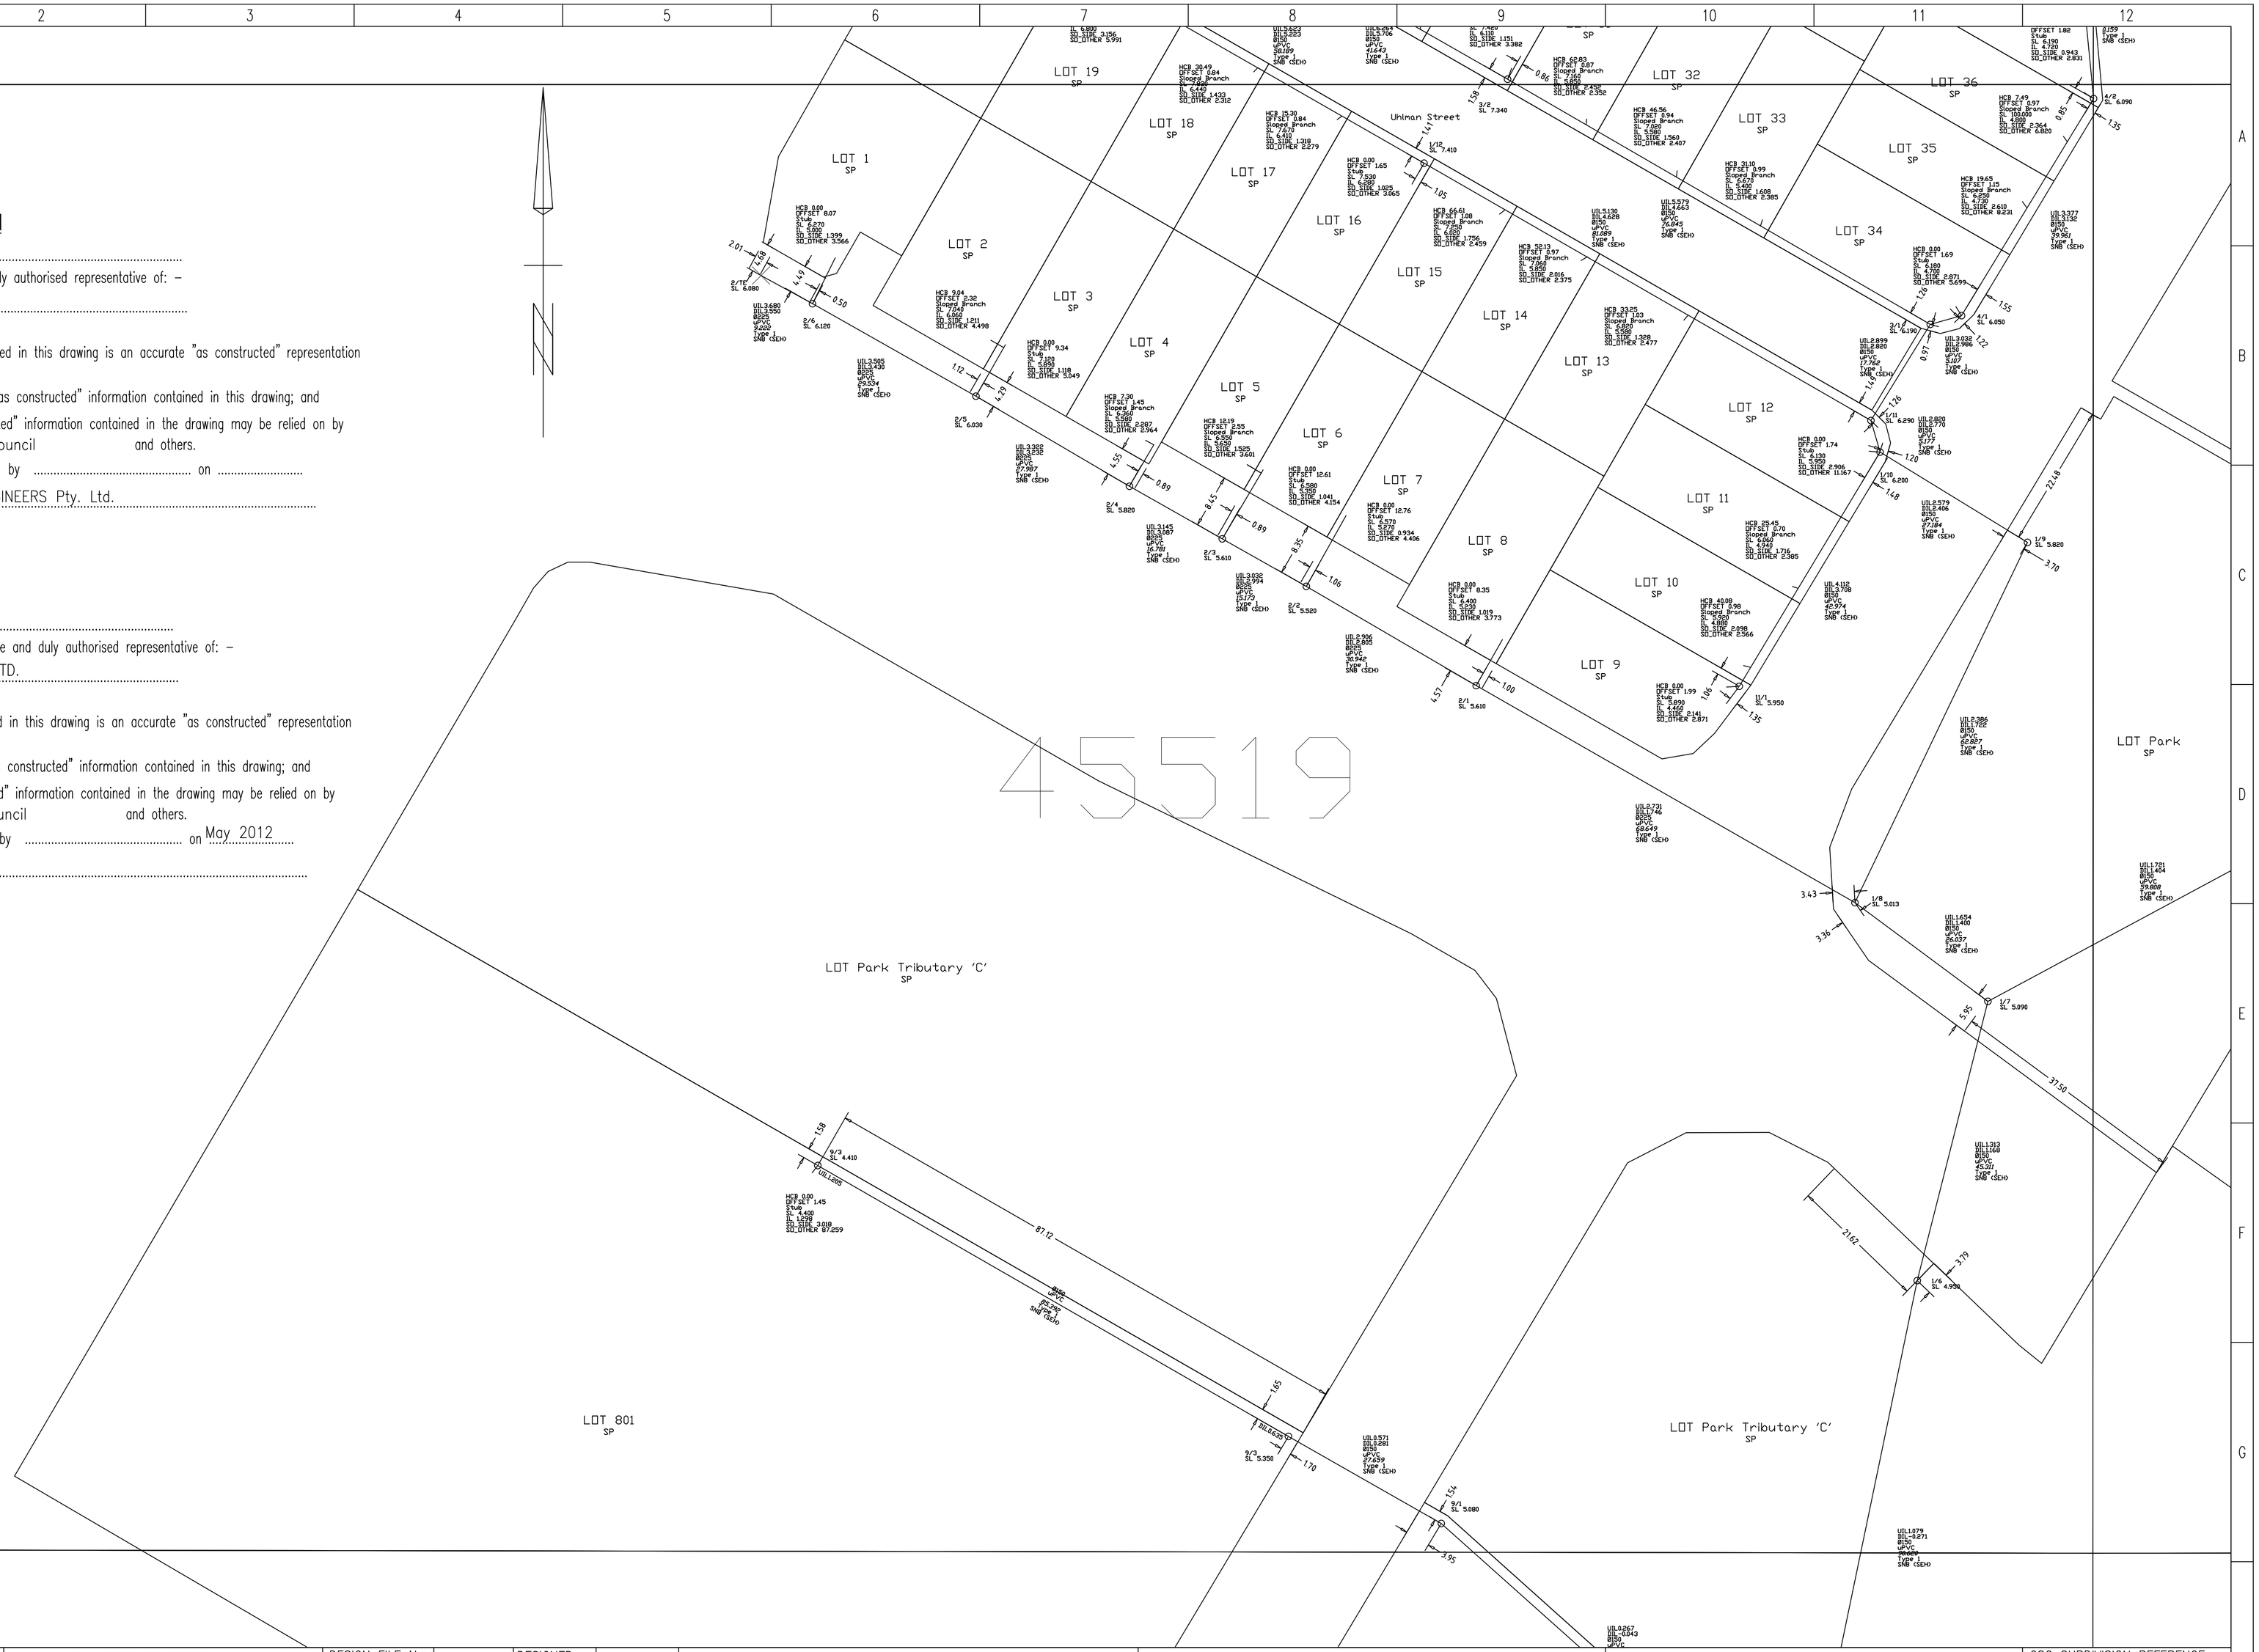

DRAWING REVISIONS		REFERENCE DRAWINGS		DESIGN FILE No.		DESIGNED	
REV.	REVISION DESCRIPTION	DRG. No.	DESCRIPTION	CONSTRUCT. No.		DATE	
A	PRELIMINARY AS CONSTRUCTED			SURVEY FILE No.		DRAWN	
				FIELD BOOK		DATE	
				LOG BOOK		CHECKED	
				LEVEL DATUM		DATE	
				DATUM			

THIS WORK WAS PREPARED BY:
SUNSTATE ENGINEERING SURVEYS
UNIT 2/44 Storie St, Clontarf. Qld. 4019
Telephone: (07) 3283 7611
Fax: (07) 3283 7633

SCALE 1:500 ORIGINAL SIZE A1

Moreton Bay Regional Council

MORETON BAY REGIONAL COUNCIL
CABOOLTURE DISTRICT OFFICE
2 HASKING STREET CABOOLTURE QLD 4510
PO BOX 159 CABOOLTURE QLD 4510
Telephone: (07) 5433 0100
Fax: (07) 5433 4000

AS CONSTRUCTED SEWER CAPESTONE STAGES 1 & 3

CSC SUBDIVISION REFERENCE
DA 2055/10548
No. 3 OF 5 PLANS

ASCON GRID NUMBER	REV.
45519	A